


200900062582
 Filed for Record in
 HOLMES COUNTY, OH
 ANITA HALL
 08-06-2009 At 01:33 pm.
 SMALL PLAT 40.00
 OR Book 19 Page 1556 - 1556
 ORV 212 page 2156

RETRACEMENT SURVEY OF O.R. 171-1713
 VILLAGE OF MILLERSBURG
 HARDY TOWNSHIP
 S.W. QTR. SECTION 11
 T-9 N; R-7 W
 HOLMES COUNTY, OHIO


SURVEYED FOR: DAVE KAUFMAN REALTY

- REFERENCES
- DEED VOL. 151 PAGE 356
 - DEED VOL. 202 PAGE 220
 - O.R. VOL. 14 PAGE 501
 - O.R. VOL. 137 PAGE 247
 - O.R. VOL. 170 PAGE 2445
 - O.R. VOL. 171 PAGE 1713
 - O.R. VOL. 187 PAGE 371
 - PLAT VOL. 8 PAGE 209
 - PLAT VOL. 16 PAGE 822
 - PLAT VOL. 19 PAGE 646
 - BEARINGS FROM PLAT VOL. 19 PAGE 646

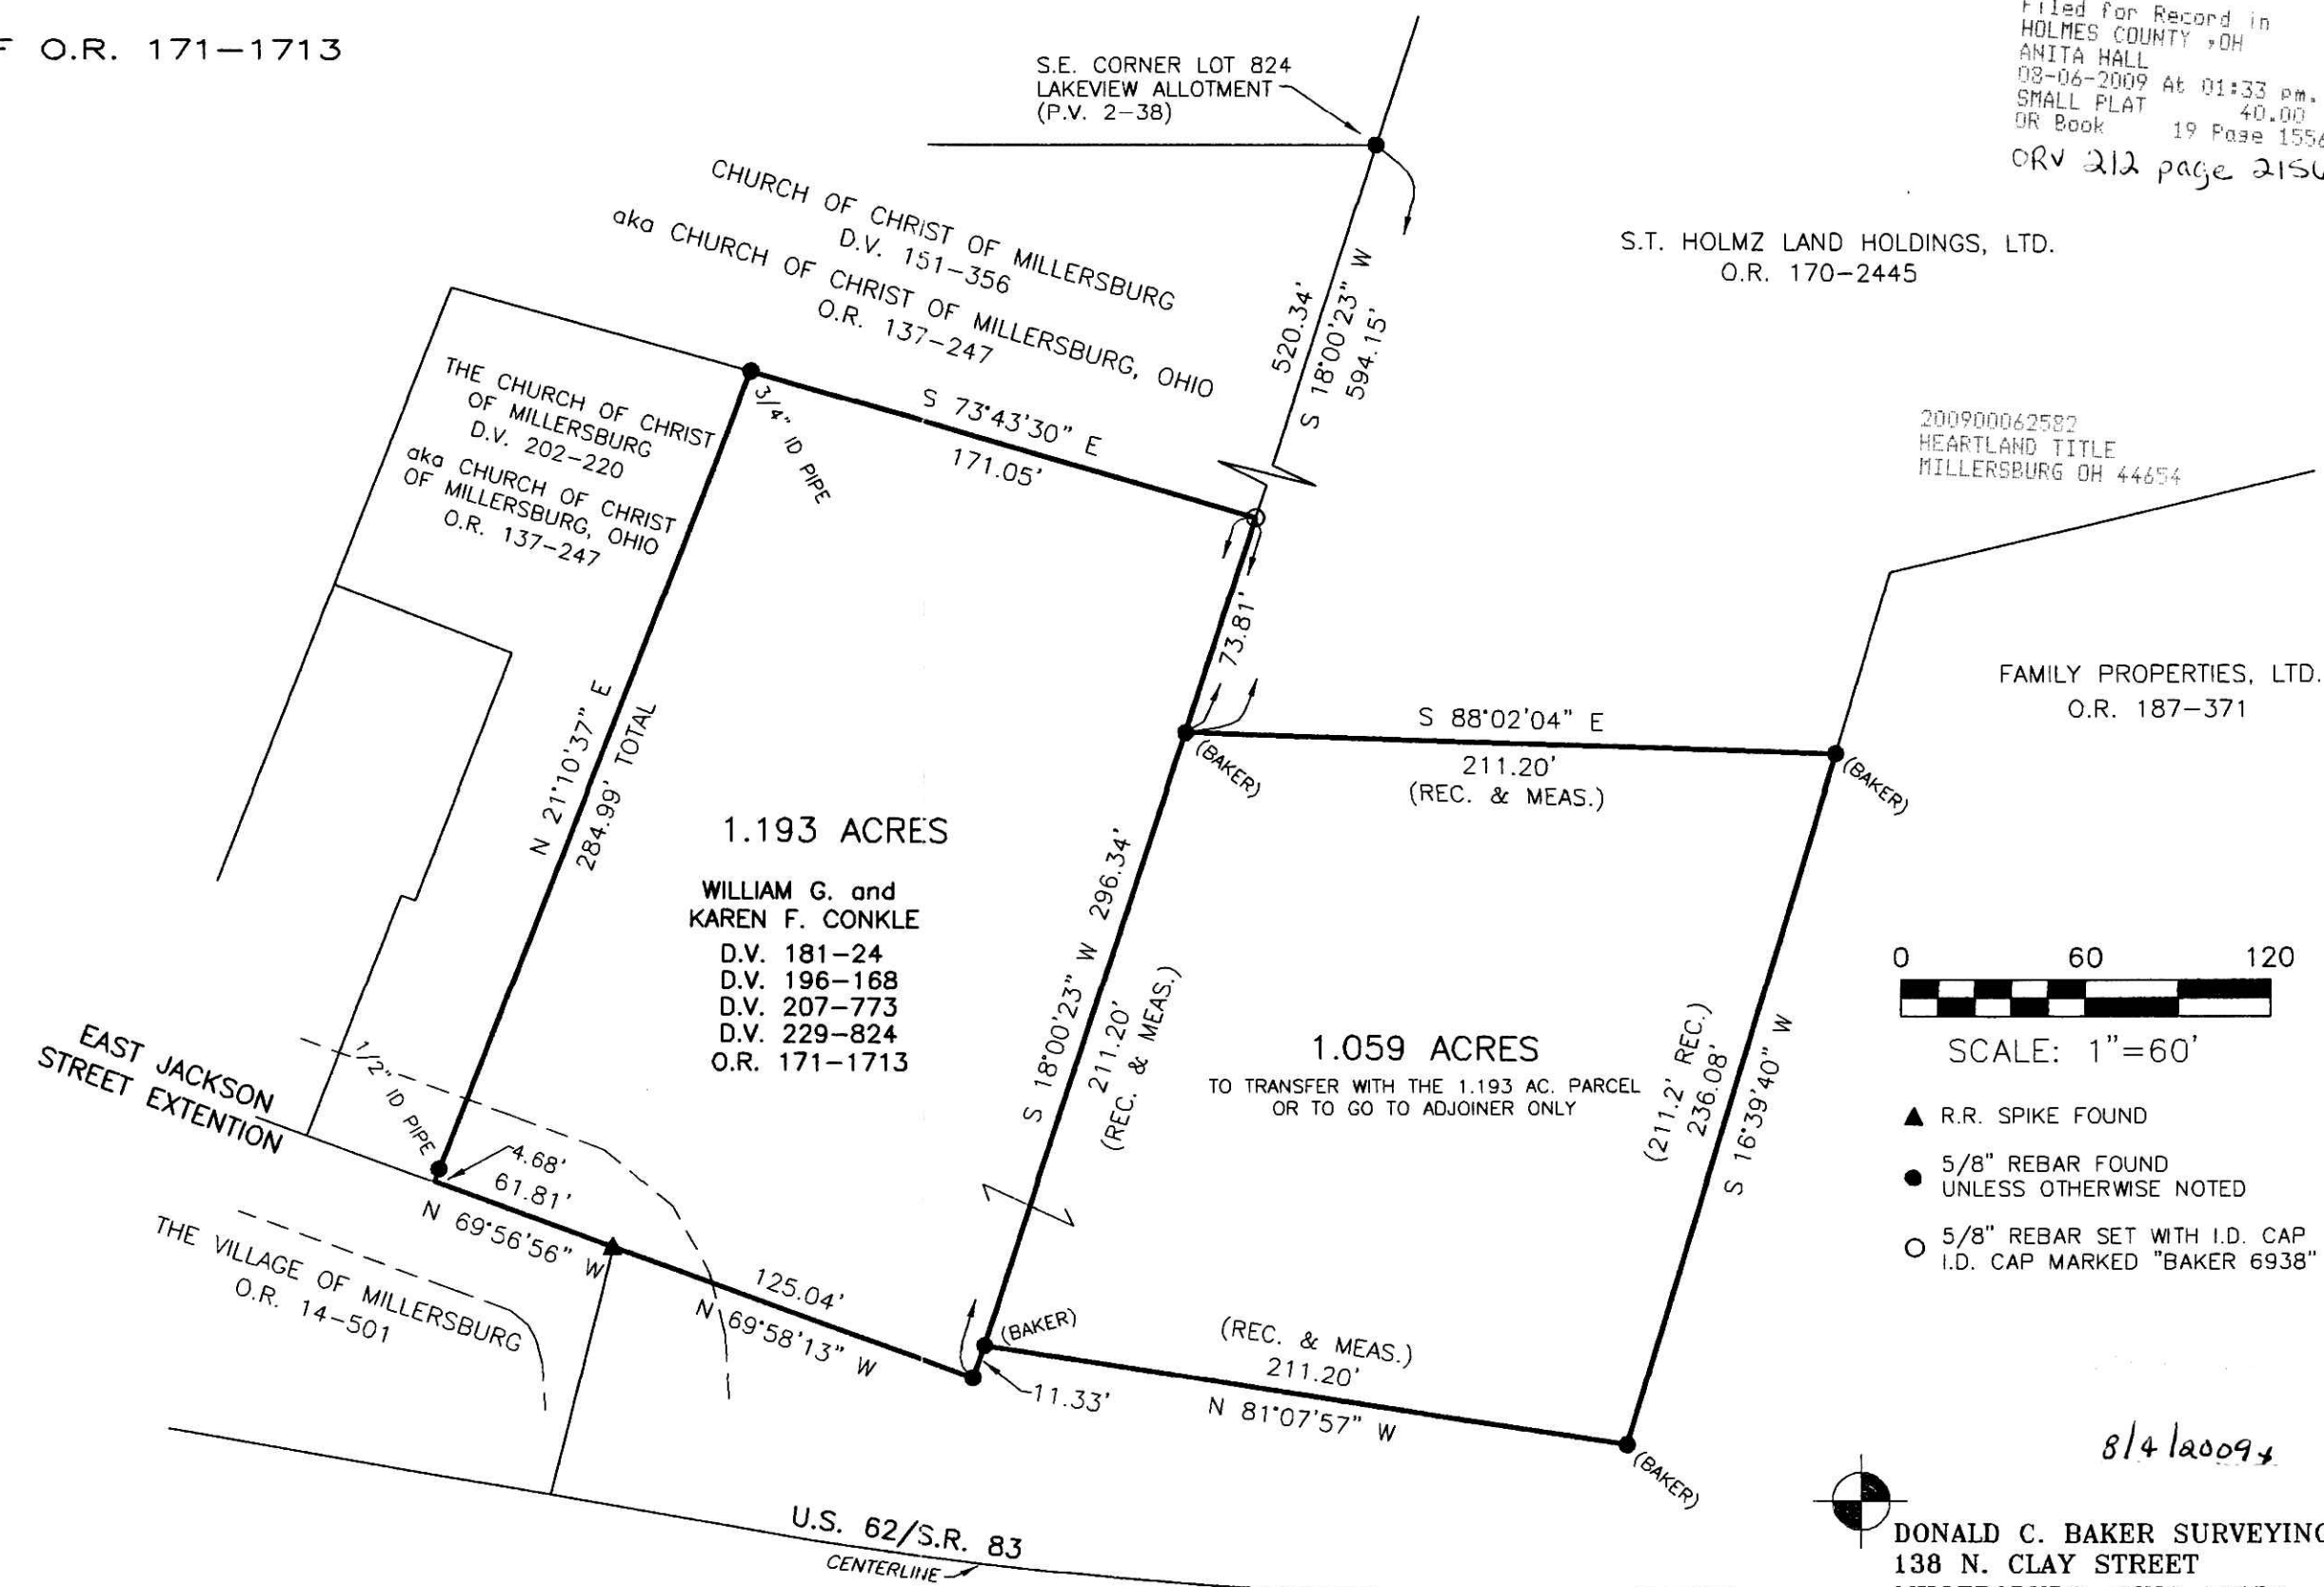

I CERTIFY THIS SURVEY TO BE CORRECT TO THE BEST OF MY KNOWLEDGE.

Jamie D. Darr
 JAMIE D. DARR P.S. 7755
 DATE: JULY 16, 2009
 JDD/ACB
 FILE NAME: WORK3\S-332-09\ERZ

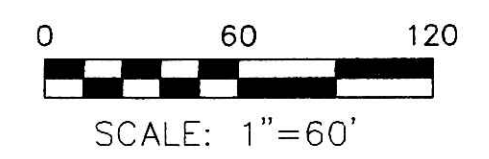

- ▲ R.R. SPIKE FOUND
- 5/8" REBAR FOUND UNLESS OTHERWISE NOTED
- 5/8" REBAR SET WITH I.D. CAP I.D. CAP MARKED "BAKER 6938"

8/4/2009

DONALD C. BAKER SURVEYING
 138 N. CLAY STREET
 MILLERSBURG, OHIO 44654
 PH. 330-674-4788
 FAX 330-674-6027