


RETRACEMENT SURVEY OF O.R. 196-205  
 MECHANIC TOWNSHIP  
 N.W. QTR. SECTION 20  
 T-8 N; R-6 W  
 HOLMES COUNTY, OHIO

SURVEYED FOR: ANDREW J.C. YODER

REFERENCES

DEED VOL. 204 PAGE 752 PLAT VOL. 8 PAGE 376  
 DEED VOL. 225 PAGE 116 PLAT VOL. 10 PAGE 323  
 DEED VOL. 256 PAGE 968 PLAT VOL. 13 PAGE 173  
 PLAT VOL. 16 PAGE 469  
 O.R. VOL. 28 PAGE 540  
 O.R. VOL. 72 PAGE 886 BEARINGS FROM PLAT VOL. 16 PAGE 469  
 O.R. VOL. 92 PAGE 175  
 O.R. VOL. 196 PAGE 205

Instrument 200900064088 DR Book Page 19 1603

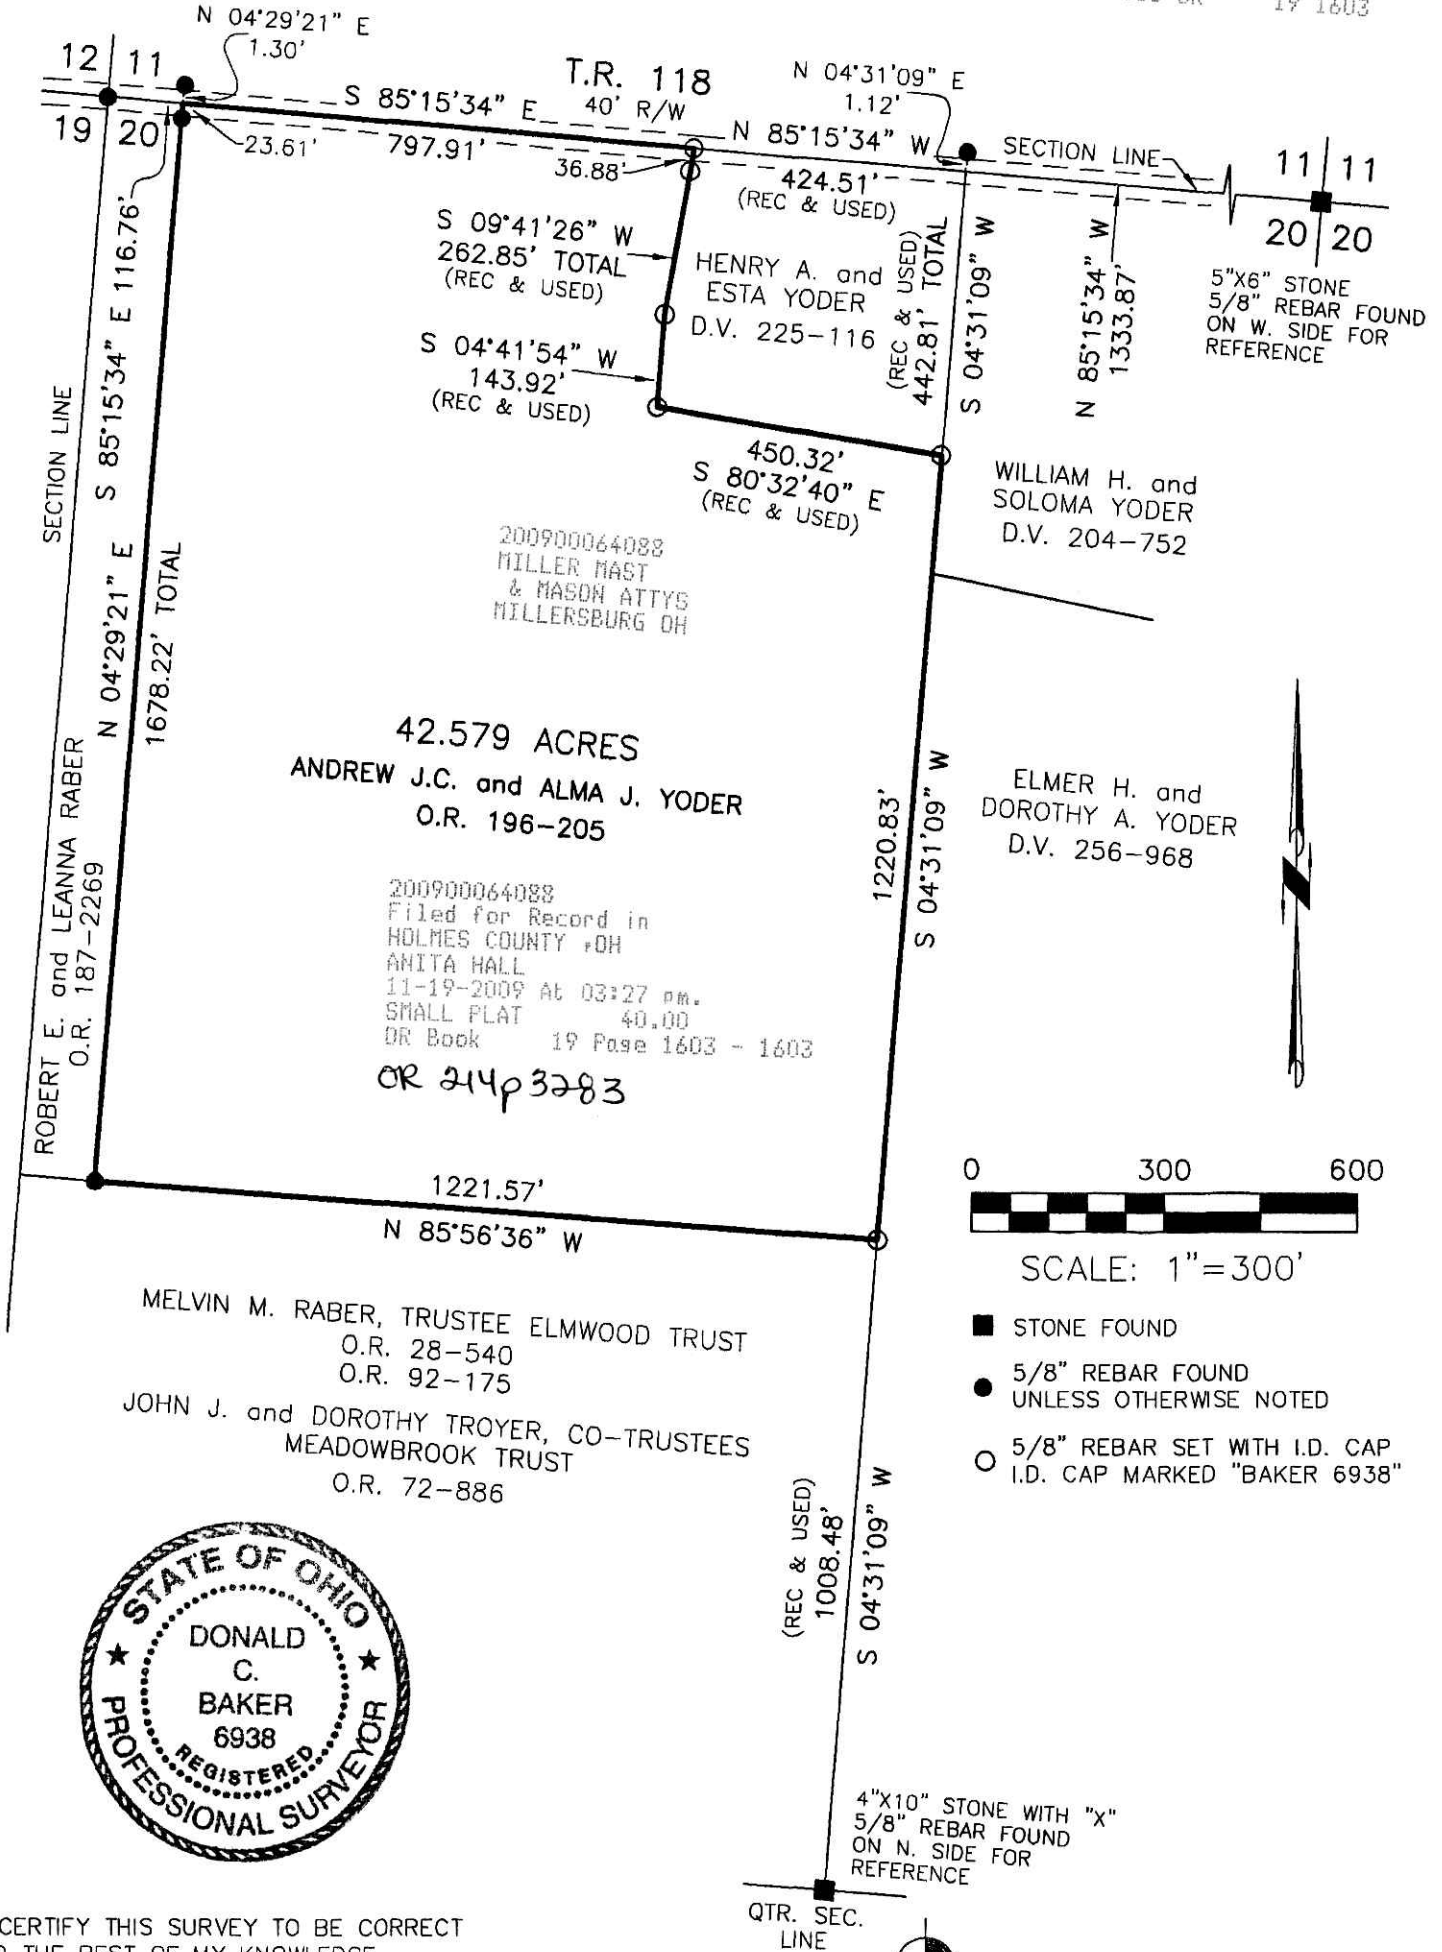

I CERTIFY THIS SURVEY TO BE CORRECT TO THE BEST OF MY KNOWLEDGE.

*Donald C. Baker*  
 DONALD C. BAKER P.S. 6938  
 DATE: OCT. 27, 2009  
 FDB\ALG-KES  
 FILE NAME: WORK3\S-486-09\ERZ

PLAT APPROVED

*11-5-09*

**DONALD C. BAKER SURVEYING**  
**138 N. CLAY STREET**  
**MILLERSBURG, OHIO 44654**  
**PH. 330-674-4788**  
**FAX 330-674-6027**