

RETRACEMENT SURVEY OF O.R. 193-654

BERLIN TOWNSHIP
1ST. QTR., LOT 21
T-9 N; R-6 W
HOLMES COUNTY, OHIO


Instrument 200900064421 OR Book Page 19 1612

200900064421
Filed for Record in
HOLMES COUNTY, OH
ANITA HALL
12-15-2009 At 02:09 PM.
SMALL PLAT 40.00
OR Book 19 Page 1612 - 1612

SURVEYED FOR: ALAN ZINCK


REFERENCES

- DEED VOL. 258 PAGE 579
- O.R. VOL. 78 PAGE 74
- O.R. VOL. 193 PAGE 654
- O.R. VOL. 195 PAGE 1013
- PLAT VOL. 2 PAGE 417
- PLAT VOL. 3 PAGE 99
- PLAT VOL. 7 PAGE 790
- PLAT VOL. 12 PAGE 61
- PLAT VOL. 19 PAGE 954
- BEARINGS FROM PLAT VOL. 19 PAGE 954

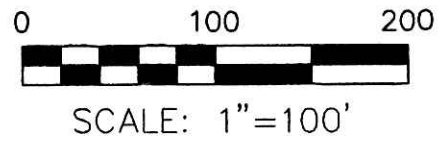

- 5/8" REBAR FOUND UNLESS OTHERWISE NOTED
- ⊘ DRILL HOLE SET IN CONCRETE
- 5/8" REBAR SET WITH I.D. CAP I.D. CAP MARKED "BAKER 6938"

200900064421
Filed for Record in
HOLMES COUNTY, OH
ANITA HALL
12-15-2009 At 02:09 PM.
SMALL PLAT 40.00
OR Book 19 Page 1612 - 1612
OR 215p 1599

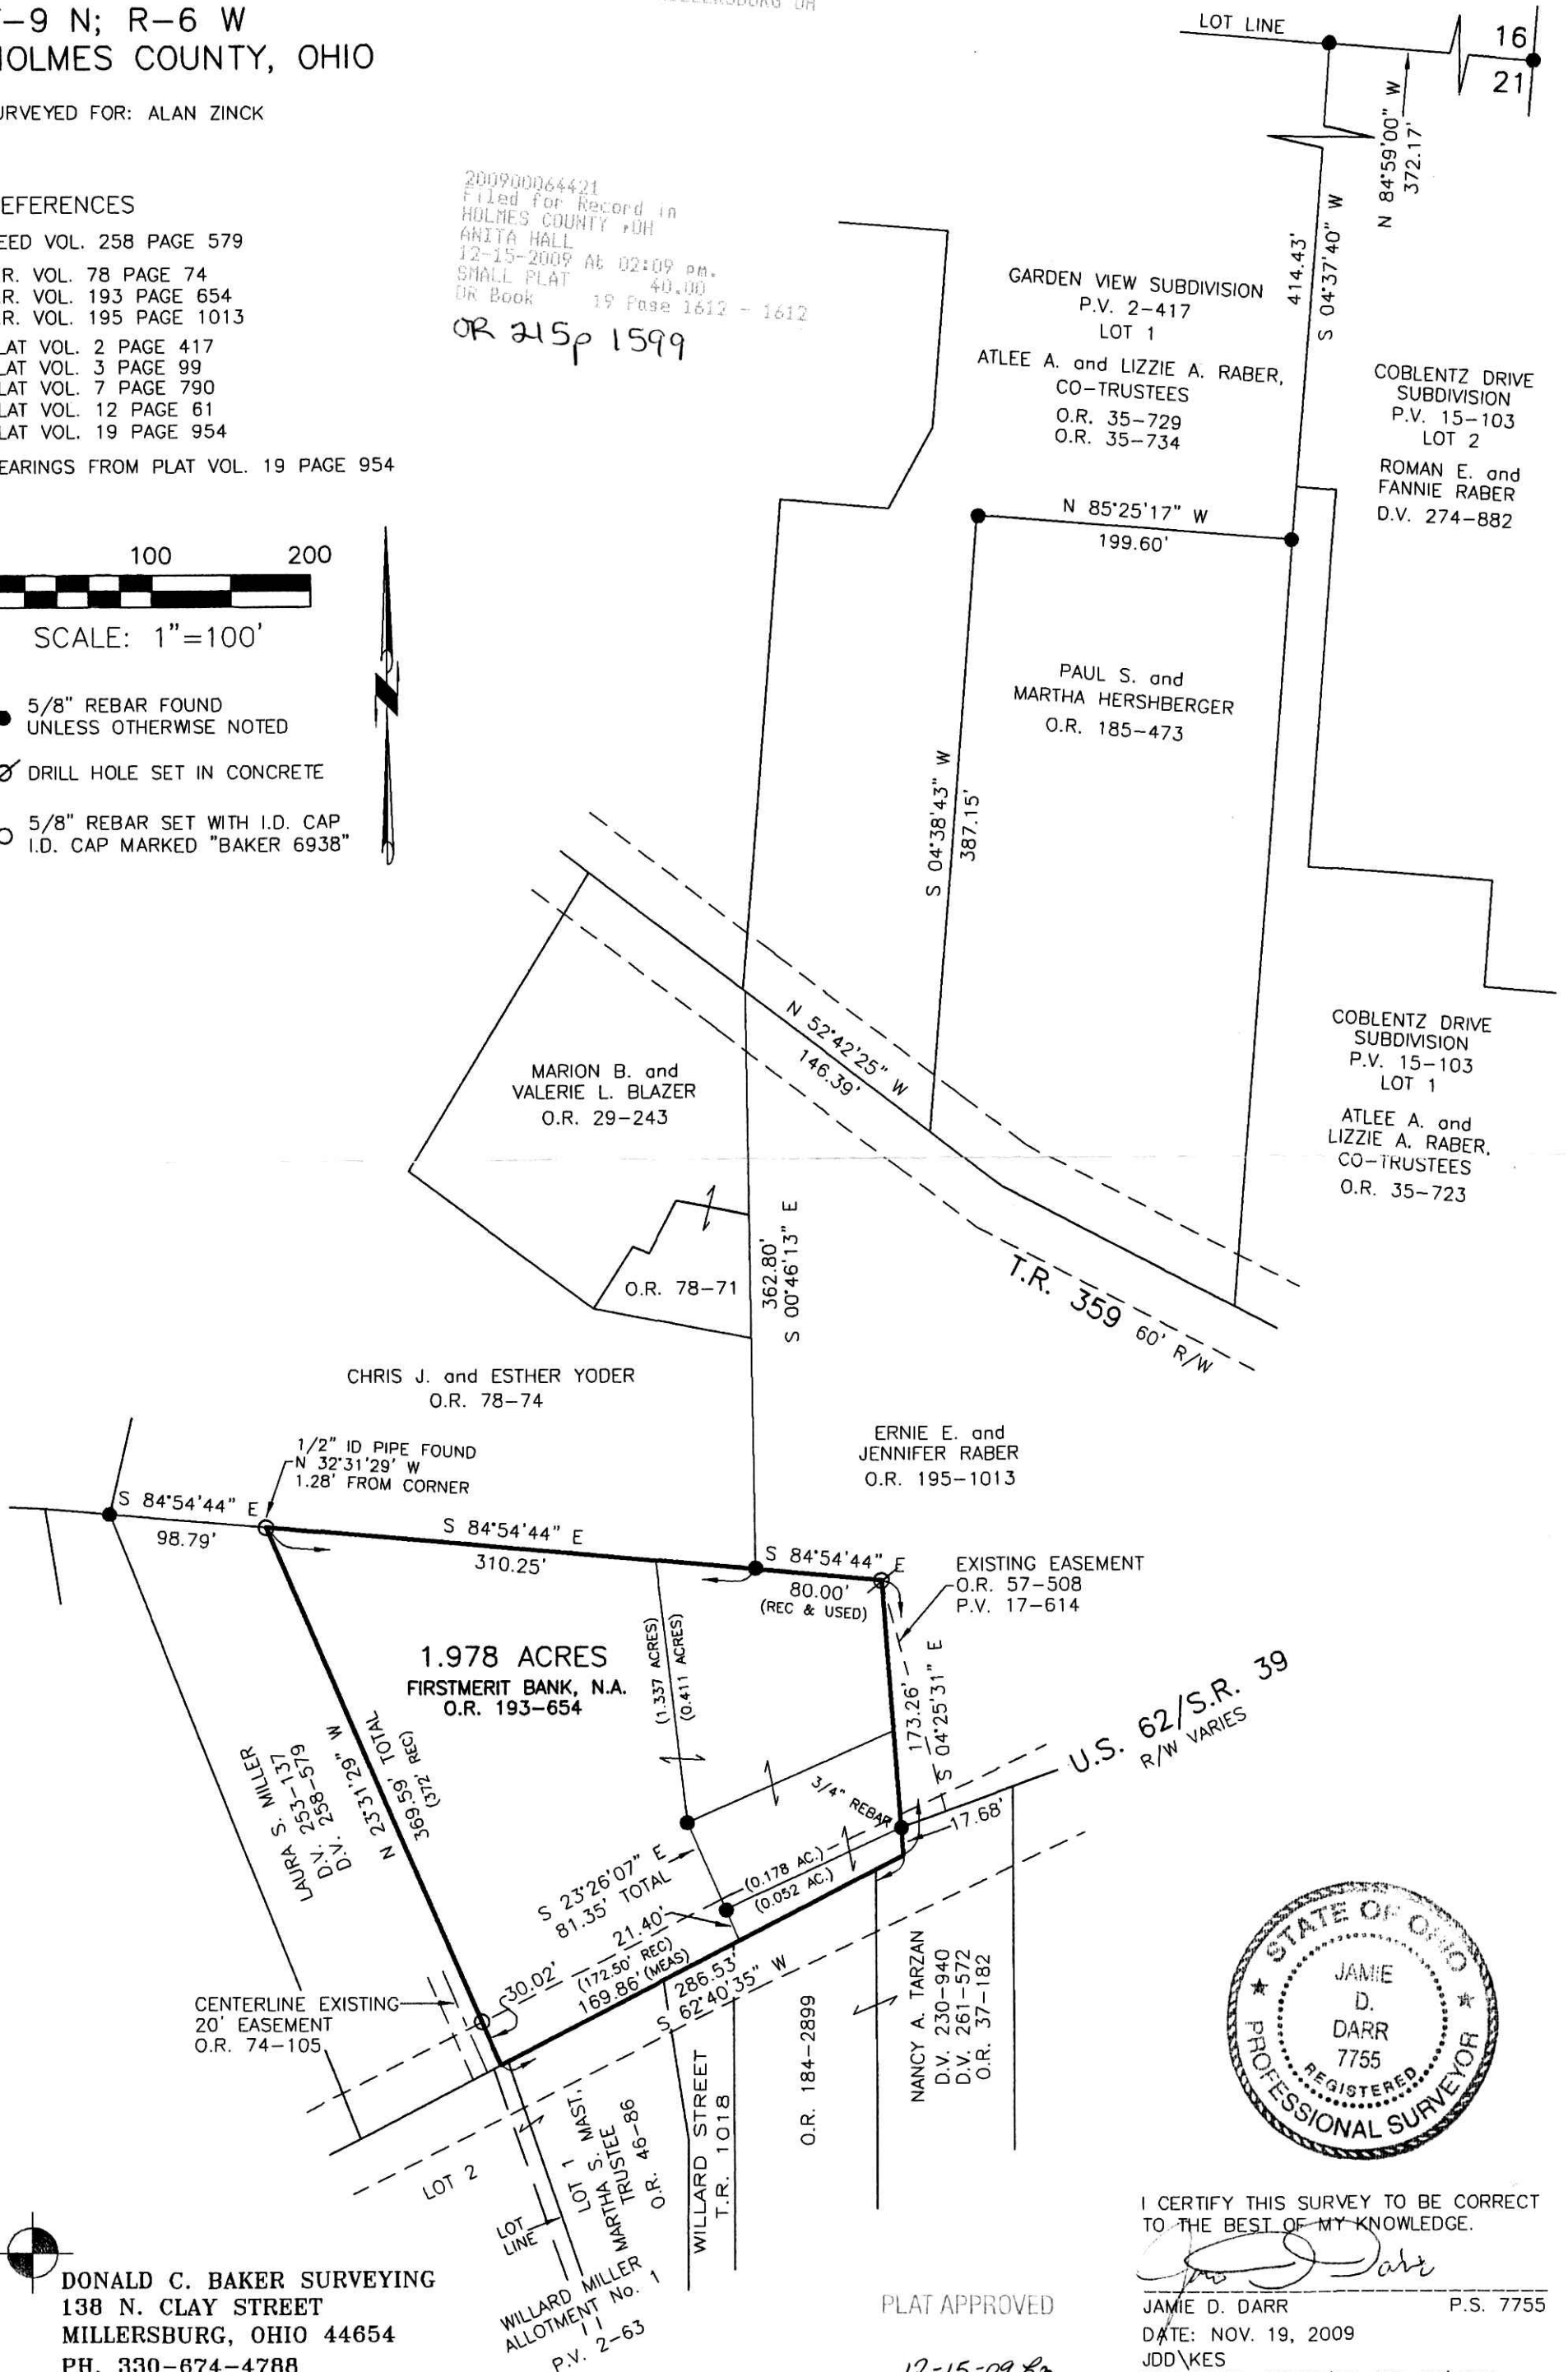

I CERTIFY THIS SURVEY TO BE CORRECT TO THE BEST OF MY KNOWLEDGE.

Jamie D. Darr
JAMIE D. DARR P.S. 7755
DATE: NOV. 19, 2009
JDD/KES
FILE NAME: WORK3\S-562-09\ERZ

PLAT APPROVED

12-15-09 *fy*

DONALD C. BAKER SURVEYING
138 N. CLAY STREET
MILLERSBURG, OHIO 44654
PH. 330-674-4788
FAX 330-674-6027

WILLARD MILLER ALLOTMENT No. 1
P.V. 2-63
MARTHA S. TRUSTEE
O.R. 49-86
WILLARD STREET T.R. 1018
O.R. 184-2899

U.S. 62/S.R. 39
R/W VARIES