


SALT CREEK TOWNSHIP  
 N.E. QTR. SECTION 6  
 T-14 N; R-12 W  
 HOLMES COUNTY, OHIO

SURVEYED FOR: ABE E. TROYER

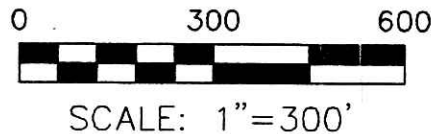


- STONE FOUND
- ▲ R.R. SPIKE FOUND
- 5/8" REBAR FOUND
- I.D. CAP MARKED "BAKER 6938" UNLESS OTHERWISE NOTED

Instrument 201000065012 OR Book Page 19 1644

201000065012  
 Filed for Record in  
 HOLMES COUNTY, OH  
 ANITA HALL  
 02-04-2010 At 11:56 am.  
 SHALL PLAT 40.00  
 OR Book 19 Page 1644 - 1644  
 ORV 216 PAGE 1310

201000065012  
 LODGE HOSTETLER STUTZMAN  
 2171 EAGLE PASS  
 WOOSTER OH 44691

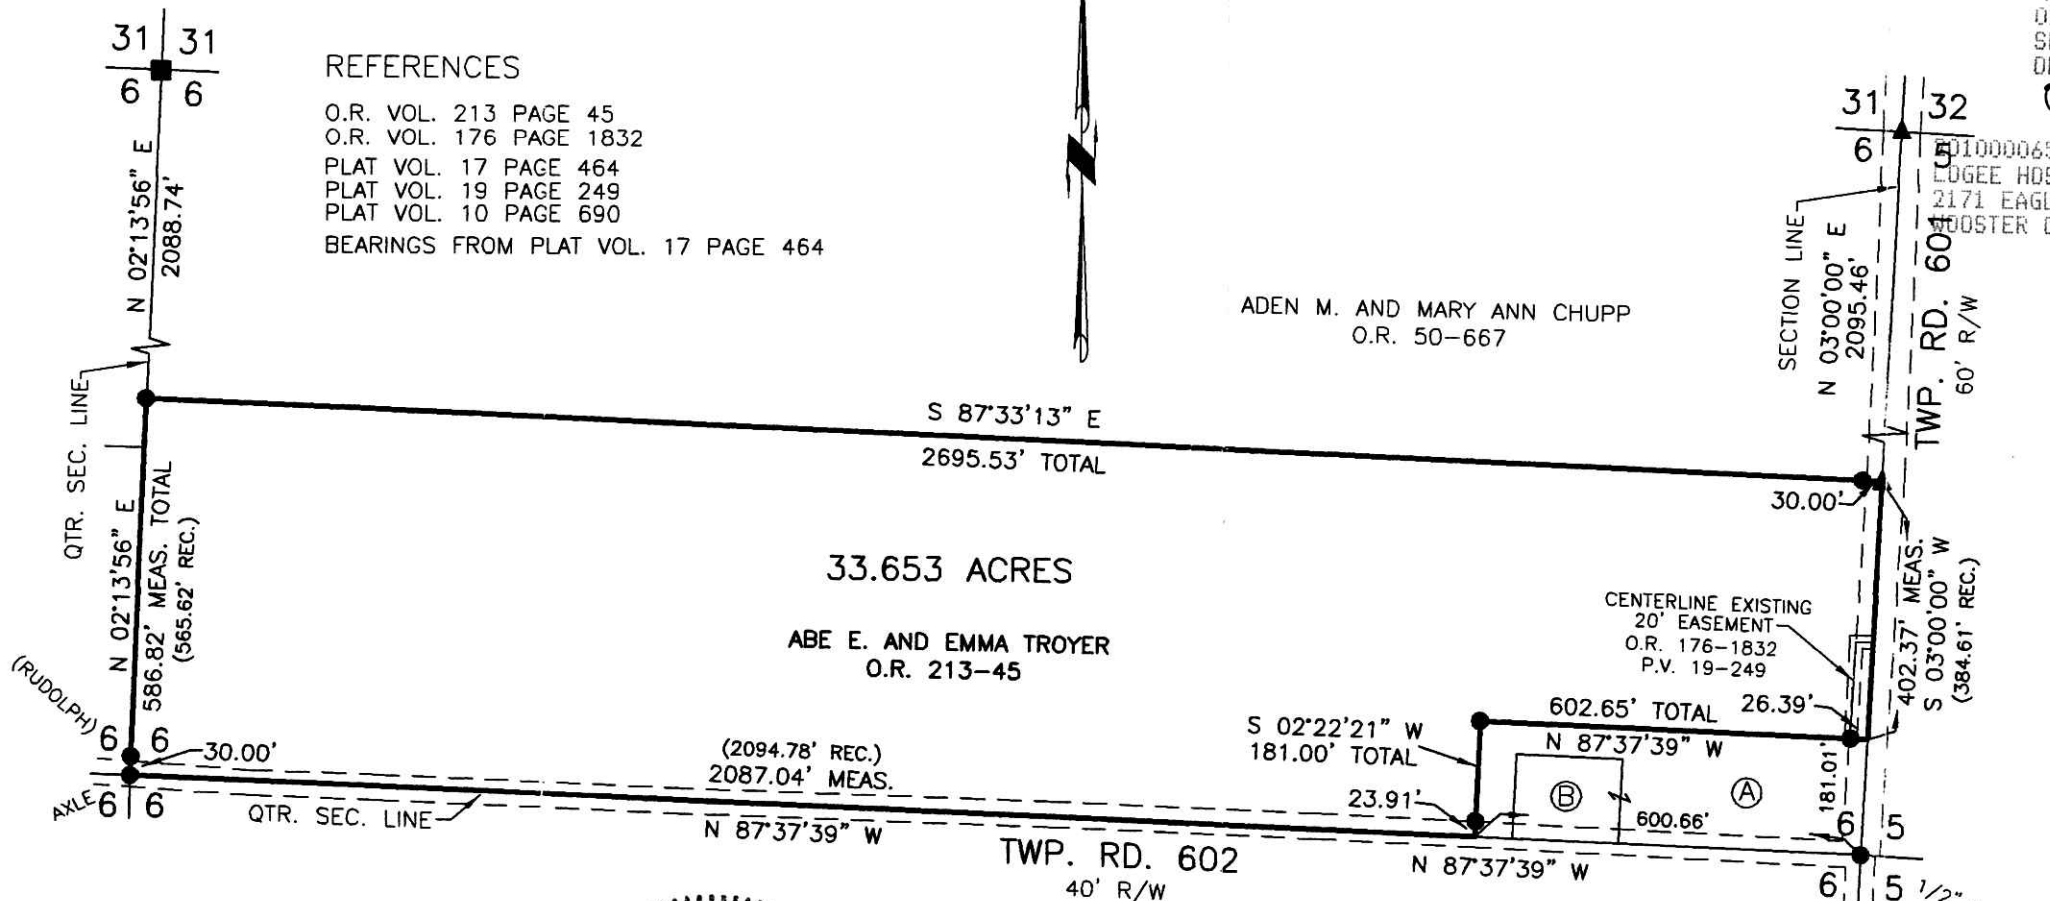

REFERENCES

- O.R. VOL. 213 PAGE 45
- O.R. VOL. 176 PAGE 1832
- PLAT VOL. 17 PAGE 464
- PLAT VOL. 19 PAGE 249
- PLAT VOL. 10 PAGE 690
- BEARINGS FROM PLAT VOL. 17 PAGE 464

I CERTIFY THIS SURVEY TO BE CORRECT  
 TO THE BEST OF MY KNOWLEDGE.

*A.L.G.*  
 AARON L. GERBER P.S. 8379  
 DATE: DEC. 4, 2009  
 ALG\KES  
 FILE NAME: WORK3\S-525-09\ALG



- Ⓐ ENOS S. AND EMMA MILLER  
O.R. 176-1832
- Ⓑ ENOS S. AND EMMA MILLER  
O.R. 175-353



DONALD C. BAKER SURVEYING  
 138 N. CLAY STREET  
 MILLERSBURG, OHIO 44654  
 PH. 330-674-4788  
 FAX 330-674-6027

PLAT APPROVED

1-11-2010 *kg*