

RETRACEMENT SURVEY OF O.R. 209-1893
 KNOX TOWNSHIP
 N.E. QTR. SECTION 19
 T-19 N; R-15 W
 HOLMES COUNTY, OHIO


SURVEYED FOR: CARLA GOUDY

REFERENCES

- DEED VOL. 278 PAGE 119
- O.R. VOL. 82 PAGE 394
- O.R. VOL. 209 PAGES 1893 & 3490
- SURVEY RECORD 1 PAGE 75
- SURVEY RECORD 2 PAGE 57
- SURVEY RECORD 3 PAGES 230 & 337
- SURVEY RECORD 4 PAGE 122
- PLAT VOL. 2 PAGE 229
- PLAT VOL. 8 PAGES 116 & 497
- PLAT VOL. 13 PAGE 36
- PLAT VOL. 19 PAGES 964, 1075, 1243 & 1429
- BEARINGS FROM PLAT VOL. 2 PAGE 229

Instrument 201000065031 OR Book Page 19 1645


201000065031
 Filed for Record in
 HOLMES COUNTY, OH
 ANITA HALL
 02-04-2010 At 03:46 pm.
 SMALL PLAT 40.00
 OR Book 19 Page 1645 - 1645
 ORV 216 pages 1401-1407

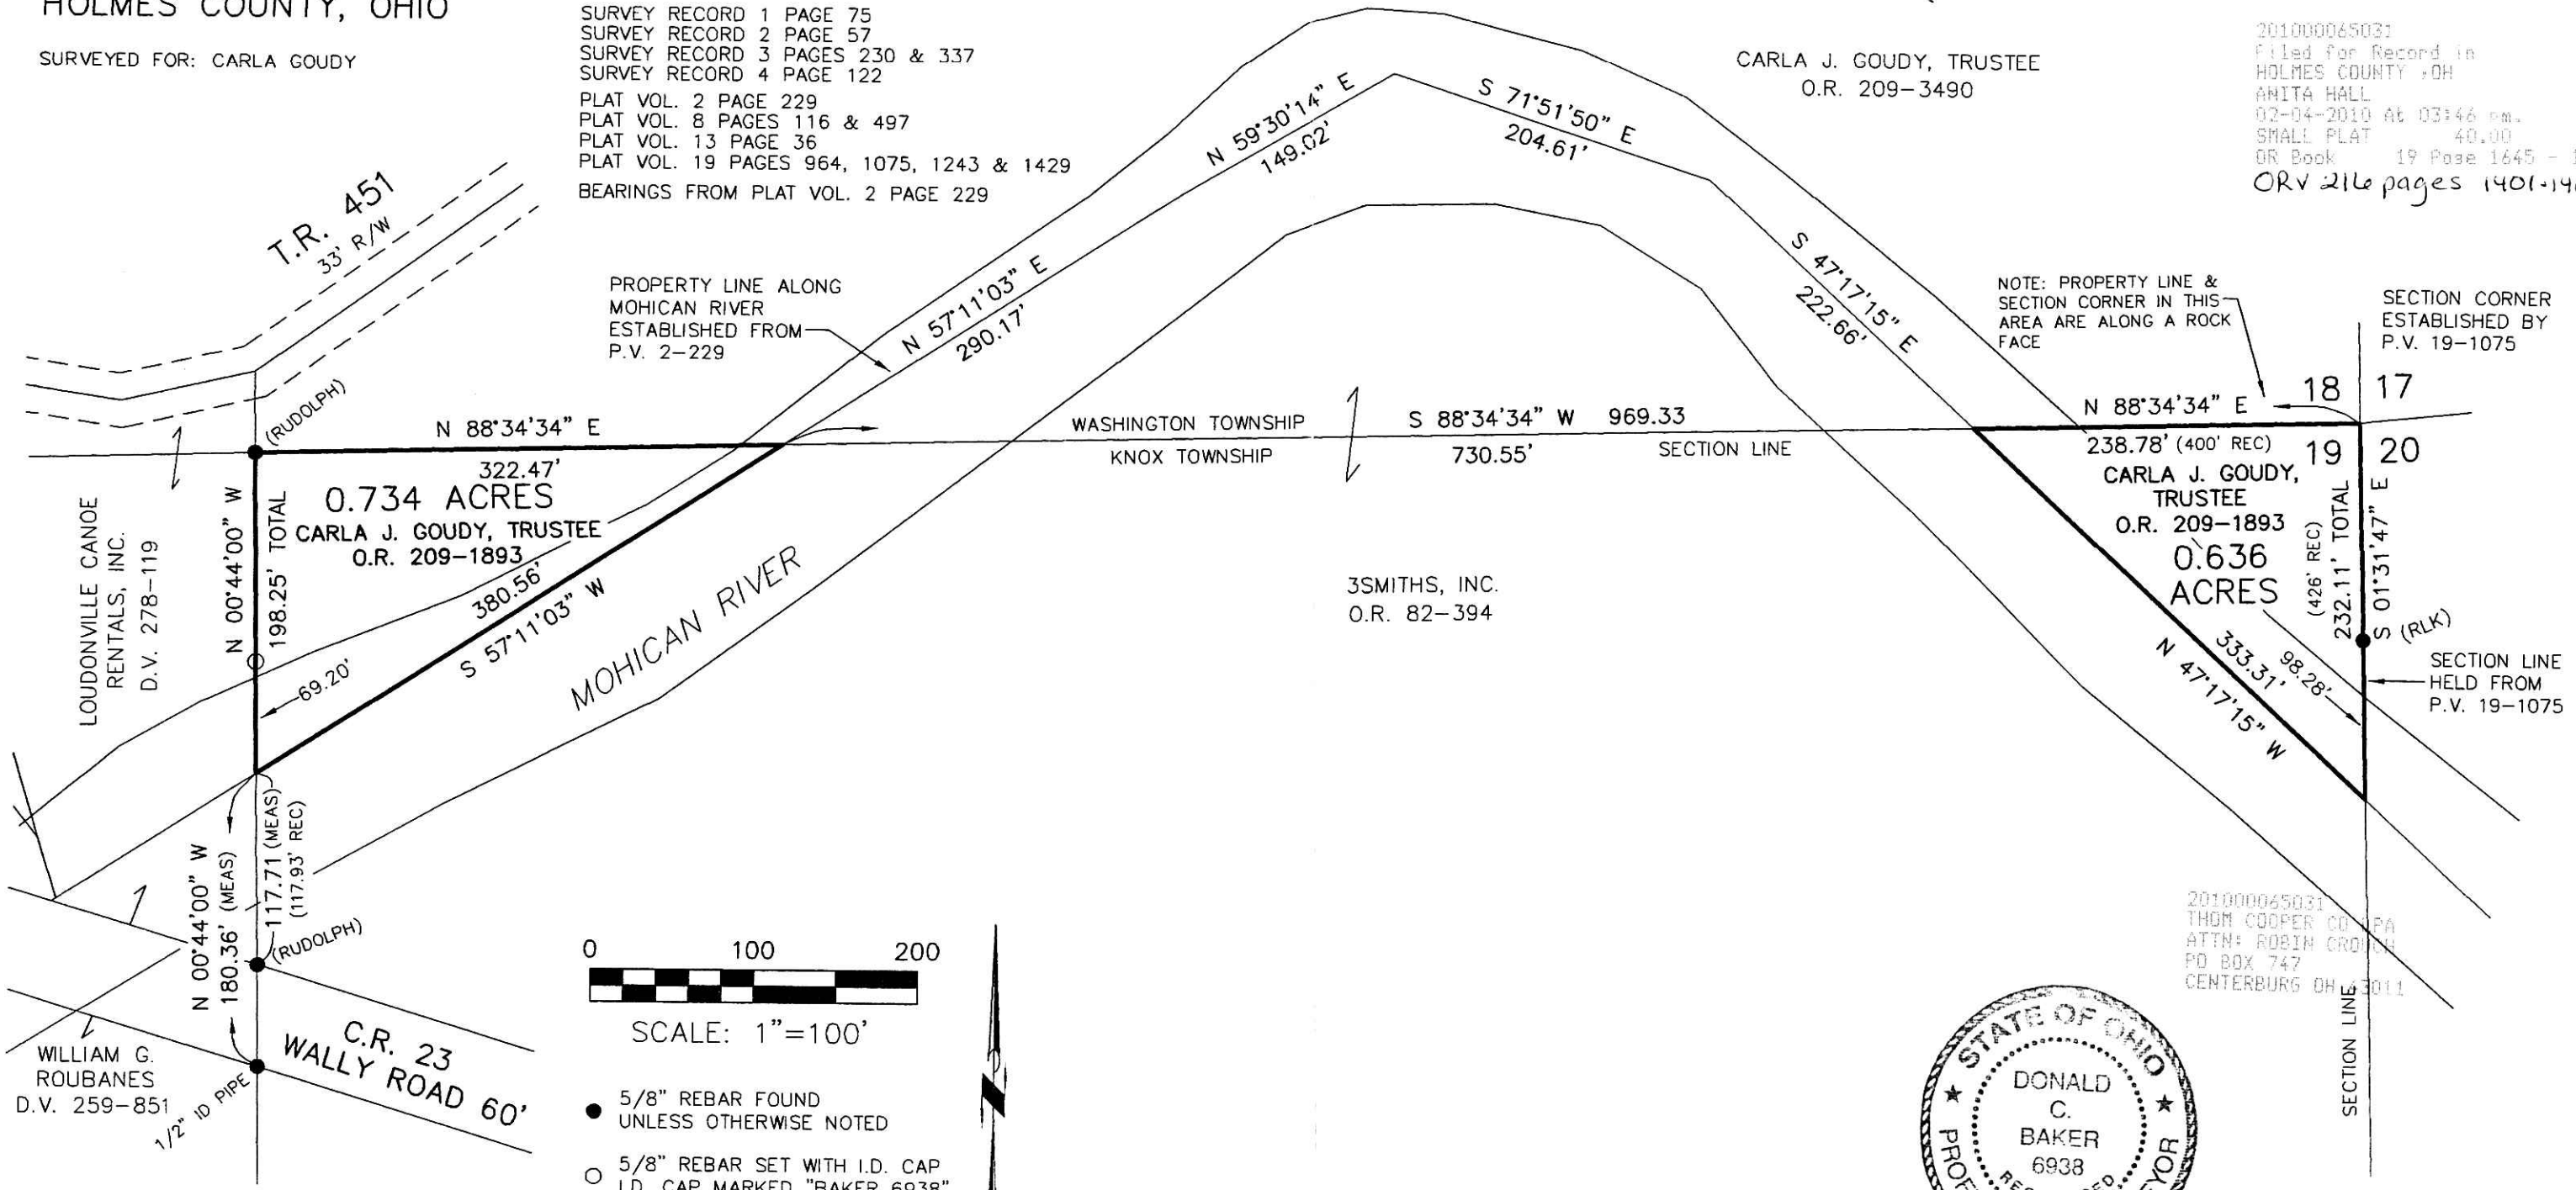

LOUDONVILLE CANOE
 RENTALS, INC.
 D.V. 278-119

WILLIAM G.
 ROUBANES
 D.V. 259-851

DONALD C. BAKER SURVEYING
 138 N. CLAY STREET
 MILLERSBURG, OHIO 44654
 PH. 330-674-4788
 FAX 330-674-6027

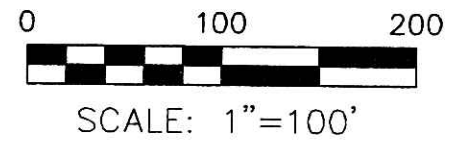

- 5/8" REBAR FOUND UNLESS OTHERWISE NOTED
- 5/8" REBAR SET WITH I.D. CAP I.D. CAP MARKED "BAKER 6938"



201000065031
 THOM COOPER CO., PA
 ATTN: ROBIN GROGAN
 PO BOX 747
 CENTERBURG OH 43011

PLAT APPROVED

1/28/2010

I CERTIFY THIS SURVEY TO BE CORRECT TO THE BEST OF MY KNOWLEDGE.

 DONALD C. BAKER P.S. 6938
 DATE: JAN. 8, 2009
 FDB/KES
 FILE NAME: WORK4\S-579-09\ERZ