



LOCATION MAP

Instrument 201000065733 OR Book Page 19 1666

201000065733
Filed for Record in
HOLMES COUNTY, OH
ANITA HALL, COUNTY RECORDER
04-05-2010 at 11:35 am.
PLAT MED 03.20
DR Book 19 Page 1666 - 1666
OR 217p 1419

201000065733
FRITCHFIELD,
& JOHNSTON ATTYS
MILLERSBURG OH

- X SPIKE FOUND
- 5/8" REBAR W/ I.D. CAP FOUND 'SHAMP'
- X MONUMENT SPIKE SET
- 5/8" REBAR SET WITH I.D. CAP MARKED SJL INC

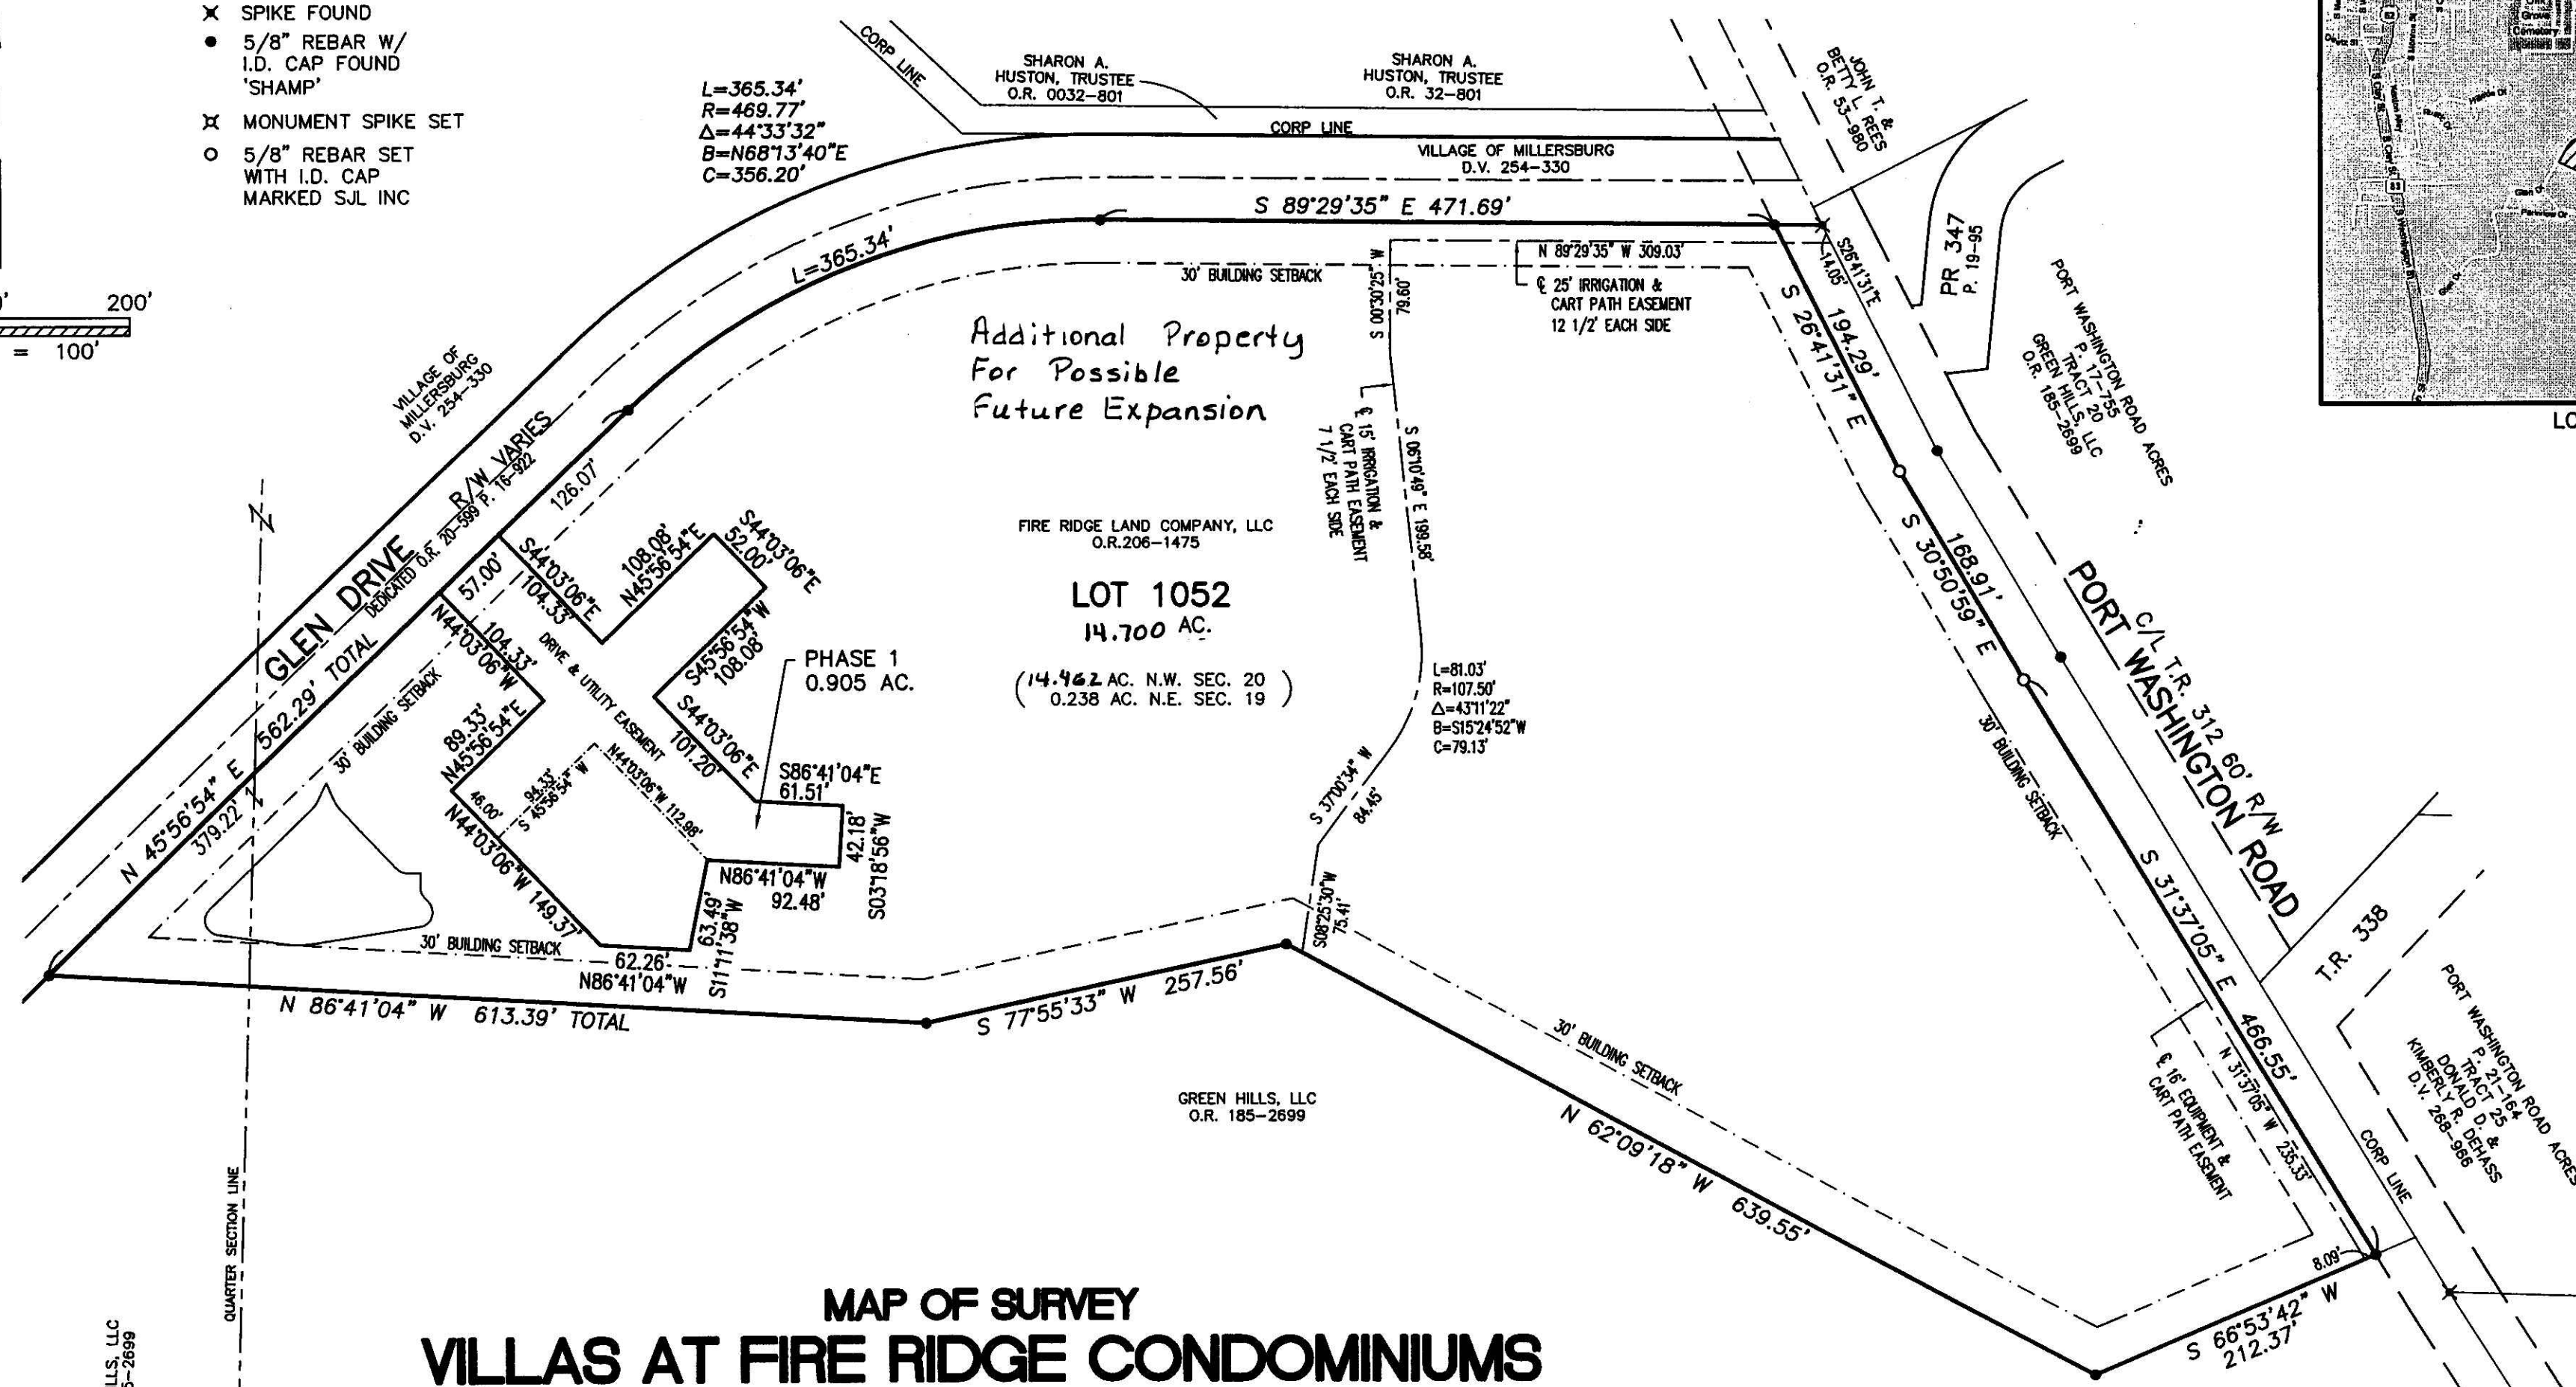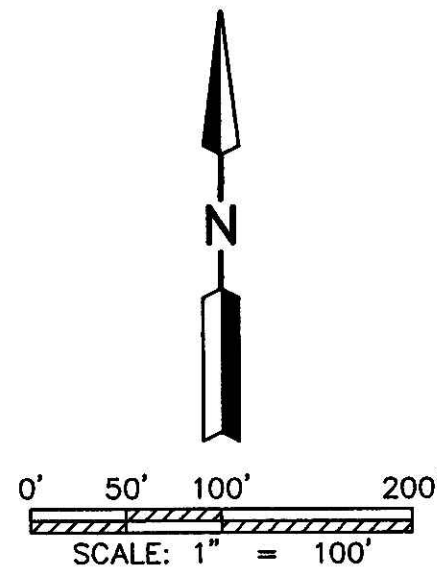

MAP OF SURVEY
VILLAS AT FIRE RIDGE CONDOMINIUMS
PHASE 1
 PART OF LOT 1052
 VILLAS AT FIRE RIDGE ALLOTMENT
 PLAT VOL. ___ PG. ___
VILLAGE OF MILLERSBURG
HOLMES COUNTY, OHIO

GREEN HILLS, LLC
O.R. 185-2699


19 20
19 20

TRANSFER NOT NECESSARY

DATE 4-5-10
AUDITOR J. Miller

4-2-2010 *EP*

SURVEYOR'S DECLARATION: I declare that this plan was prepared from an actual survey. That the same shows graphically, insofar as possible, the location of the boundaries, the layout, location and dimensions of units and of the buildings, the location and layout of limited common areas and facilities, the location and layout of common areas and facilities, and the location of appurtenant easements, if any.

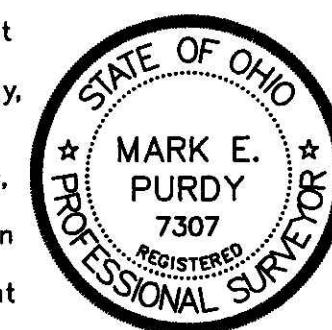

Mark E. Purdy
Mark E. Purdy, P.S. 7307
3-31-10
Date

REFERENCE SURVEY
Survey of a 16.172 AC. parcel by Jim Shamp of Heartland Surveying, Inc.

SHAFFER, JOHNSTON, LICHTENWALTER & ASSOCIATES, INC.
 Consulting Engineers & Surveyors
 3477 Commerce Parkway, Suite C
 Wooster, Ohio 44691
 TEL (330) 345-6377 FAX (330) 345-6725 EMAIL sjl@sj-inc.com

DRAWN C. Folt	CHECKED	SCALE 1" = 100'	DATE 03/31/10
DWG NO: EW-2332BA	JOB NO: EW-2332BA	SHEET 1 OF 1	