



RETRACEMENT SURVEY OF O.R. 189-1367
 PAINT TOWNSHIP
 S.W. QTR. SECTION 3
 S.E. QTR. SECTION 4
 T-14 N; R-11 W
 4TH. QTR., LOT 9
 T-10 N; R-5 W
 HOLMES COUNTY, OHIO

Instrument 20100068377 OR Book Page 19 1762

20100068377
 Filed for Record in
 HOLMES COUNTY, OH
 ANITA HALL, COUNTY RECORDER
 10-25-2010 At 11:48 AM
 PLAT MED 43.20
 OR Book 19 Page 1762 - 1763
 OR 221p 2142

SURVEYED FOR: ORUS MAST

- REFERENCES
- DEED VOL. 23 PAGE 301
 - DEED VOL. 52 PAGE 311
 - DEED VOL. 191 PAGE 199
 - O.R. VOL. 136 PAGE 503
 - O.R. VOL. 175 PAGES 2937 & 2940
 - O.R. VOL. 178 PAGE 2709
 - O.R. VOL. 189 PAGE 1367
 - O.R. VOL. 220 PAGE 1088
 - PLAT VOL. 18 PAGE 431
 - PLAT VOL. 19 PAGES 220 & 333
 - BEARINGS FROM PLAT VOL. 19 PAGE 333

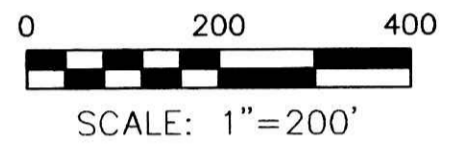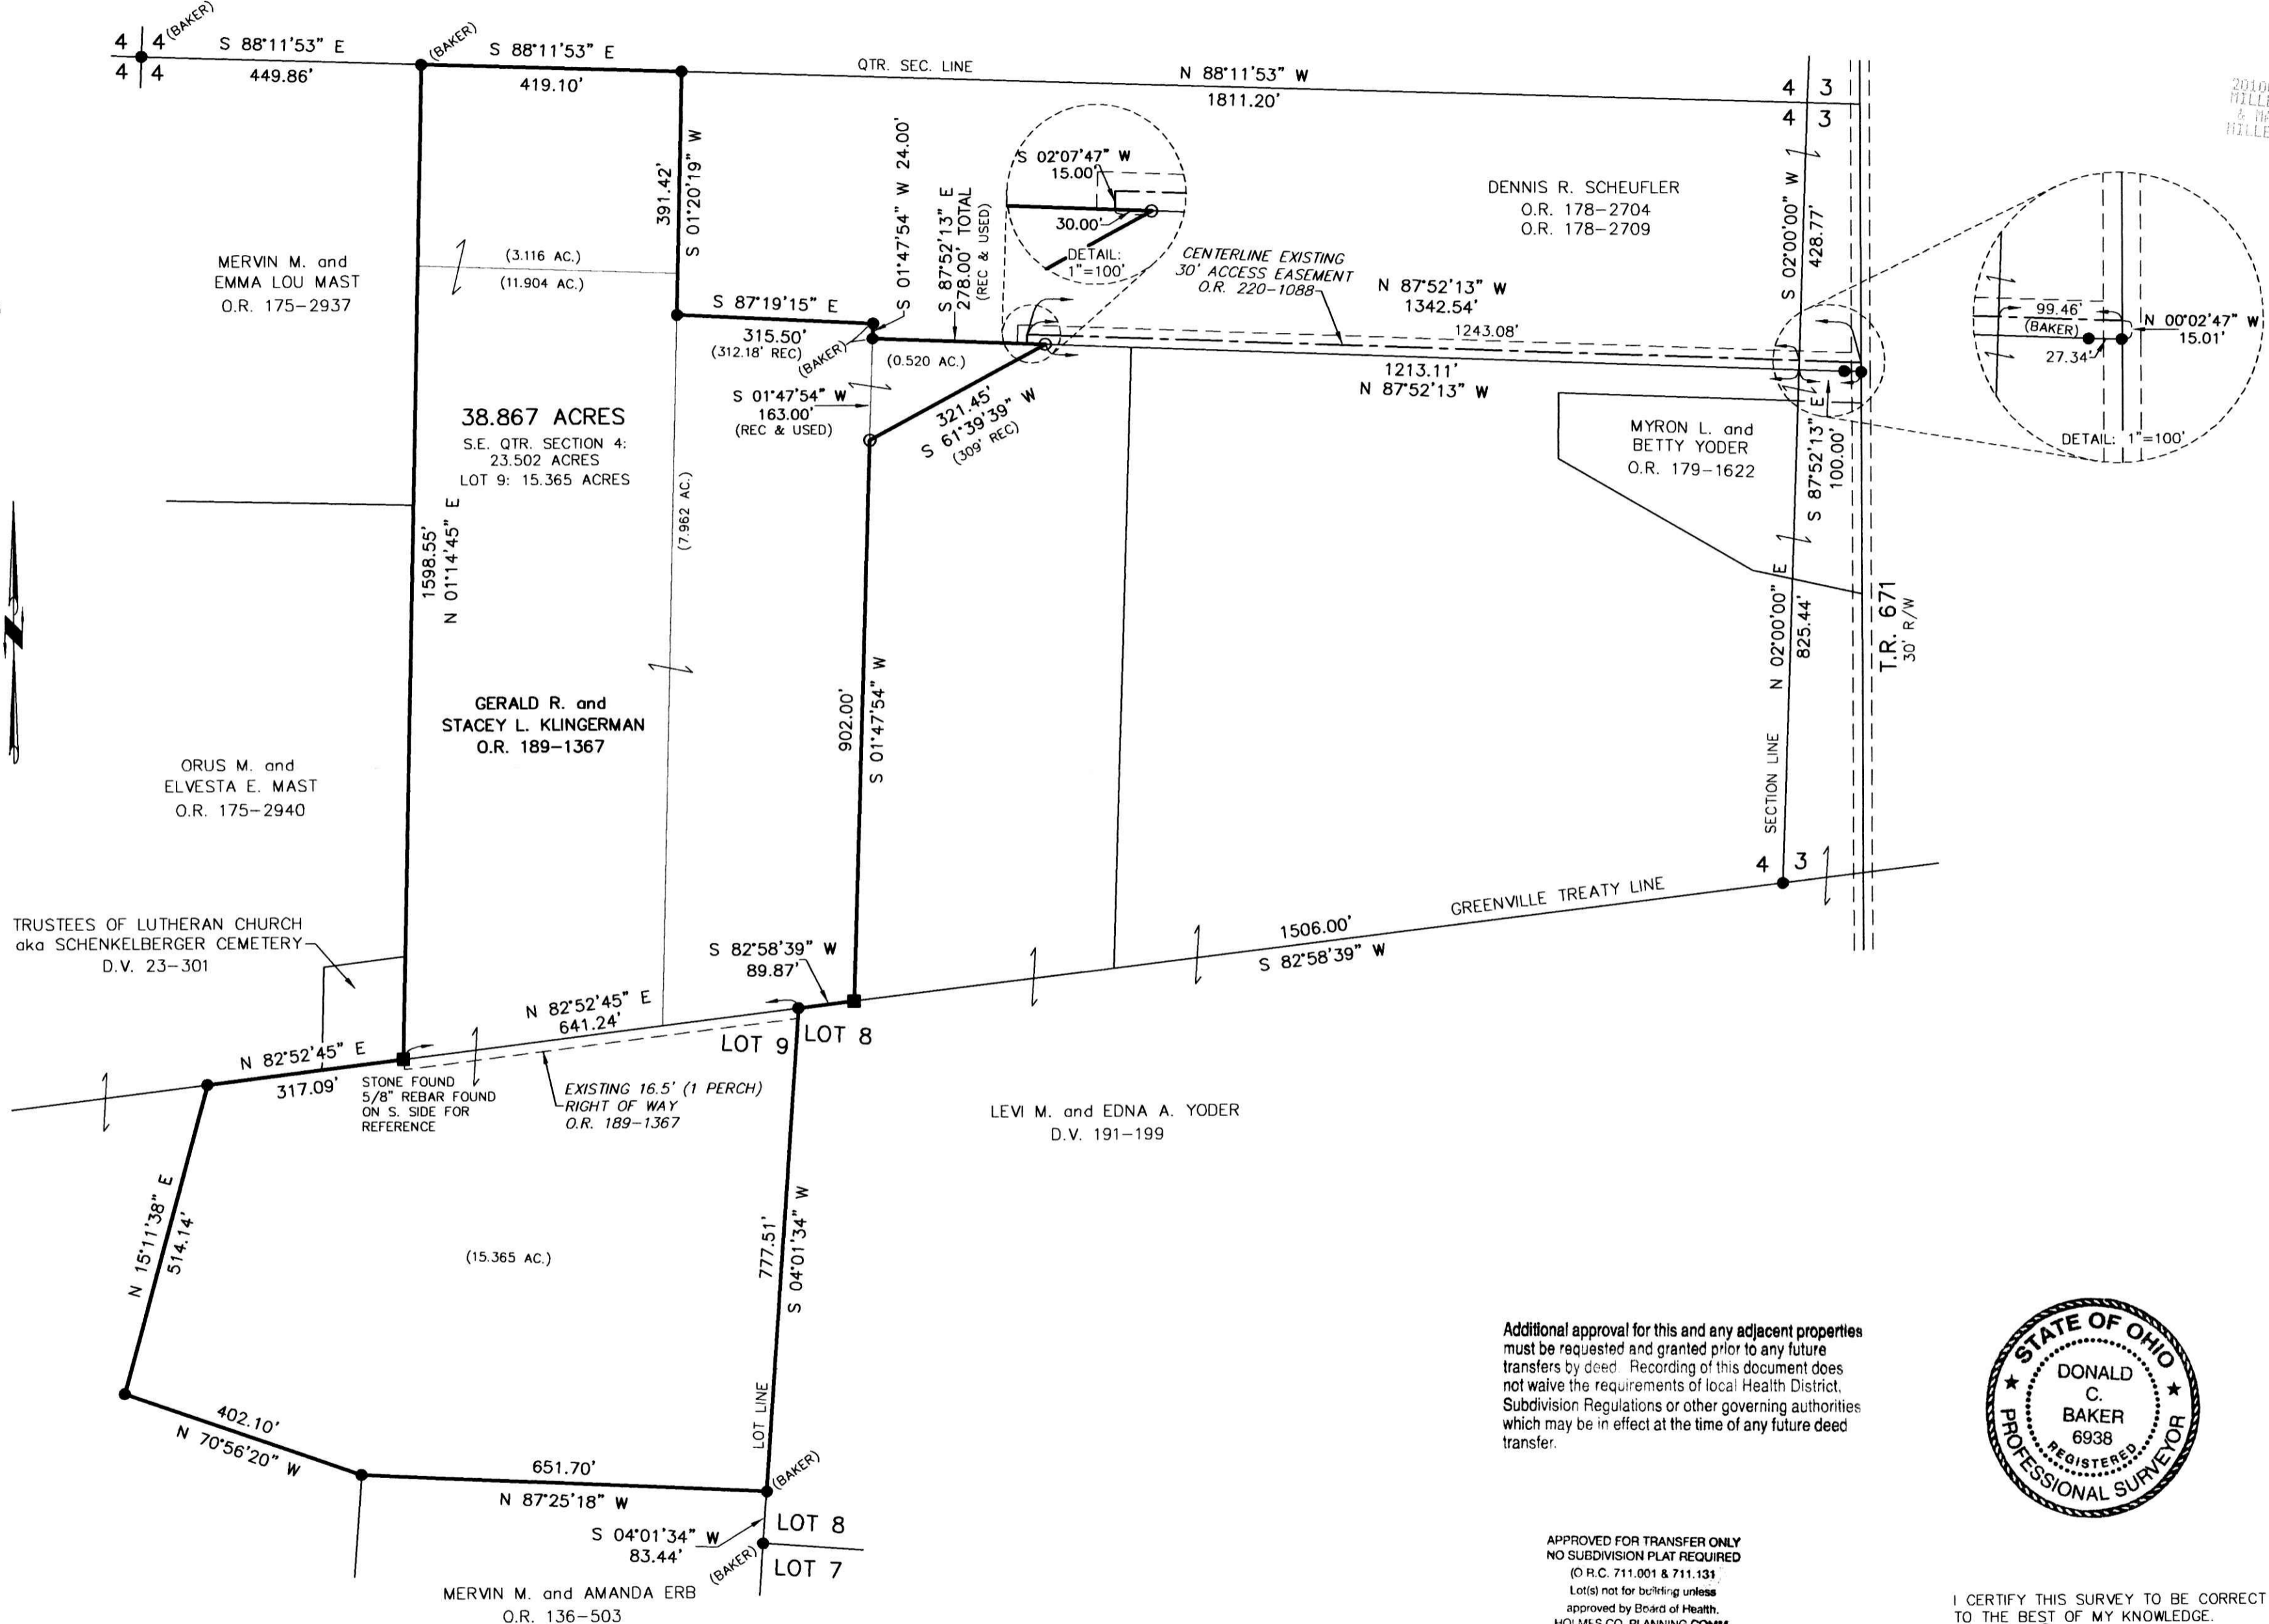

- STONE FOUND
- 5/8" REBAR FOUND UNLESS OTHERWISE NOTED
- 5/8" REBAR SET WITH I.D. CAP I.D. CAP MARKED "BAKER 6938"



Additional approval for this and any adjacent properties must be requested and granted prior to any future transfers by deed. Recording of this document does not waive the requirements of local Health District, Subdivision Regulations or other governing authorities which may be in effect at the time of any future deed transfer.



PLAT APPROVED
 9/17/2010

APPROVED FOR TRANSFER ONLY
 NO SUBDIVISION PLAT REQUIRED
 (O.R.C. 711.001 & 711.131)
 Lot(s) not for building unless approved by Board of Health, HOLMES CO. PLANNING COMM.
 By: *DB* Date: 9-21-10

I CERTIFY THIS SURVEY TO BE CORRECT TO THE BEST OF MY KNOWLEDGE.
Donald C. Baker
 DONALD C. BAKER P.S. 6938
 DATE: SEPT. 9, 2010
 FDB\DB-CJG
 FILE NAME: WORK4\S-392-10\ERZ

DONALD C. BAKER SURVEYING
 138 N. CLAY STREET
 MILLERSBURG, OHIO 44654
 PH. 330-674-4788
 FAX 330-674-6027