

RETRACEMENT SURVEY OF
D.V. 270-308

WASHINGTON TOWNSHIP
S.W. QTR. SECTION 31
T-20 N; R-15 W
HOLMES COUNTY, OHIO



SURVEYED FOR: REX MESSNER

REFERENCES

- DEED VOL. 270 PAGE 308
- O.R. VOL. 24 PAGE 360
- O.R. VOL. 48 PAGE 56
- O.R. VOL. 147 PAGE 564
- PLAT VOL. 2 PAGE 298
- PLAT VOL. 4 PAGE 130
- PLAT VOL. 5 PAGE 171
- PLAT VOL. 8 PAGE 387
- PLAT VOL. 14 PAGE 921
- BEARINGS FROM PLAT VOL. 14 PAGE 921

Instrument 201000069424 OR Book Page 19 1779

201000069424
Filed for Record in
HOLMES COUNTY, OH
ANITA HALL, COUNTY RECORDER
12-29-2010 At 09:36 am.
SMALL PLAT 40.00
OR Book 19 Page 1779 - 1779
ORV 223pg 602

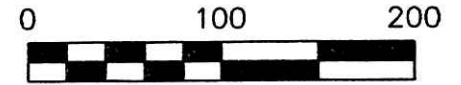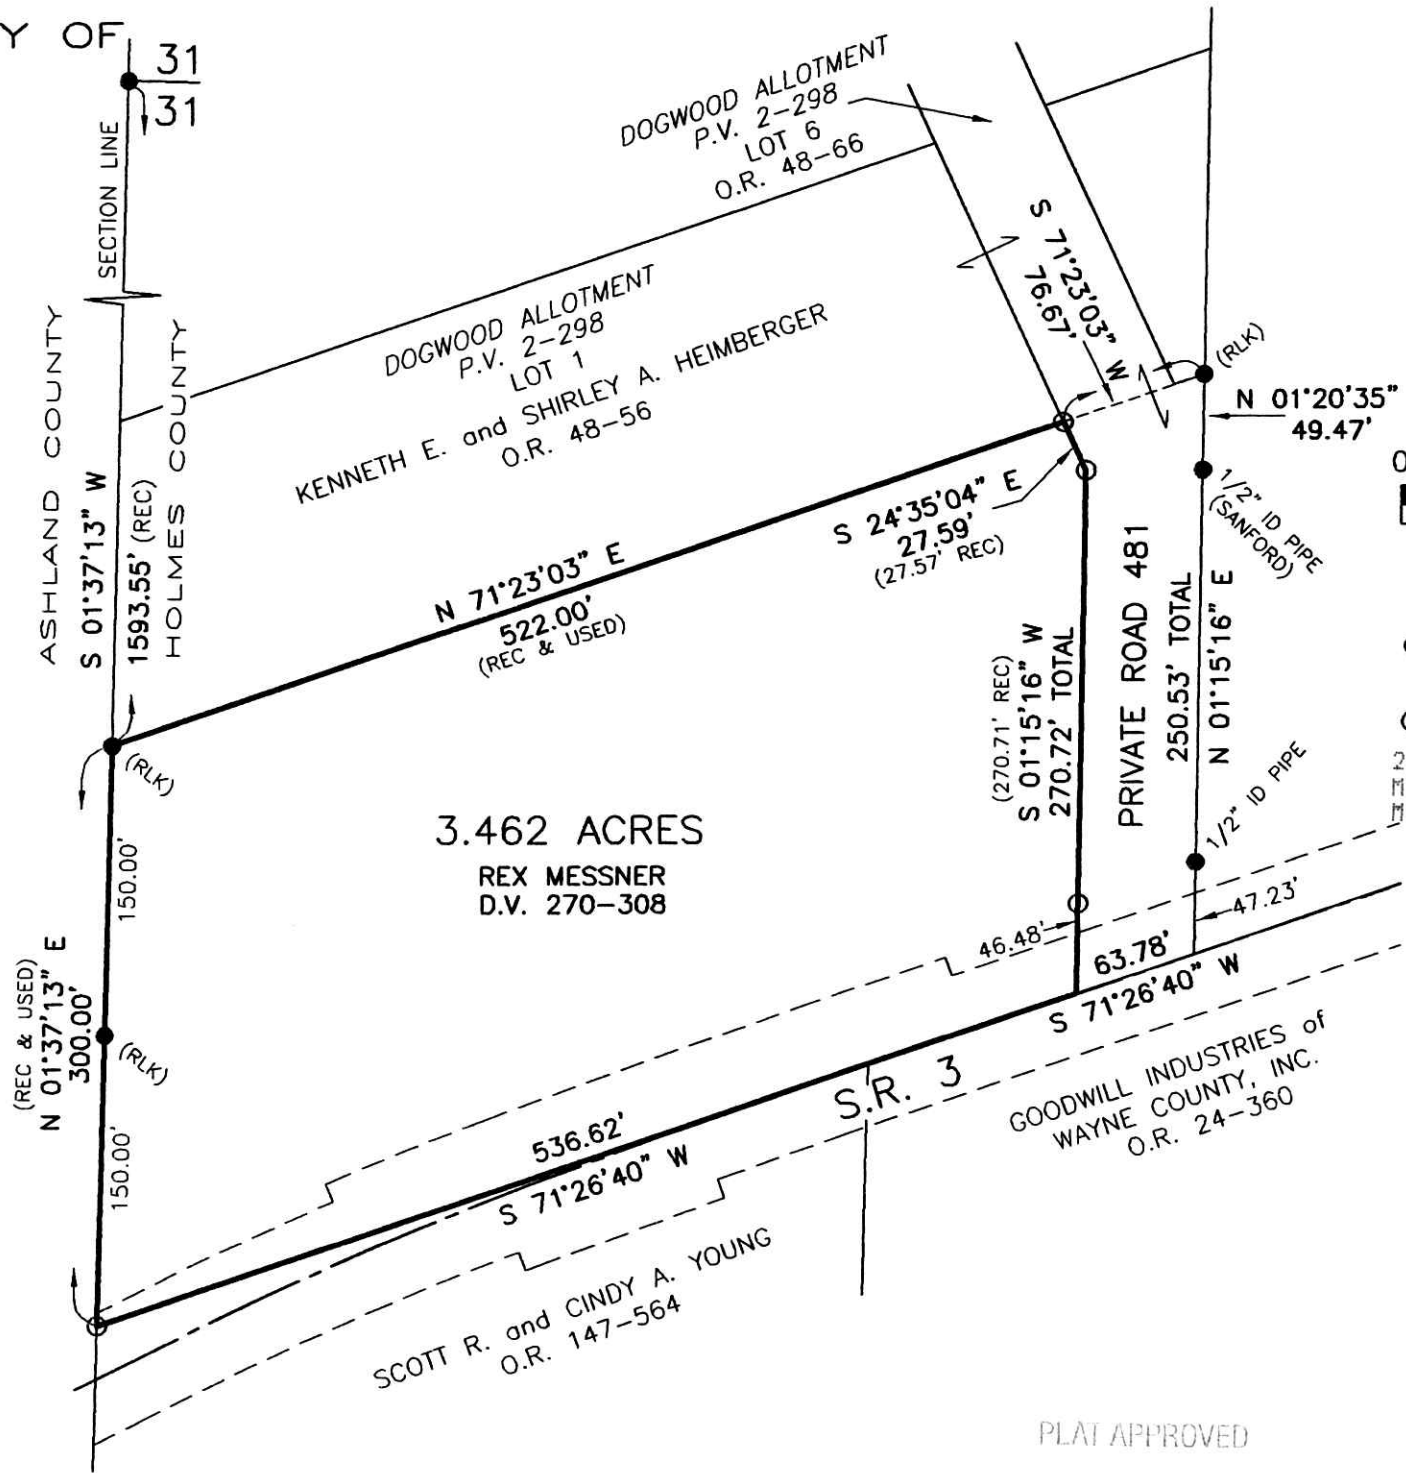

SCALE: 1"=100'

- 5/8" REBAR FOUND UNLESS OTHERWISE NOTED
- 5/8" REBAR SET WITH I.D. CAP I.D. CAP MARKED "BAKER 6938"

201000069424
MILLER MAST & MASON LTD
MILLERSBURG OH



I CERTIFY THIS SURVEY TO BE CORRECT TO THE BEST OF MY KNOWLEDGE.

Eric R. Zaugg
ERIC R. ZAUGG P.S. 8309
DATE: DEC. 14, 2010
ERZ\KES
FILE NAME: WORK3\S-500-10\ERZ

PLAT APPROVED

12/15/2010



DONALD C. BAKER SURVEYING
138 N. CLAY STREET
MILLERSBURG, OHIO 44654
PH. 330-674-4788
FAX 330-674-6027