


RETRACEMENT SURVEY OF O.R. 141-274
 BERLIN TOWNSHIP
 1ST. QTR., LOT 21
 T-9 N; R-6 W
 HOLMES COUNTY, OHIO

SURVEYED FOR: MARSHALL BAIRD



REFERENCES

- DEED VOL. 281 PAGE 763
- O.R. VOL. 141 PAGE 274
- O.R. VOL. 182 PAGE 3167
- O.R. VOL. 200 PAGE 57
- O.R. VOL. 201 PAGES 1078 & 3016
- O.R. VOL. 217 PAGE 1964
- PLAT VOL. 2 PAGE 63
- PLAT VOL. 3 PAGES 20B & 74B
- PLAT VOL. 7 PAGE 152
- PLAT VOL. 10 PAGE 863
- PLAT VOL. 16 PAGE 583
- PLAT VOL. 19 PAGES 482 & 1682
- BEARINGS FROM PLAT VOL. 19 PAGE 1682

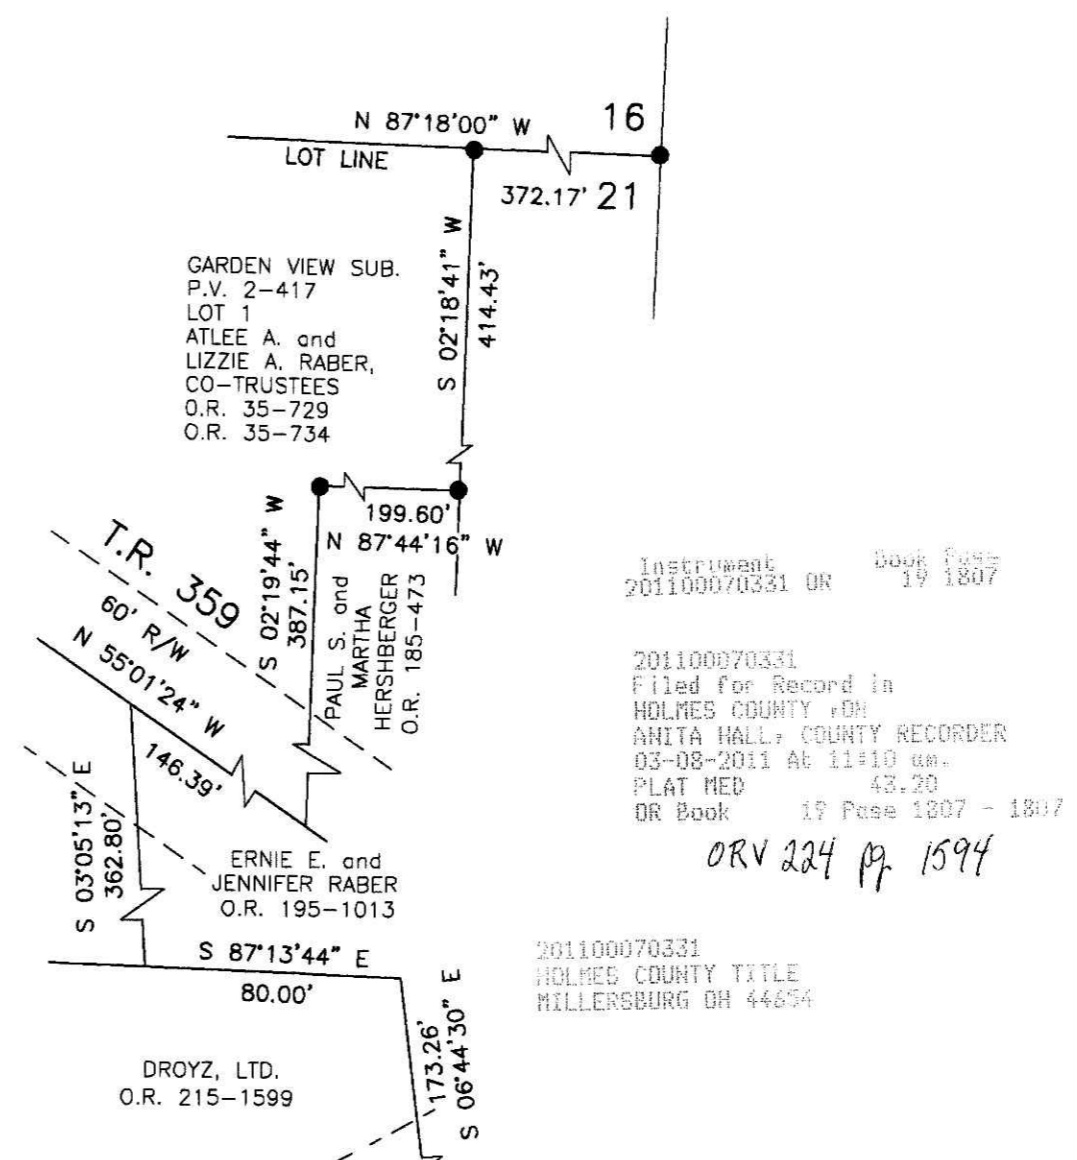

 201100070331
 Filed for Record in
 HOLMES COUNTY OH
 ANITA HALL, COUNTY RECORDER
 03-08-2011 At 11:10 am.
 PLAT MED 43.20
 OR Book 19 Page 1807 - 1807
 ORV 224 p. 1594

201100070331
 HOLMES COUNTY TITLE
 MILLERSBURG OH 44654

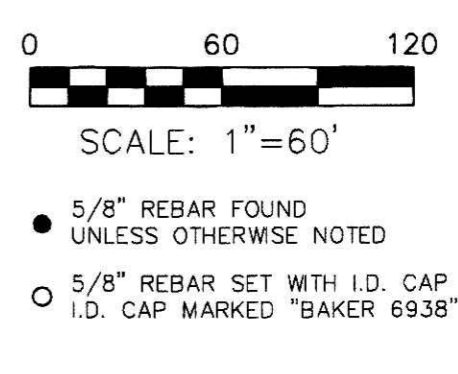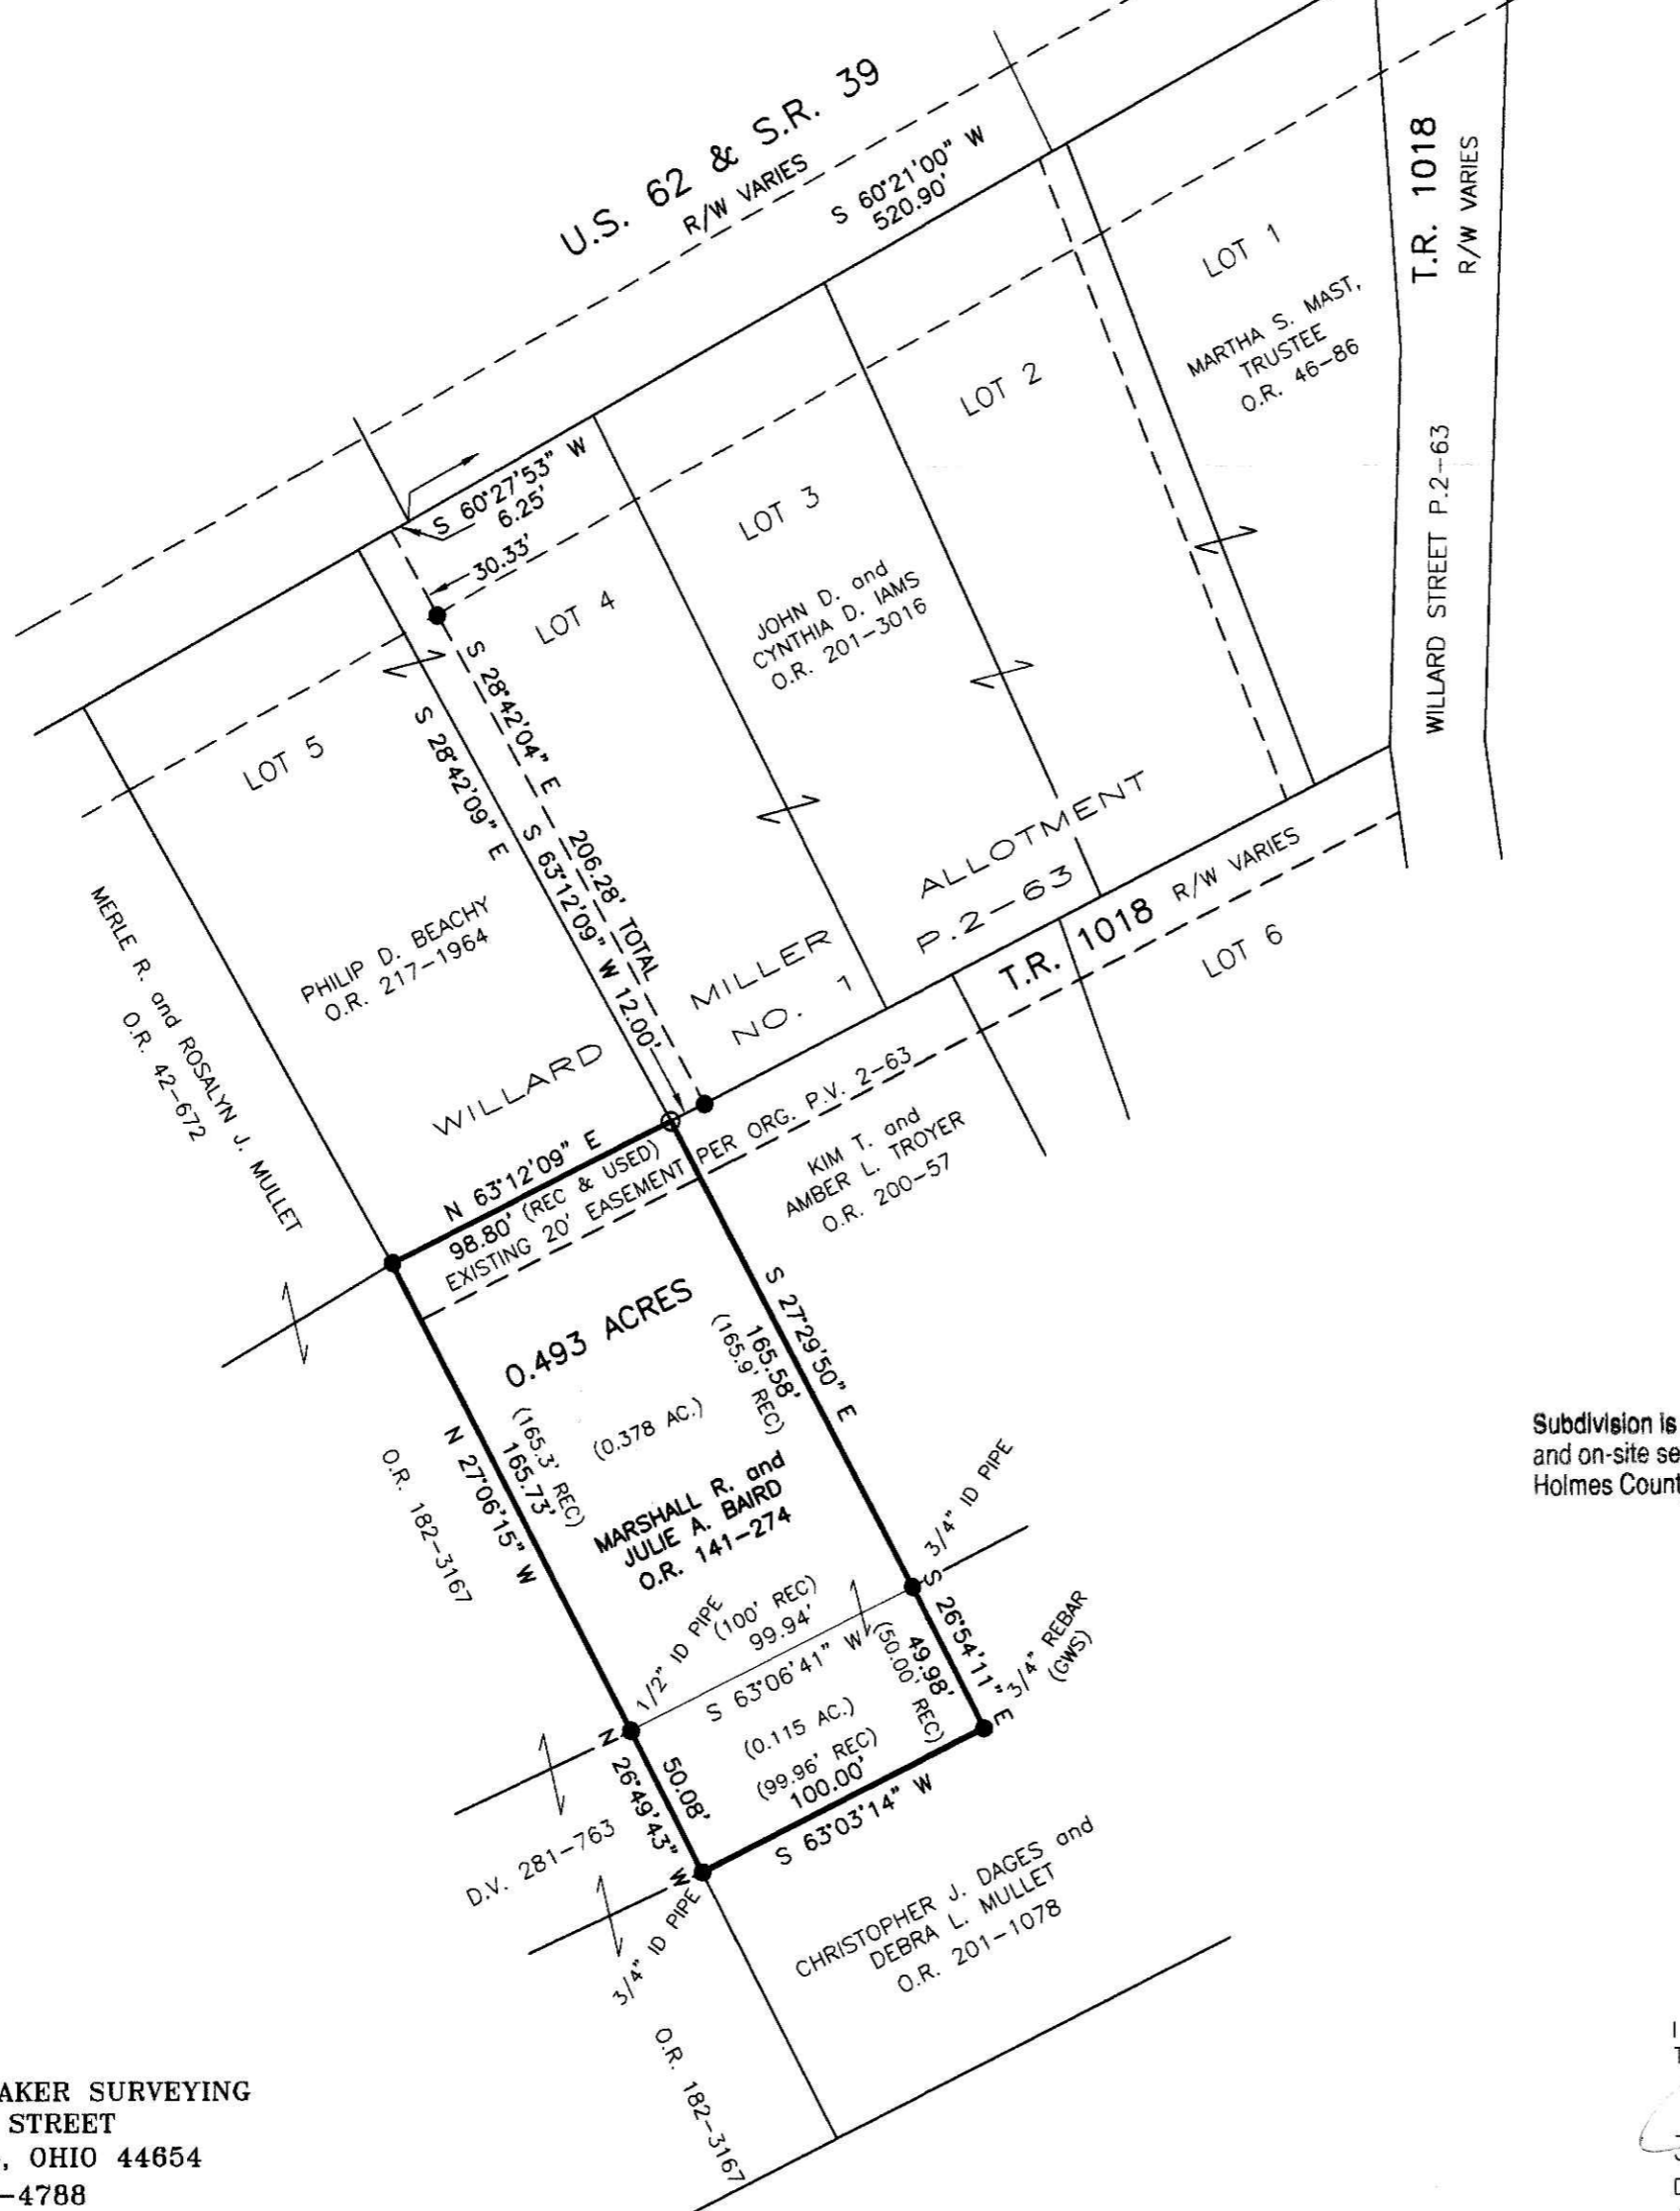

- 5/8" REBAR FOUND UNLESS OTHERWISE NOTED
- 5/8" REBAR SET WITH I.D. CAP I.D. CAP MARKED "BAKER 6938"

Subdivision is approvable for water wells and on-site sewage treatment. Per Holmes County District Board of Health

Additional approval for this and any adjacent properties must be requested and granted prior to any future transfers by deed. Recording of this document does not waive the requirements of local Health District, Subdivision Regulations or other governing authorities which may be in effect at the time of any future deed transfer.



I CERTIFY THIS SURVEY TO BE CORRECT TO THE BEST OF MY KNOWLEDGE.
 JAMIE D. DARR P.S. 7755
 DATE: FEB. 14, 2011
 JDD/ALG
 FILE NAME: WORK3\S-32-11\ERZ

APPROVED FOR TRANSFER ONLY
 NO SUBDIVISION PLAT REQUIRED
 (O.R.C. 711.001 & 711.131
 Lots) not for building unless
 approved by Board of Health,
 HOLMES CO. PLANNING COMM.
 By JB Date 2-28-11

PLAT APPROVED
 2/24/2011

DONALD C. BAKER SURVEYING
 138 N. CLAY STREET
 MILLERSBURG, OHIO 44654
 PH. 330-674-4788
 FAX 330-674-6027