

MONROE TOWNSHIP
3RD. QTR. LOT 31
T-9N; R-8W
HOLMES COUNTY, OHIO

Additional approval for this and any adjacent properties must be requested and granted prior to any future transfers by deed. Recording of this document does not waive the requirements of local Health District, Subdivision Regulations or other governing authorities which may be in effect at the time of any future deed transfer.

APPROVED FOR TRANSFER ONLY
NO SURVEYING PLAT REQUIRED
(O.R.C. 711.03 & 711.131
Lot(s) not for health purposes unless
approved by Board of Health,
HOLMES CO. PLANNING COMM.

By JB Date 7-5-11

REFERENCES:

- PLAT Vol. 9 PAGE 183
- PLAT Vol. 7 PAGE 600
- PLAT Vol. 10 PAGE 470
- PLAT Vol. 8 PAGE 354
- DEED Vol. 246 PAGE 820
- DEED Vol. 254 PAGE 350
- PLAT Vol. 12 PAGE 852



BEARINGS FROM PLAT Vol. 9 PAGE 183



I CERTIFY THIS SURVEY TO BE CORRECT TO THE BEST OF MY KNOWLEDGE.

Donald C. Baker
DONALD C. BAKER P.S. 6938
138 N. CLAY ST.
MILLERSBURG OHIO 44654
PH (330) 674-4788

FEB. 25, 2003
MLHB.

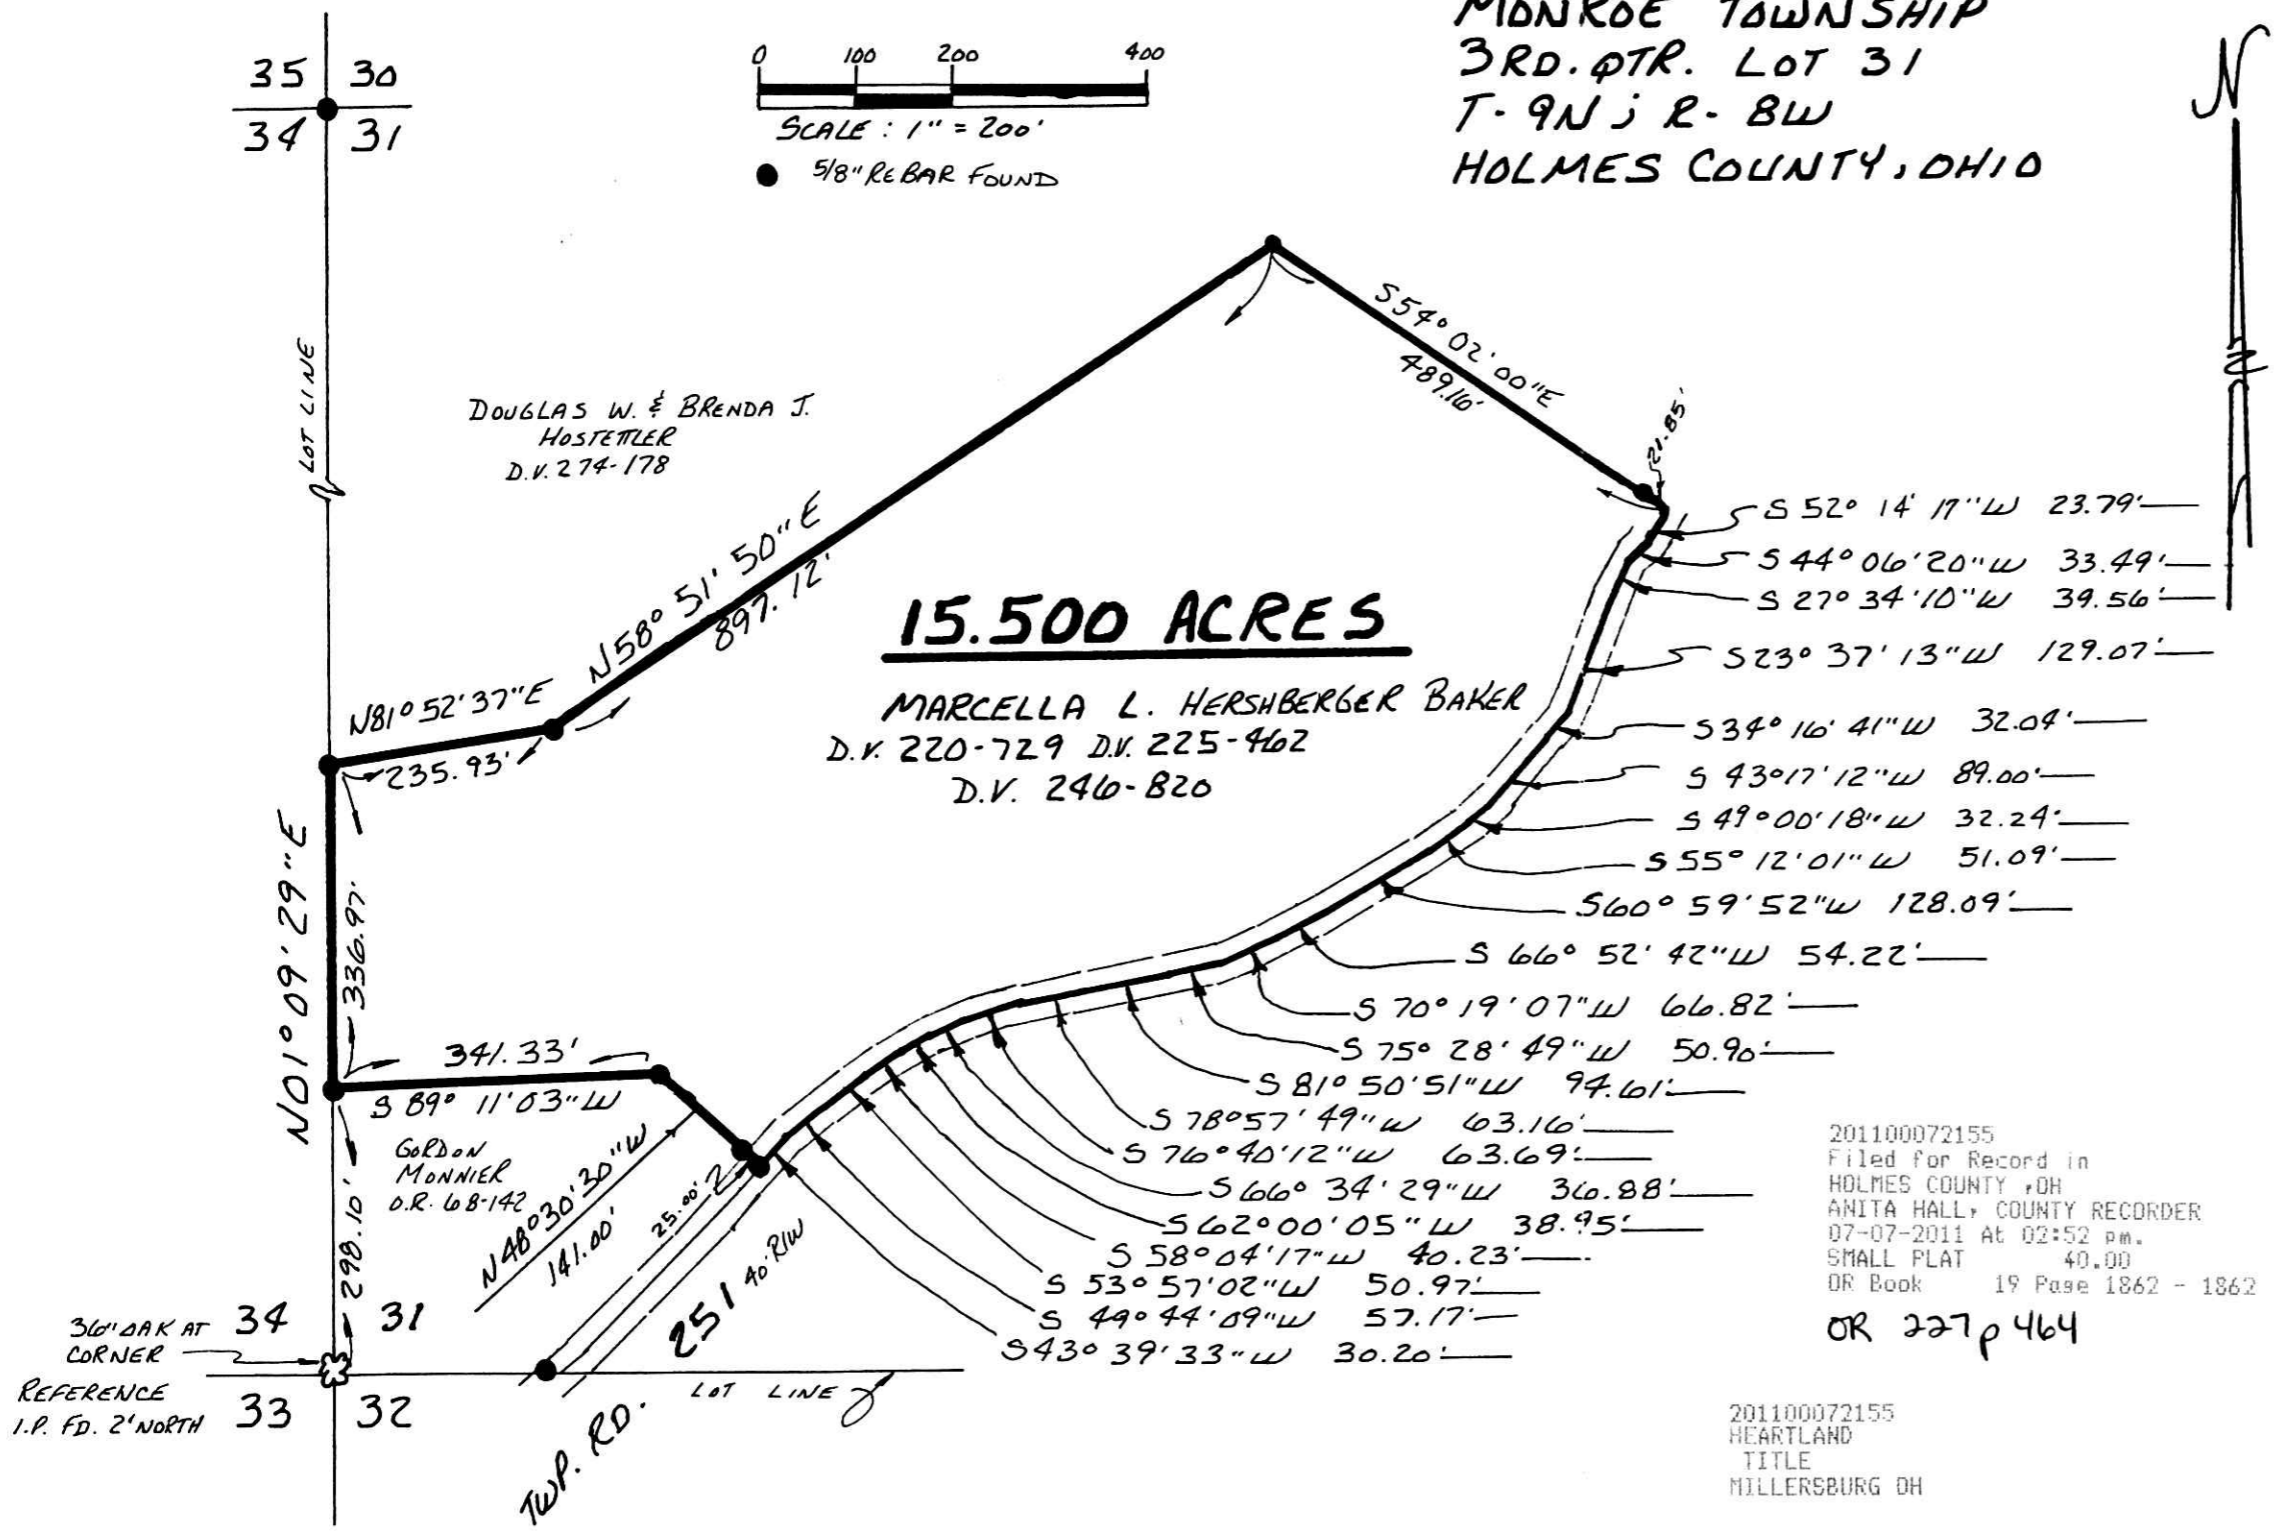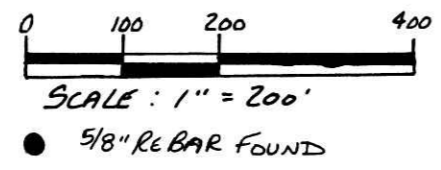

PLAT APPROVED

7/1/2011