


201100073736
 Filed for Record in
 HOLMES COUNTY OH
 ANITA HALL, COUNTY RECORDER
 10-24-2011 At 02:55 pm.
 SMALL PLAT 40.00
 OR Book 19 Page 1935 - 1938

○ BUILDING 10, UNIT 22 ○ BUILDING 10, UNIT 21

BUILDING DATA

UNIT NO.	LIVING	BASEMENT	TOTAL	GARAGE
19	1234 S.F.	N/A	1234 S.F.	456 S.F.
20	1232 S.F.	1191 S.F.	2423 S.F.	456 S.F.
21	1204 S.F.	1164 S.F.	2368 S.F.	456 S.F.
22	1204 S.F.	N/A	1204 S.F.	456 S.F.

OR 229p 1091
 201100073736
 CRITCHFIELD...
 & JOHNSON ATTYS
 MILLERSBURG OH

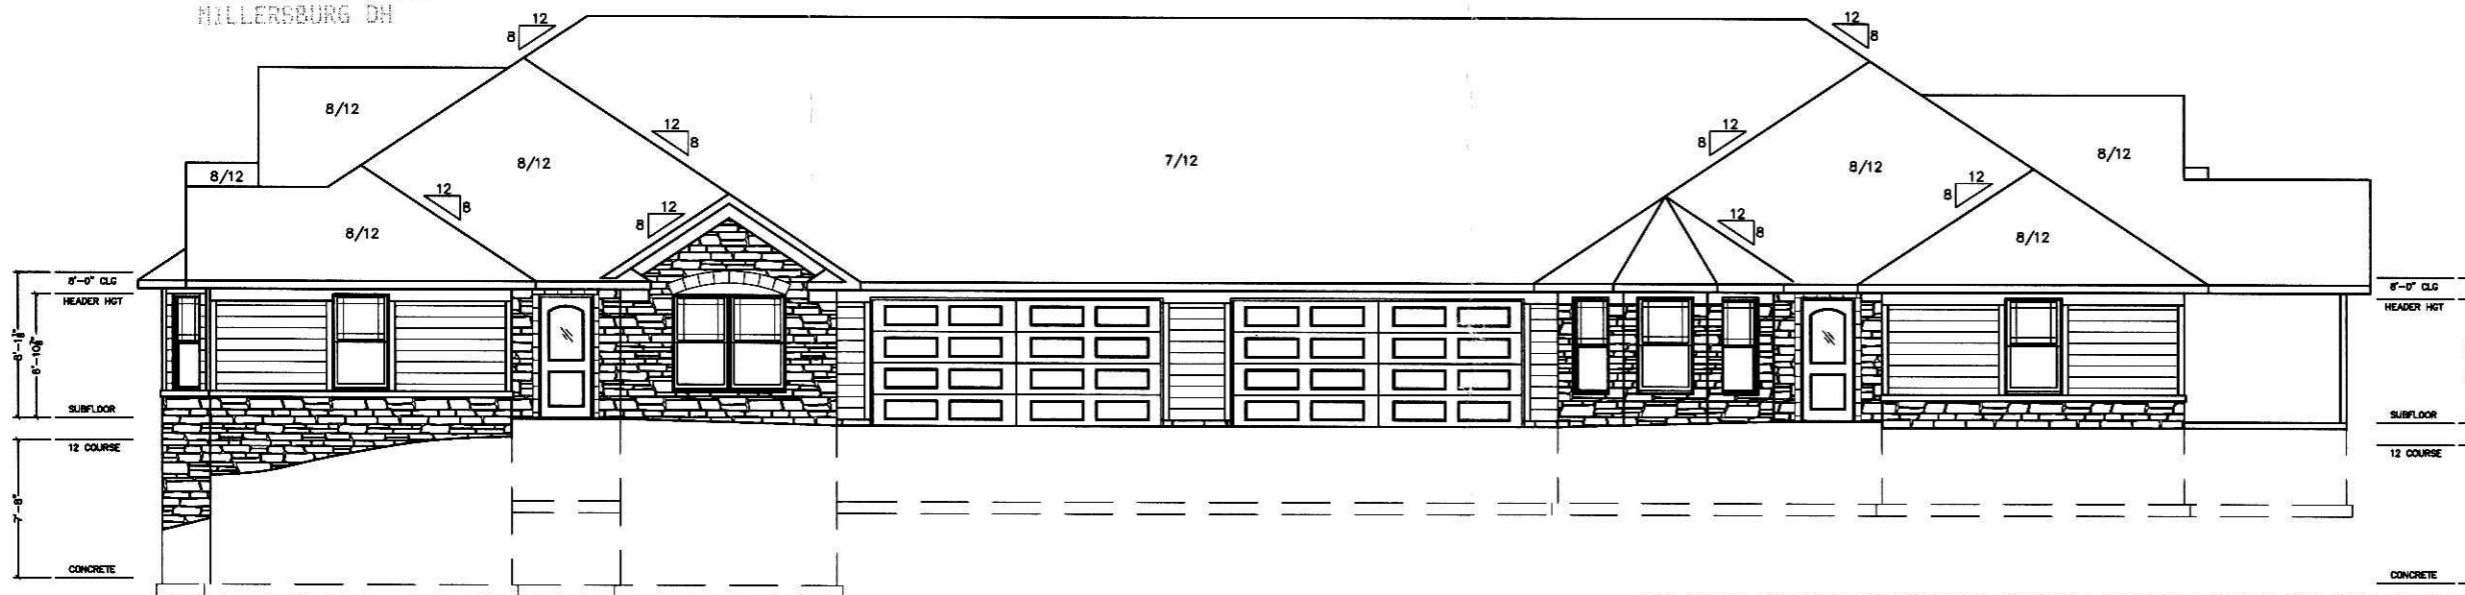

○ BUILDING 10, UNIT 20 ○ BUILDING 10, UNIT 19

THE BELOW LICENSED PROFESSIONAL ENGINEER CERTIFIES THAT TO THE BEST OF HIS KNOWLEDGE AND BELIEF THIS PLAT GRAPHICALLY SHOWS ALL THE PARTICULARS OF THE BUILDINGS AS CONSTRUCTED.

Harry D. Matter 10/4/11
 HARRY D. MATTER, REGISTERED PROFESSIONAL ENGINEER E-040167 DATE

THE BELOW LICENSED PROFESSIONAL SURVEYOR CERTIFIES THAT TO THE BEST OF HIS KNOWLEDGE AND BELIEF THIS PLAT ACCURATELY REFLECTS THE LOCATION OF IMPROVEMENTS AND RECORDED EASEMENTS.

Robert D. Allison 10/4/2011
 ROBERT D. ALLISON, REGISTERED PROFESSIONAL SURVEYOR 6589 DATE



THE COVE AT WALNUT CREEK
 MILLER-HOPE DEVELOPMENT
 WALNUT CREEK, OHIO
 44687

NOTES

DATE	
1ST FLOOR	SOFT
2ND FLOOR	SOFT
LOWER LEVEL	SOFT
TOTAL	SOFT
GARAGE	SOFT
BONUS	SOFT
DESIGNER	
JOB NO.	

MICHAEL LEHMAN
 CONSULTING
 ENGINEER
 15057 ARNOLD RD
 DALTON, OHIO 44618
 330-485-1387