

CLARK TOWNSHIP  
N.E. QTR. SECTION 24  
T-8 N; R-5 W  
HOLMES COUNTY, OHIO

SURVEYED FOR: MAHLON HERSHBERGER


REFERENCES

- DEED VOL. 227 PAGE 851
  - O.R. VOL. 49 PAGE 392
  - O.R. VOL. 184 PAGE 1622
  - PLAT VOL. 7 PAGE 755
  - PLAT VOL. 19 PAGE 613
  - PLAT VOL. 19 PAGE 1064
  - PLAT VOL. 19 PAGE 1111
- BEARINGS FROM PLAT VOL. 19 PAGE 1111



I CERTIFY THIS SURVEY TO BE CORRECT TO THE BEST OF MY KNOWLEDGE.

*Donald C. Baker*  
DONALD C. BAKER P.S. 6938  
DATE: NOV. 3, 2011  
FDB\CJG  
FILE NAME: WORK4\S-520-11\ALG

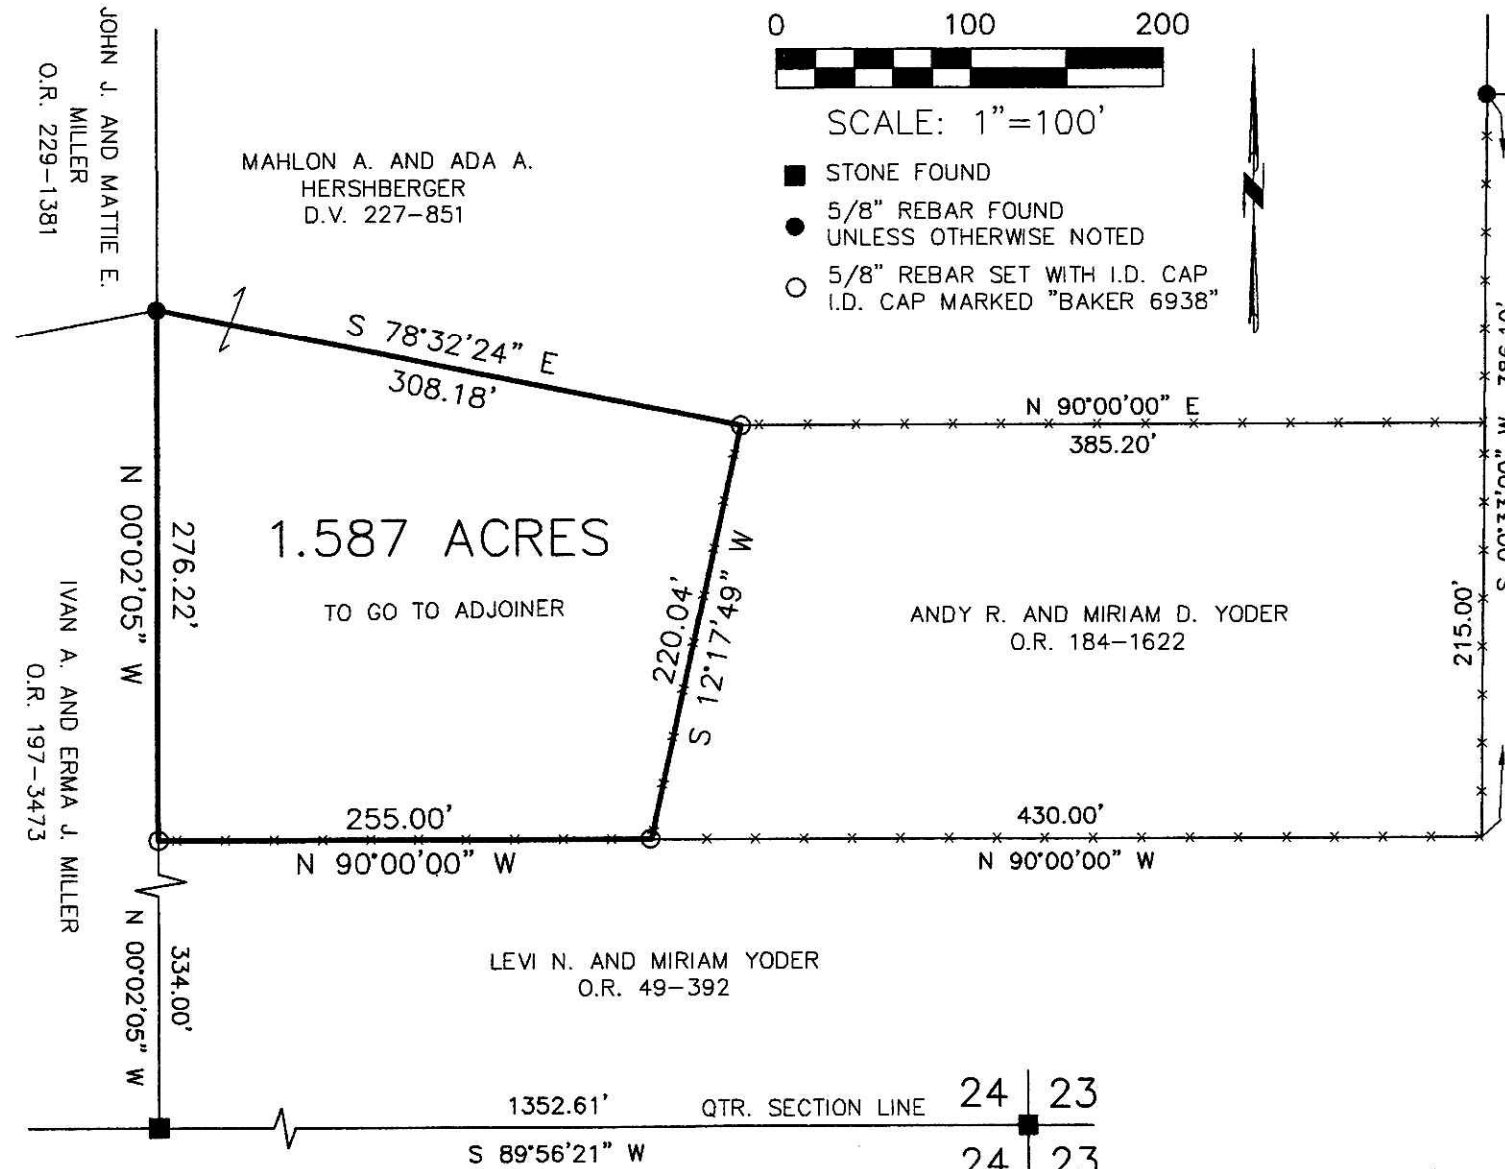

0 100 200



SCALE: 1"=100'

- STONE FOUND
- 5/8" REBAR FOUND UNLESS OTHERWISE NOTED
- 5/8" REBAR SET WITH I.D. CAP I.D. CAP MARKED "BAKER 6938"

201100074246  
Filed for Record in  
HOLMES COUNTY, OH  
ANITA HALL, COUNTY RECORDER  
11-29-2011 At 03:19 pm.  
SMALL PLAT 40.00  
OR Book 19 Page 1960 - 1960

OR 230 p 327

201100074246  
PAUL A.  
MILLER LAW  
MILLERSBURG OH

APPROVED FOR TRANSFER ONLY  
NO SUBDIVISION PLAT REQUIRED  
(O.R.C. 711.02 & 711.131  
Lot(s) not for sale, unless  
approved by Board of Health.  
HOLMES CO. PLANNING COMM.

By *JB* Date *11-17-11*

Additional approval for this and any adjacent properties must be requested and granted prior to any future transfers by deed. Recording of this document does not waive the requirements of local Health District, Subdivision Regulations or other governing authorities which may be in effect at the time of any future deed transfer.

PLAT APPROVED

*11/16/2011*



DONALD C. BAKER SURVEYING  
138 N. CLAY STREET  
MILLERSBURG, OHIO 44654  
PH. 330-674-4788  
FAX 330-674-6027