


201400088014

B: 19 P: 2453
 FILED FOR RECORD IN
 HOLMES COUNTY, OH
 ANITA HALL, COUNTY RECORDER
 04/02/2014 2:44 PM
 SMALL PLAT - 40.00
 PAGES: 1

ORV 248 PG 2415

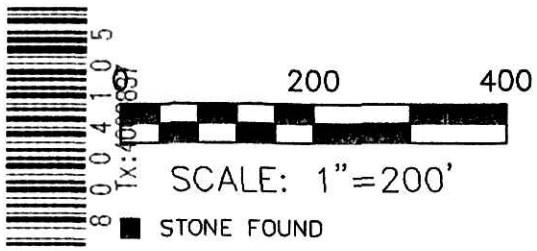


- STONE FOUND
- 5/8" REBAR FOUND UNLESS OTHERWISE NOTED
- 5/8" REBAR SET WITH I.D. CAP I.D. CAP MARKED "BAKER 6938"

RETRACEMENT SURVEY
 OF O.R. VOL. 247 PAGE 5317

MECHANIC TOWNSHIP
 N.W. QTR. SECTION 9
 T-8 N; R-7 W
 HOLMES COUNTY, OHIO

SURVEYED FOR: NELSON MILLER

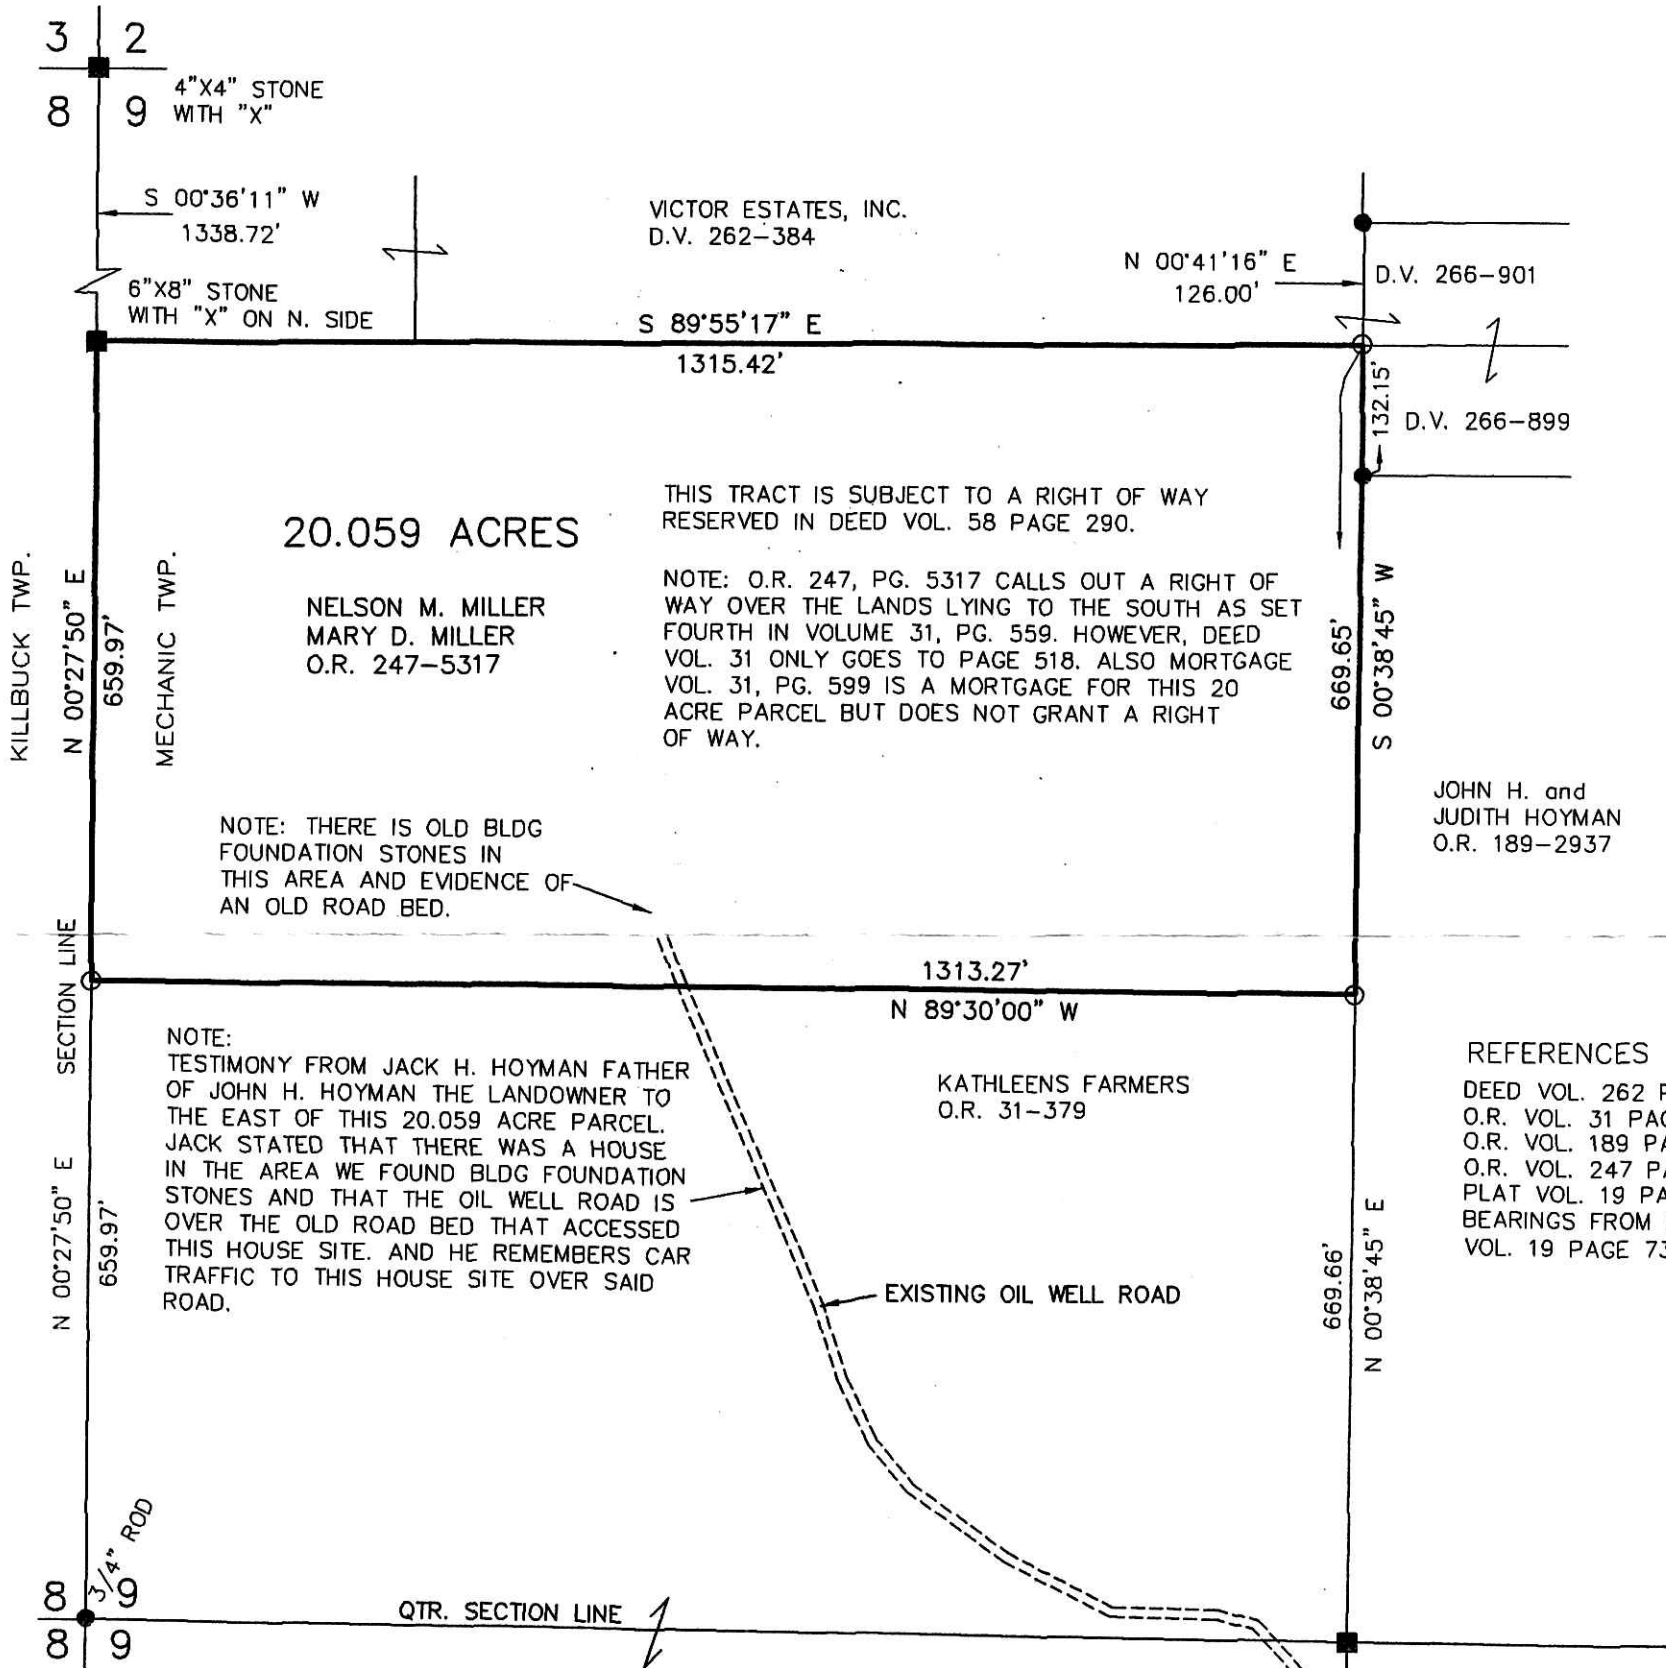

- REFERENCES
- DEED VOL. 262 PAGE 384
 - O.R. VOL. 31 PAGE 379
 - O.R. VOL. 189 PAGE 2937
 - O.R. VOL. 247 PAGE 5317
 - PLAT VOL. 19 PAGE 736
 - BEARINGS FROM PLAT VOL. 19 PAGE 736



I CERTIFY THIS SURVEY TO BE CORRECT TO THE BEST OF MY KNOWLEDGE.

Donald C. Baker
 DONALD C. BAKER P.S. 6938
 DATE: FEBRUARY 19, 2014
 KES\CJG
 FILE NAME: WORK4\S-58-14\MD



DONALD C. BAKER SURVEYING
 138 N. CLAY STREET
 MILLERSBURG, OHIO 44654
 PH. 330-674-4788
 FAX 330-674-6027

C.R. 150
 60' R/W

PLAT APPROVED

3-18-2014 *AB*