201400089324
B: 19 P: 2512
FILED FOR RECORD IN
HOLMES COUNTY, OH
ANITA HALL, COUNTY RECORDER
06/30/2014 2:02 PM
SMALL PLAT . 40.00
PAGES: 1
ORV 349 pg 2084

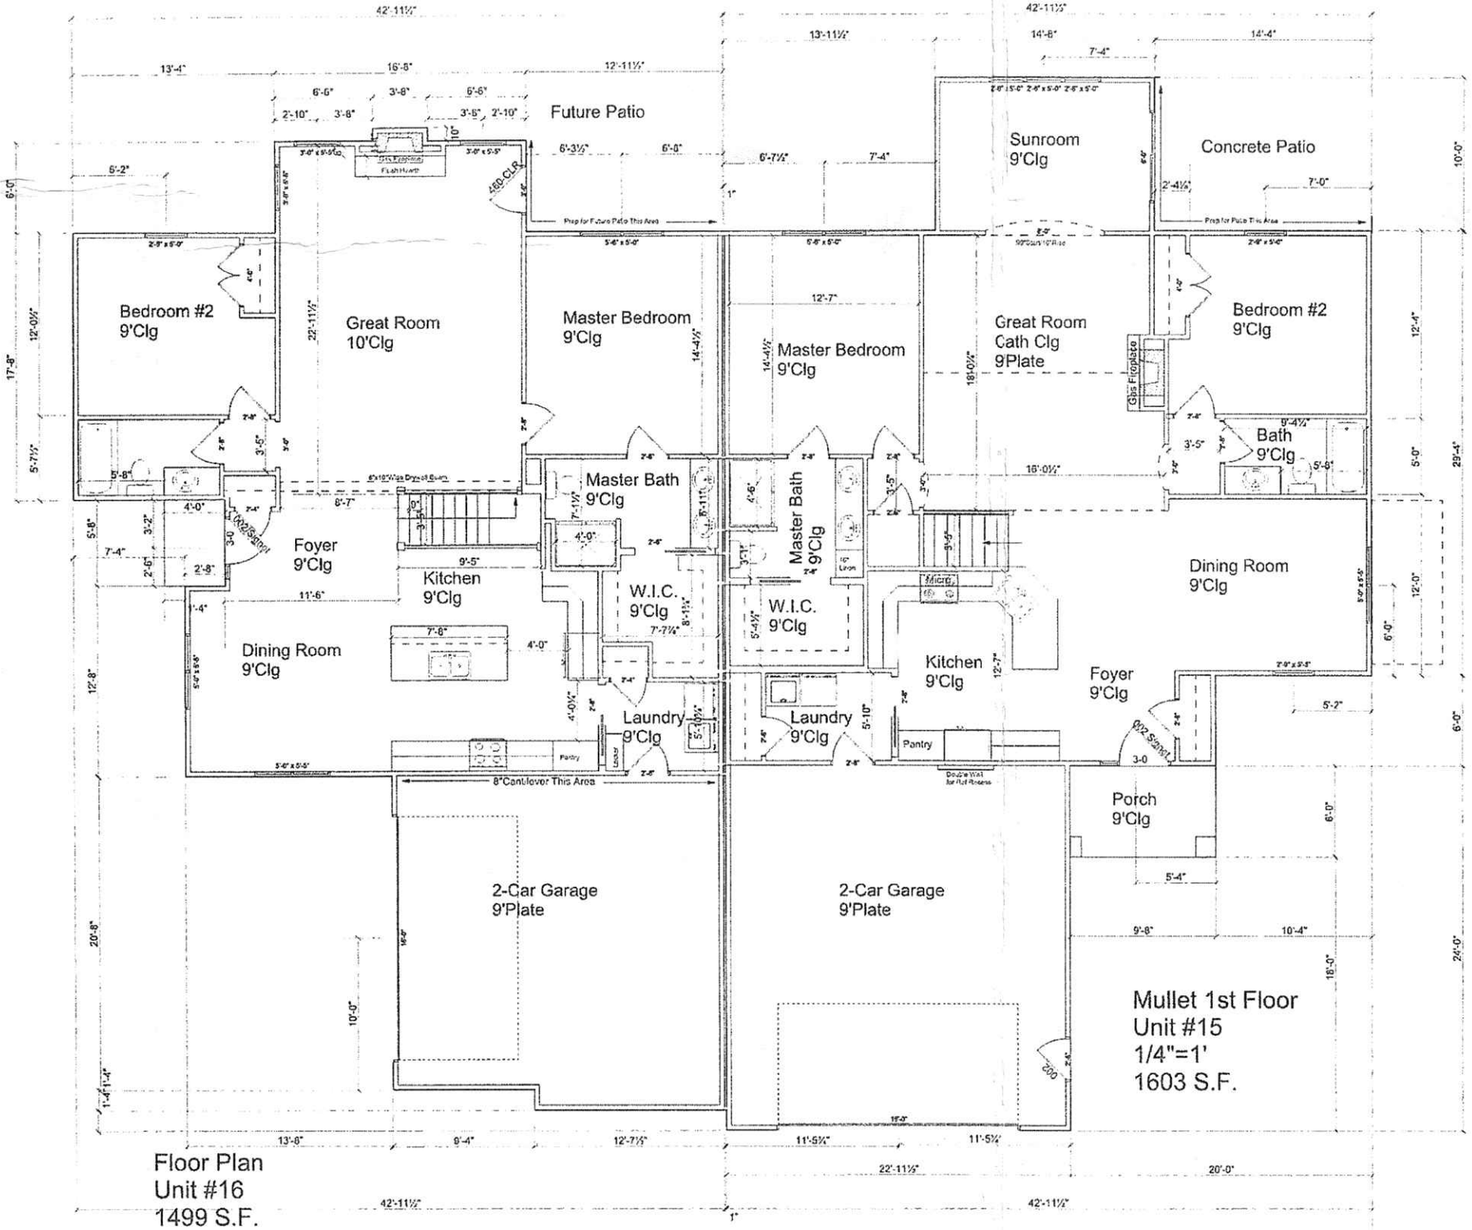

Floor Plan
Unit #16
1499 S.F.
1/4"=1'

TRANSFER NOT NECESSARY
DATE June 30, 2014
AUDITOR Jackie McKee JS

THE BELOW LICENSED PROFESSIONAL ENGINEER CERTIFIES THAT TO THE BEST OF HIS KNOWLEDGE AND BELIEF THIS PLAT GRAPHICALLY SHOWS ALL THE PARTICULARS OF THE BUILDINGS AS CONSTRUCTED.

Harry D. Matter 4/22/14
HARRY D. MATTER, REGISTERED PROFESSIONAL ENGINEER E-040167 DATE

THE BELOW LICENSED PROFESSIONAL SURVEYOR CERTIFIES THAT TO THE BEST OF HIS KNOWLEDGE AND BELIEF THIS PLAT ACCURATELY REFLECTS THE LOCATION OF IMPROVEMENTS AND RECORDED EASEMENTS.

Robert D. Allison 4/22/2014
ROBERT D. ALLISON, REGISTERED PROFESSIONAL SURVEYOR 6589 DATE

STATE OF OHIO
HARRY D. MATTER
E-040167
REGISTERED PROFESSIONAL ENGINEER

STATE OF OHIO
ROBERT DUANE ALLISON
6589
REGISTERED PROFESSIONAL SURVEYOR

THE COVE AT WALNUT CREEK

MILLER-HOPE DEVELOPMENT
WALNUT CREEK, OHIO
44687

NOTES

DATE	5/16/13
1ST FLOOR	SQFT
2ND FLOOR	SQFT
LOWER LEVEL	SQFT
TOTAL	SQFT
GARAGE	SQFT
BONUS	SQFT
DESIGNER	
JOB NO.	

"THE PRINCTON-REVISED"
MILLER-HOPE
WALNUT CREEK, OHIO
44687

SHEET NO.
3 OF 3

Tx:4003910

ABBY PLAN
1" = 10'
LIVING - 1499 SQFT

BUILDING 8, UNIT 16

FIRST FLOOR

SERENITY PLAN
1" = 10'
LIVING - 1603 SQFT

BUILDING 8, UNIT 15

EXHIBIT B-2 Sheet 3