

201400089325

B: 19 P: 2513
FILED FOR RECORD IN
HOLMES COUNTY, OH
ANITA HALL, COUNTY RECORDER
06/30/2014 2:02 PM
SMALL PLAT .40.00
PAGES: 1

ORV 249 page 2084

BUILDING DATA

UNIT NO.	PLAN	LIVING	BASEMENT	TOTAL	GARAGE
15	PRINCETON SERIES, SERENITY	1603 S.F.	1360 S.F.	2963 S.F.	526 S.F.
16	PRINCETON SERIES, ABBY	1499 S.F.	1376 S.F.	2875 S.F.	450 S.F.



Building #8 Front Elevation

BUILDING 8, UNIT 16

FRONT ELEVATION

1" = 10'

BUILDING 8, UNIT 15



Building #8 Rear Elevation

BUILDING 8, UNIT 15

REAR ELEVATION

1" = 10'

BUILDING 8, UNIT 16

TRANSFER NOT NECESSARY



DATE June 30, 2014
AUDITOR Jackie McKeel

THE BELOW LICENSED PROFESSIONAL ENGINEER CERTIFIES THAT TO THE BEST OF HIS KNOWLEDGE AND BELIEF THIS PLAT GRAPHICALLY SHOWS ALL THE PARTICULARS OF THE BUILDINGS AS CONSTRUCTED.

Harry D. Matter
HARRY D. MATTER, REGISTERED PROFESSIONAL ENGINEER E-040167 DATE 4/22/14

THE BELOW LICENSED PROFESSIONAL SURVEYOR CERTIFIES THAT TO THE BEST OF HIS KNOWLEDGE AND BELIEF THIS PLAT ACCURATELY REFLECTS THE LOCATION OF IMPROVEMENTS AND RECORDED EASEMENTS.

Robert D. Allison
ROBERT D. ALLISON, REGISTERED PROFESSIONAL SURVEYOR 6589 DATE 4/22/2014

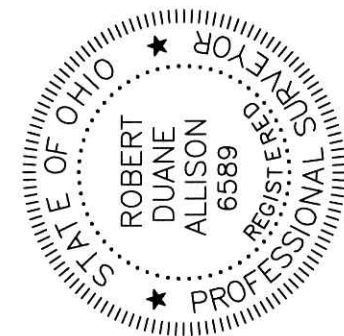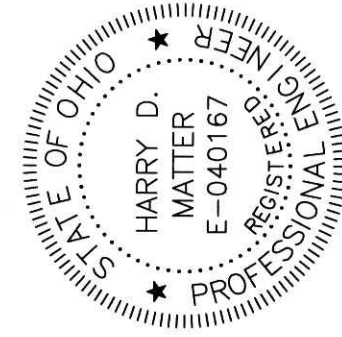

THE COVE AT WALNUT CREEK

MILLER-HOPE DEVELOPMENT
WALNUT CREEK, OHIO
44687

NOTES

DATE	5/16/13
1ST FLOOR	SQFT
2ND FLOOR	SQFT
LOWER LEVEL	SQFT
TOTAL	SQFT
GARAGE	SQFT
BONUS	SQFT
DESIGNER	
JOB NO.	

"THE PRINCETON-REVISED"
MILLER-HOPE
WALNUT CREEK, OHIO
44687

SHEET NO.
1 OF 3

EXHIBIT B-2 Sheet 1

