

SCALE: 1"=200'

- ▲ R.R. SPIKE FOUND
- 5/8" REBAR FOUND UNLESS OTHERWISE NOTED
- 5/8" REBAR SET WITH I.D. CAP I.D. CAP MARKED "BAKER 6938"

BERLIN TOWNSHIP  
3RD. QTR., LOTS 13 & 14  
T-9 N; R-5 W  
HOLMES COUNTY, OHIO

SURVEYED FOR: DEAN WEAVER

REFERENCES

O.R. VOL. 185 PAGE 2587  
O.R. VOL. 217 PAGE 974  
PLAT VOL. 19 PAGE 581  
BEARINGS FROM PLAT VOL. 19 PAGE 581

201400090353

B: 19 P: 2553

FILED FOR RECORD IN  
HOLMES COUNTY, OH  
ANITA HALL, COUNTY RECORDER  
09/09/2014 12:42 PM  
SMALL PLAT . 40.00

PAGES: 1


ORV 250 PG 56

APPROVED FOR TRANSFER ONLY  
NO SUBDIVISION PLAT REQUIRED

(O.R.C. 711.001 & 711.131)  
Lot(s) not for building unless  
approved by Board of Health.

HOLMES CO. PLANNING COMMISSION

By AP Date 8/27/14

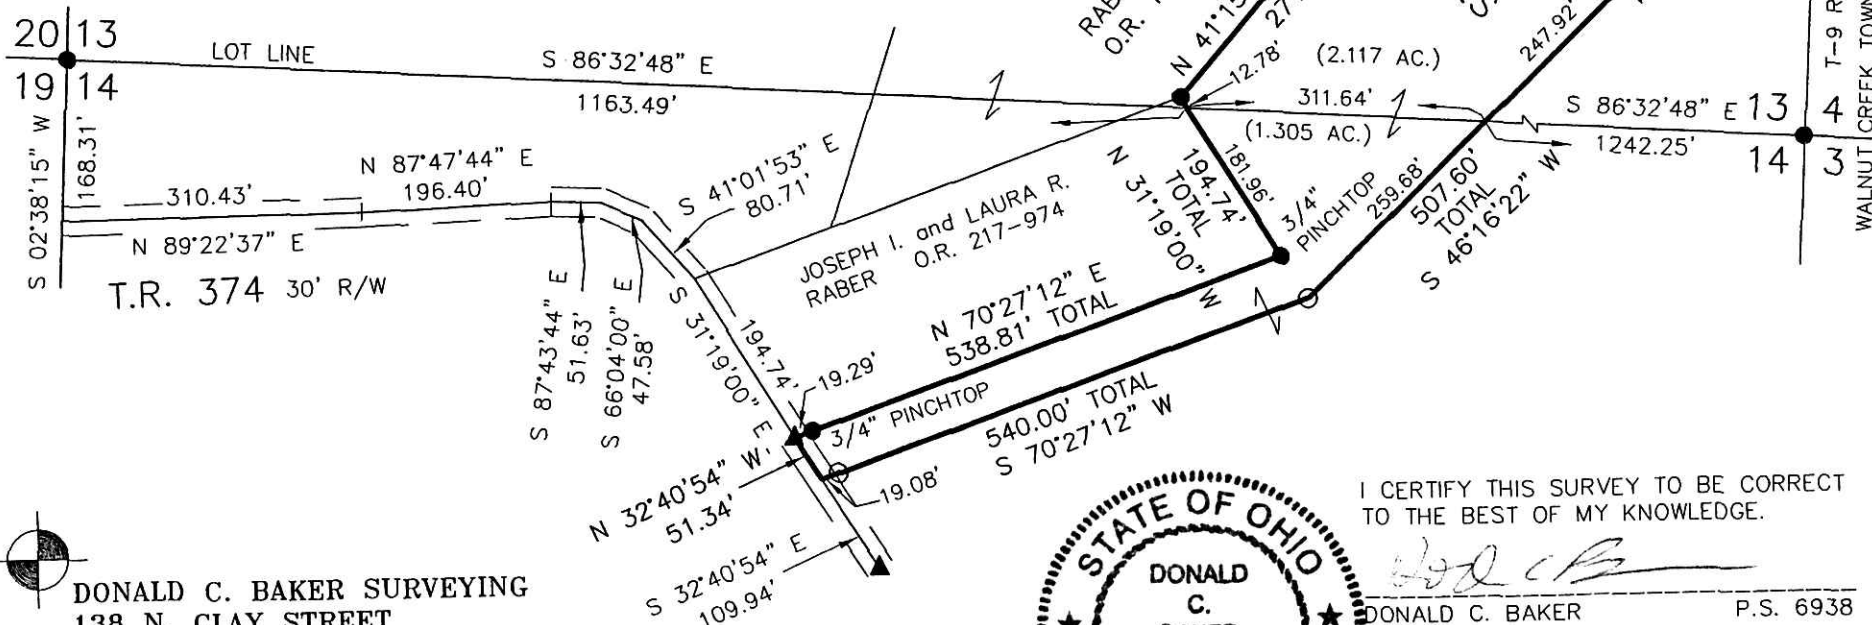

DONALD C. BAKER SURVEYING  
138 N. CLAY STREET  
MILLERSBURG, OHIO 44654  
PH. 330-674-4788  
FAX 330-674-6027  
EMAIL: [bakersurveying@gmail.com](mailto:bakersurveying@gmail.com)



I CERTIFY THIS SURVEY TO BE CORRECT  
TO THE BEST OF MY KNOWLEDGE.

Donald C. Baker  
DONALD C. BAKER P.S. 6938  
DATE: APRIL 3, 2014  
FDB/KES  
FILE NAME: WORK5\S-123-14\MLD

PLAT APPROVED

8/15/2014

T-9 R-5 3RD. QTR.  
WALNUT CREEK TOWNSHIP

