

RESURVEY OF DEED
VOL. 254 PAGE 54

PAINT TOWNSHIP
3RD. QTR., LOT 33
T-10 N; R-4 W
PAINT TOWNSHIP
4TH. QTR., LOT 1
T-10 N; R-5 W

WALNUT CREEK TOWNSHIP
N.W. QTR. SECTION 5
T-9 N; R-4 W
HOLMES COUNTY, OHIO


SURVEYED FOR: MOSE MILLER

REFERENCES

DEED VOL. 254 PAGE 54
O.R. VOL. 60 PAGE 726
O.R. VOL. 188 PAGE 688

PLAT VOL. 7 PAGE 694
PLAT VOL. 7 PAGE 698
PLAT VOL. 10 PAGE 467
PLAT VOL. 15 PAGE 46
PLAT VOL. 15 PAGE 136
PLAT VOL. 19 PAGE 681
PLAT VOL. 19 PAGE 1641

BEARINGS FROM
PLAT VOL. 19 PAGE 681

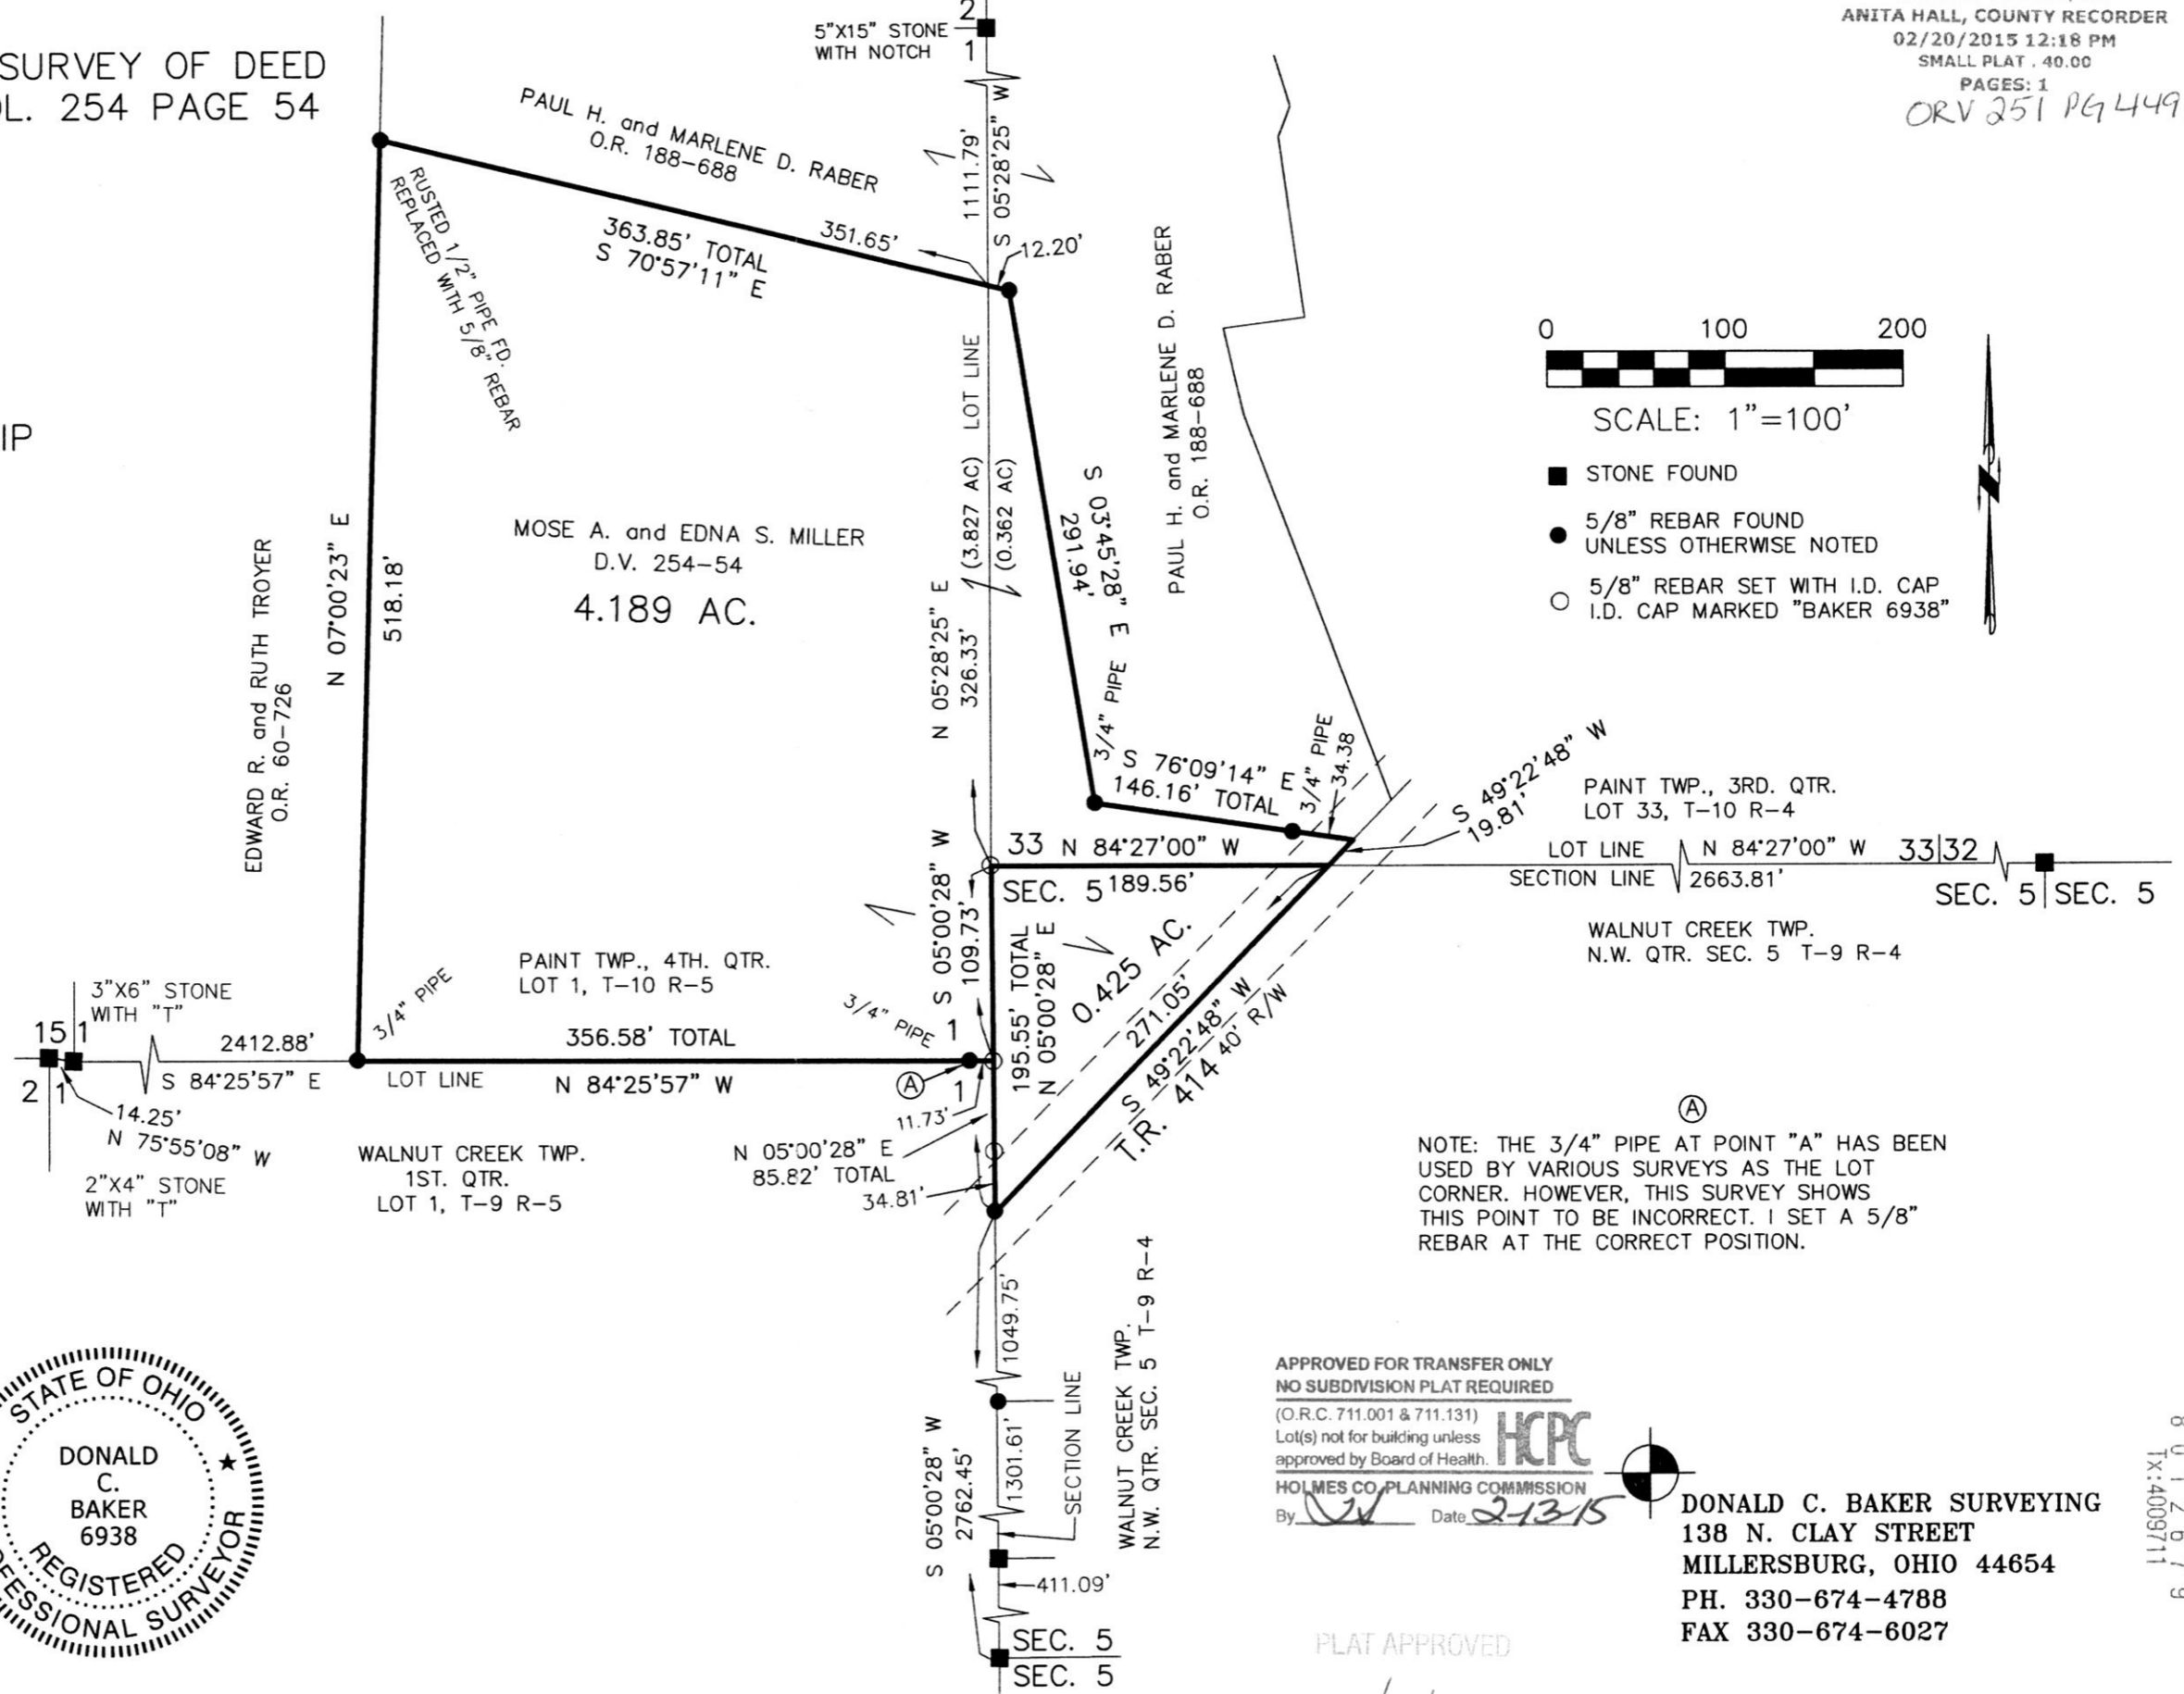

SCALE: 1"=100'

- STONE FOUND
- 5/8" REBAR FOUND UNLESS OTHERWISE NOTED
- 5/8" REBAR SET WITH I.D. CAP I.D. CAP MARKED "BAKER 6938"

NOTE: THE 3/4" PIPE AT POINT "A" HAS BEEN USED BY VARIOUS SURVEYS AS THE LOT CORNER. HOWEVER, THIS SURVEY SHOWS THIS POINT TO BE INCORRECT. I SET A 5/8" REBAR AT THE CORRECT POSITION.

APPROVED FOR TRANSFER ONLY
NO SUBDIVISION PLAT REQUIRED
(O.R.C. 711.001 & 711.131)
Lot(s) not for building unless approved by Board of Health.
HCP
HOLMES CO. PLANNING COMMISSION
By: [Signature] Date: 2-13-15

DONALD C. BAKER SURVEYING
138 N. CLAY STREET
MILLERSBURG, OHIO 44654
PH. 330-674-4788
FAX 330-674-6027

I CERTIFY THIS SURVEY TO BE CORRECT TO THE BEST OF MY KNOWLEDGE.
[Signature]
DONALD C. BAKER P.S. 6938
DATE: JAN. 23, 2015
FDB/KES
FILE NAME: WORK4\S-27-15



PLAT APPROVED

2/18/2015

