



EXHIBIT B-2


201500092709  
 B: 19 P: 2666  
 FILED FOR RECORD IN  
 HOLMES COUNTY, OH  
 ANITA HALL, COUNTY RECORDER  
 02/24/2015 3:44 PM  
 PLAT MED. 43.20  
 PAGES: 1  
 OR 251 Pg 4755

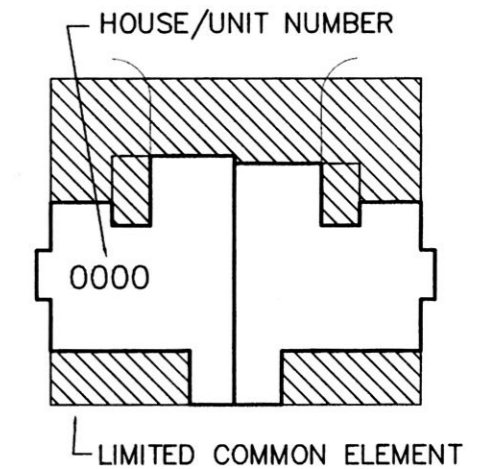

LOT 1052 15.605 AC.  
 - PHASE 1 0.905 AC.  
 - PHASE 2 0.319 AC.  
 - PHASE 3 0.295 AC.  
 - PHASE 4 0.309 AC.  
 RESIDUE 13.777 AC.

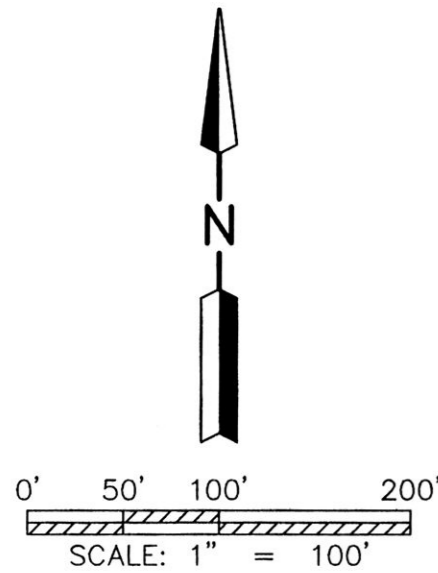

- ✕ SPIKE FOUND
- CAPPED PIN FOUND (SHAMP)

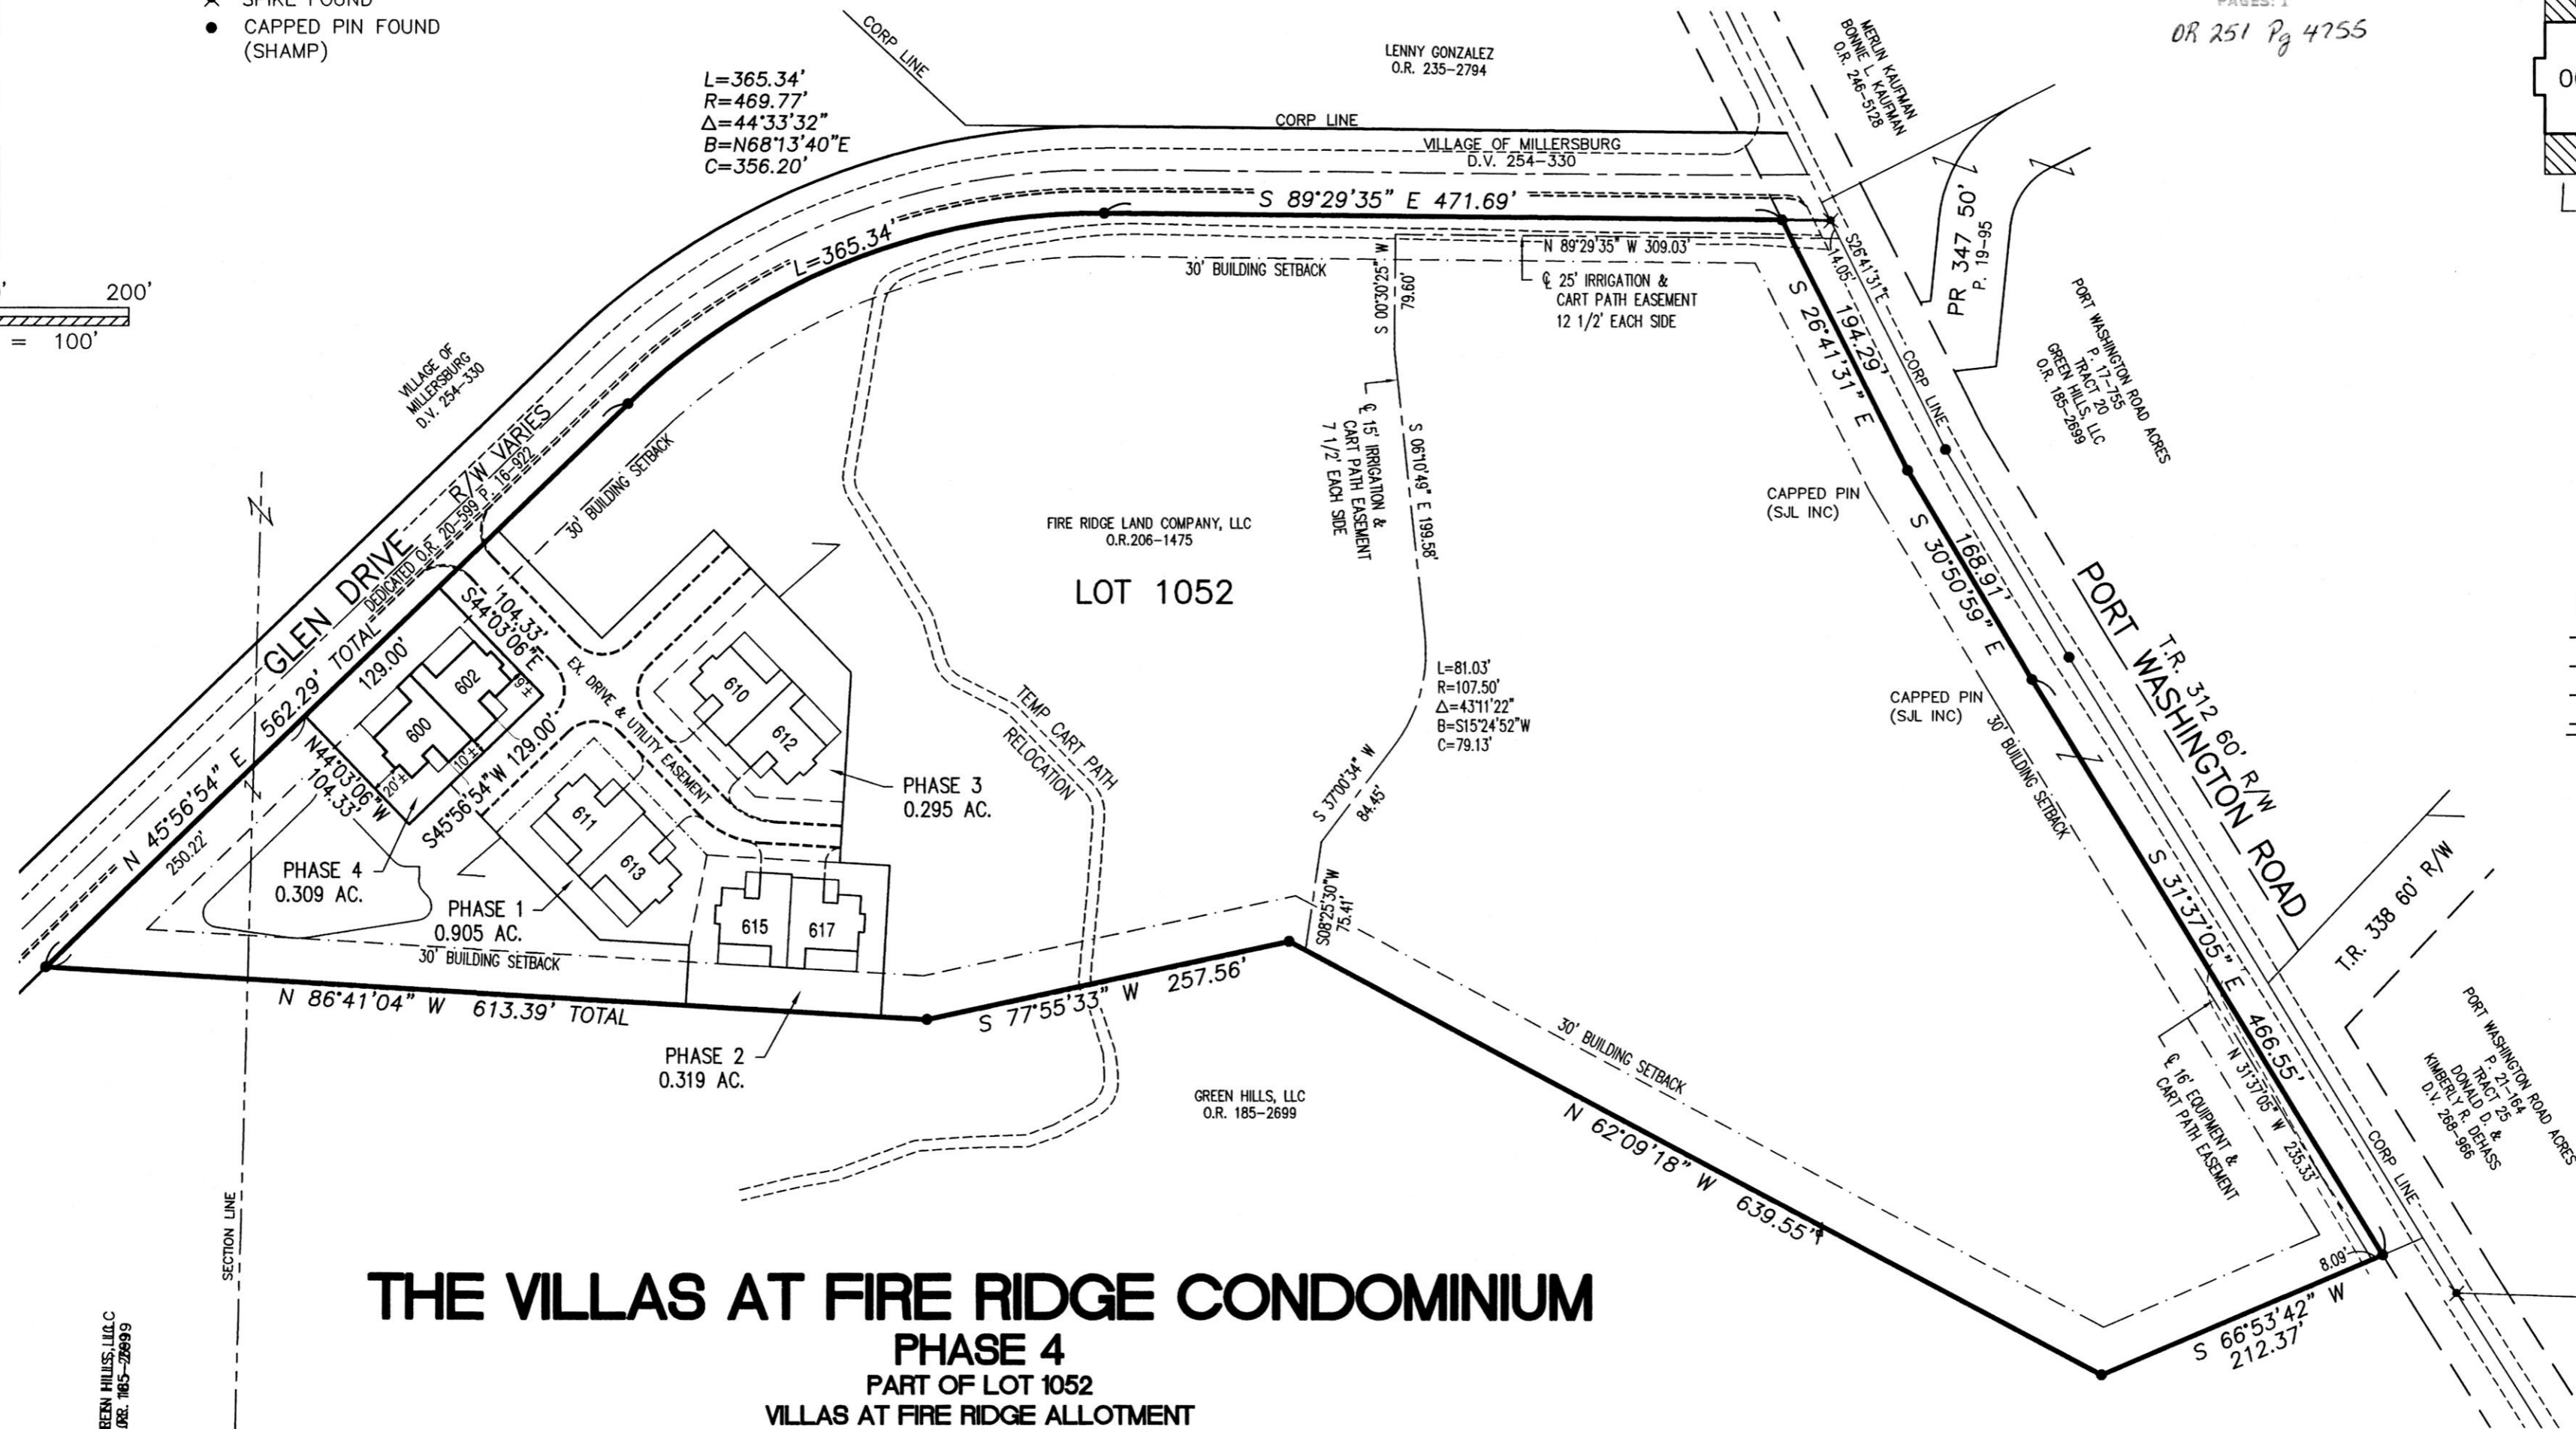

**THE VILLAS AT FIRE RIDGE CONDOMINIUM**  
**PHASE 4**  
 PART OF LOT 1052  
 VILLAS AT FIRE RIDGE ALLOTMENT  
 PLAT VOL. 19: PG. 1665  
**VILLAGE OF MILLERSBURG**  
 HOLMES COUNTY, OHIO

GREEN HILLS, LLC  
 O.R. 185-2699

19 20  
 19 20

LEGEND

UNIT	PLAN	LIVING	BASEM'T	GARAGE	TOTALS
600	BARRINGTON	1694 SF.	1694 SF.	572 SF.	3960 SF.
602	BARRINGTON	1694 SF.	1694 SF.	528 SF.	3960 SF.

REFERENCE SURVEY  
 Survey of a 16.172 AC. parcel by Jim Shamp of Heartland Surveying, Inc.

SURVEYOR'S DECLARATION: I declare that this plan was prepared from an actual survey. That the same shows graphically, insofar as possible, the location of the boundaries, the layout, location and dimensions of units and of the buildings, the location and layout of limited common elements, the location and layout of common elements, and the location of appurtenant easements, if any.



ENGINEER'S DECLARATION: I declare that this plan was prepared from an actual survey. That the same shows graphically, insofar as possible, the location of the boundaries, the layout, location and dimensions of units and of the buildings, the location and layout of limited common elements, the location and layout of common elements, and the location of appurtenant easements, if any.



TRANSFER NOT NECESSARY  
 DATE February 24 2015  
 AUDITOR [Signature]

Village of Millersburg  
 LOT SPLIT APPROVED  
 FOR TRANSFER TO ADJOINER ONLY  
 By: [Signature]  
 On: 1-21-2015

[Signature]  
 Mark E. Purdy, P.S. 7307  
 11-6-14  
 Date

John A. Long, P.E. 67239  
 11-5-14  
 Date

**SHAFFER, JOHNSTON, LICHTENWALTER & ASSOCIATES, INC.**  
 Consulting Engineers & Surveyors  
 3477 Commerce Parkway, Suite C  
 Wooster, Ohio 44691  
 TEL (330) 345-6377 FAX (330) 345-6725 EMAIL sjl@sjl-inc.com

DRAWN C. Feb	CHECKED	1" SCALE = 100'	DATE 10/31/14
DWG NO: EW-2332BD	JOB NO: EW-2332BD	SHEET 2 OF 3	