

201500092868

B: 19 P: 2673

FILED FOR RECORD IN
HOLMES COUNTY, OH
ANITA HALL, COUNTY RECORDER
03/10/2015 2:28 PM
SMALL PLAT . 40.00
PAGES: 1

ORV 251
P5627

8 9
13 12

0 200 400



SCALE: 1"=200'

- STONE FOUND
- ▲ R.R. SPIKE FOUND
- 5/8" REBAR FOUND
UNLESS OTHERWISE NOTED
- 5/8" REBAR SET WITH I.D. CAP
I.D. CAP MARKED "BAKER 6938"

REFERENCES

- O.R. VOL. 248 PAGE 1479
- PLAT VOL. 18 PAGE 594
- PLAT VOL. 18 PAGE 797
- PLAT VOL. 19 PAGE 1160
- PLAT VOL. 19 PAGE 2538
- BEARINGS FROM
PLAT VOL. 18 PAGE 797



I CERTIFY THIS SURVEY TO BE CORRECT
TO THE BEST OF MY KNOWLEDGE.

Donald C. Baker

DONALD C. BAKER P.S. 6938


DATE: DEC. 2, 2014

KES\CJG

FILE NAME: WORK5\S-528-14

TX: 4009886

8 0 1 2 9 8

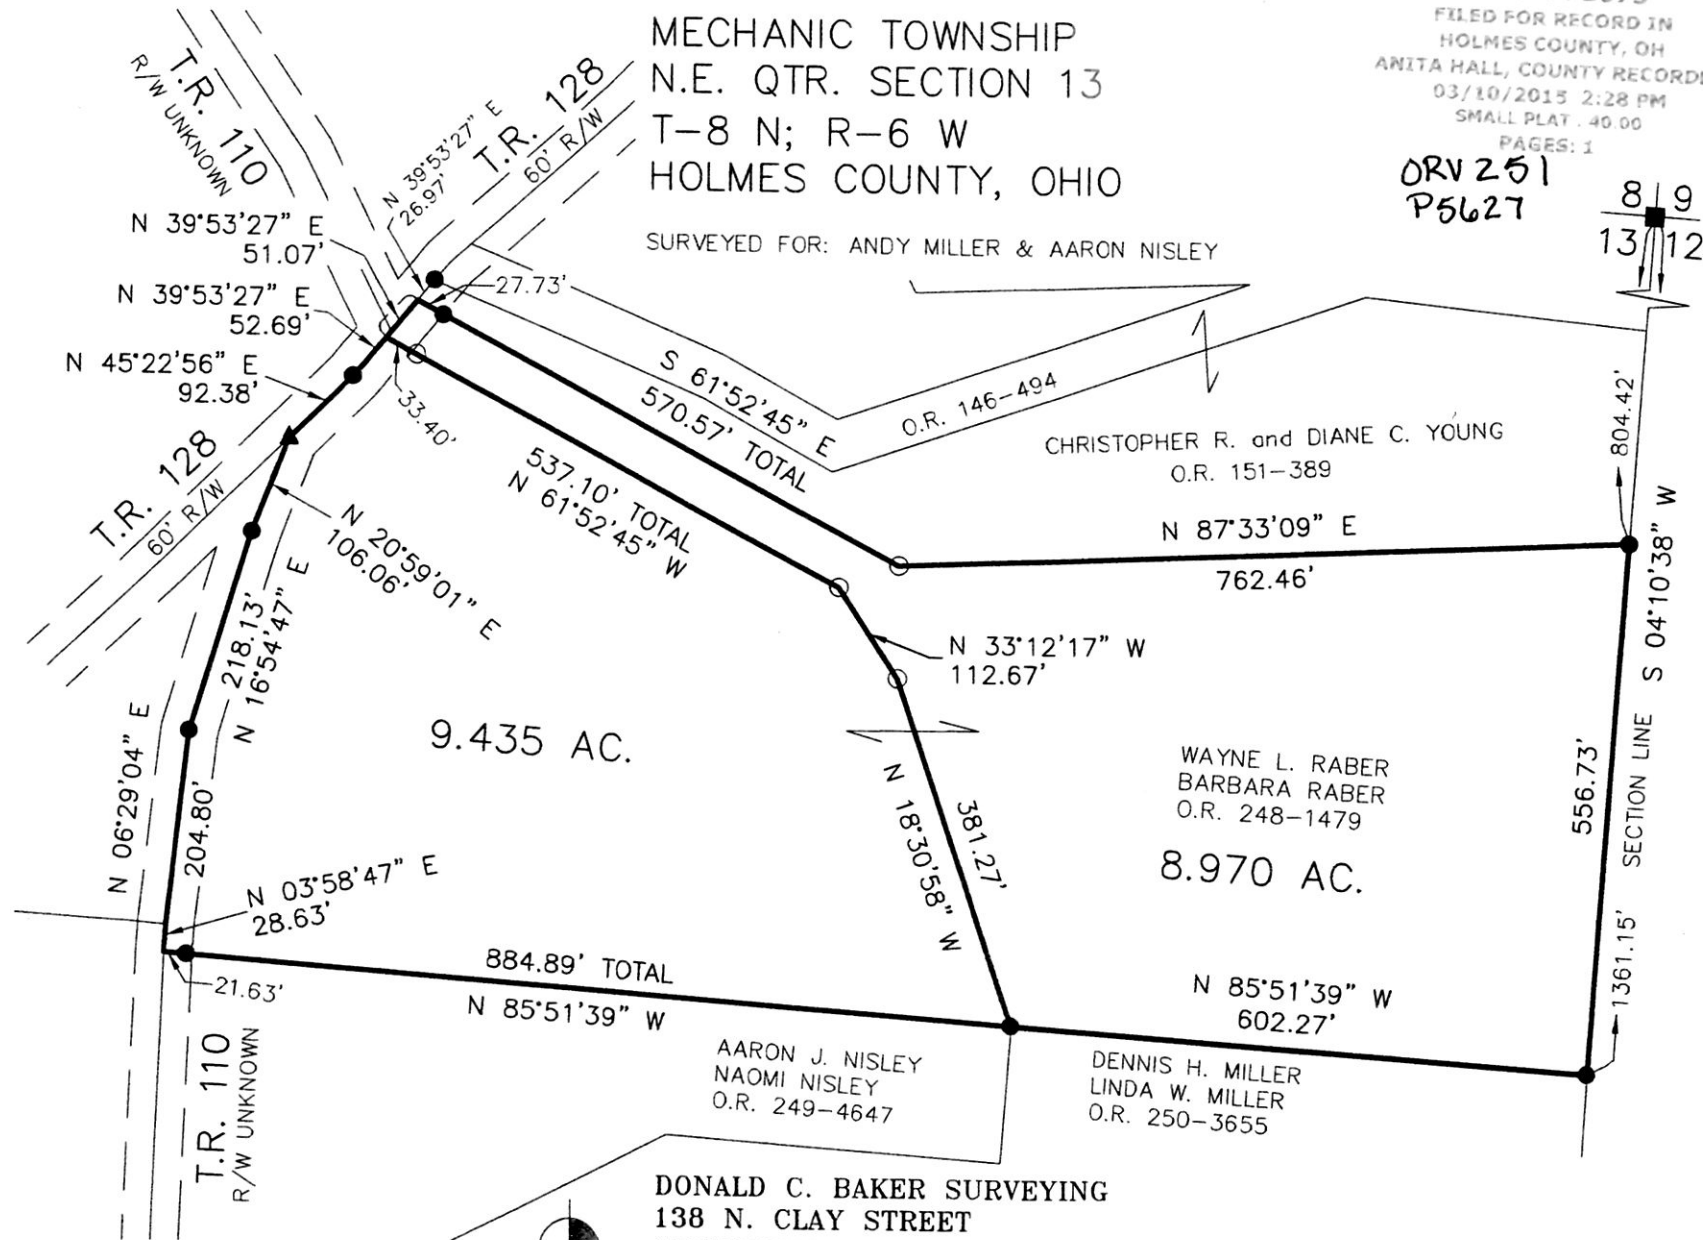

DONALD C. BAKER SURVEYING
138 N. CLAY STREET
MILLERSBURG, OHIO 44654
PH. 330-674-4788
FAX 330-674-6027
EMAIL: bakersurveying@gmail.com

PLAT APPROVED

2/4/2015