


CLARK TOWNSHIP
 N.W. QTR. SECTION 23
 T-8 N; R-5 W
 HOLMES COUNTY, OHIO
 SURVEYED FOR: ARLEN STUTZMAN


201500094673
 B: 19 P: 2768
 FILED FOR RECORD IN
 HOLMES COUNTY, OH
 ANITA HALL, COUNTY RECORDER
 07/16/2015 11:03 AM
 SMALL PLAT . 40.00
 PAGES: 1

APPROVED FOR TRANSFER ONLY
 NO SUBDIVISION PLAT REQUIRED
 (O.R.C. 711.001 & 711.131)
 Lot(s) not for building unless
 approved by Board of Health. **HCP**
 HOLMES CO. PLANNING COMMISSION
 By JL Date 7-2-15

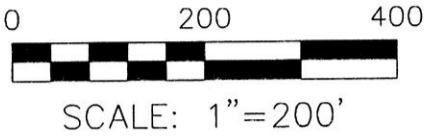

- STONE FOUND
- 5/8" REBAR FOUND UNLESS OTHERWISE NOTED
- 5/8" REBAR SET WITH I.D. CAP I.D. CAP MARKED "BAKER 6938"

REFERENCES
 DEED VOL. 207 PAGE 530
 O.R. VOL. 49 PAGE 392
 PLAT VOL. 16 PAGE 394
 BEARINGS FROM PLAT VOL. 16 PAGE 394

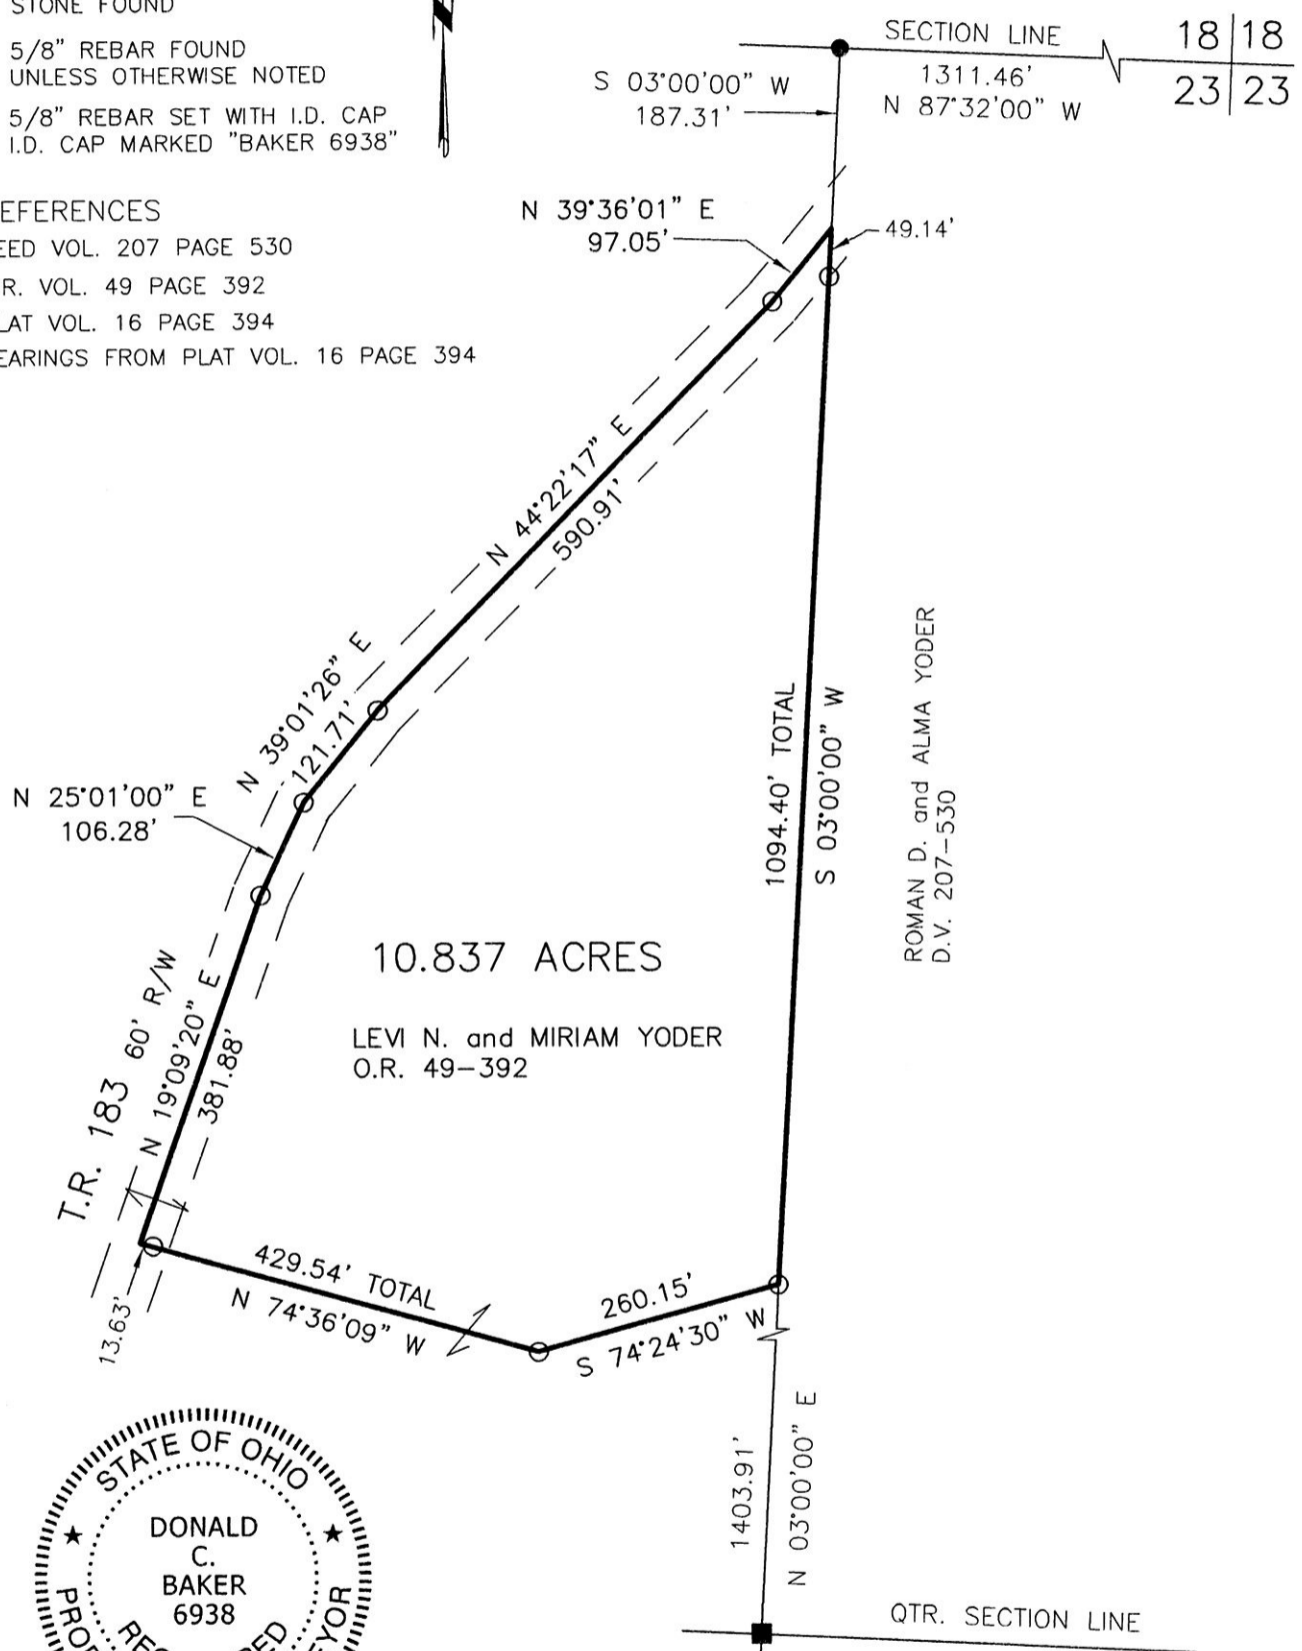

I CERTIFY THIS SURVEY TO BE CORRECT TO THE BEST OF MY KNOWLEDGE.
Donald C. Baker
 DONALD C. BAKER P.S. 6938
 DATE: JUNE 18, 2015

DONALD C. BAKER SURVEYING
 138 N. CLAY STREET
 MILLERSBURG, OHIO 44654
 PH. 330-674-4788
 FAX 330-674-6027
 EMAIL: bakersurveying@gmail.com

FDB\GIG
 FILE NAME: WORKS\S-292-15\MLD

PLAT APPROVED
7/2/2015