


VILLAGE OF MILLERSBURG
 PART OF OUTLOT 4
 T-9 N; R-7 W
 SECTION 12
 HOLMES COUNTY, OHIO

201500095795
 B: 19 P: 2817
 FILED FOR RECORD IN
 HOLMES COUNTY, OH
 ANITA HALL, COUNTY RECORDER
 09/14/2015 2:33 PM
 SMALL PLAT . 40.00
 PAGES: 1
 DRV 253 P5311

SURVEYED FOR: STEVE EILER

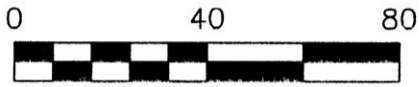


SCALE: 1"=40'

● 5/8" REBAR FOUND
 UNLESS OTHERWISE NOTED

REFERENCES

DEED VOL. 201 PAGE 343
 O.R. VOL. 181 PAGE 3173
 PLAT VOL. 19 PAGE 389
 BEARINGS FROM PLAT VOL. 19 PAGE 389

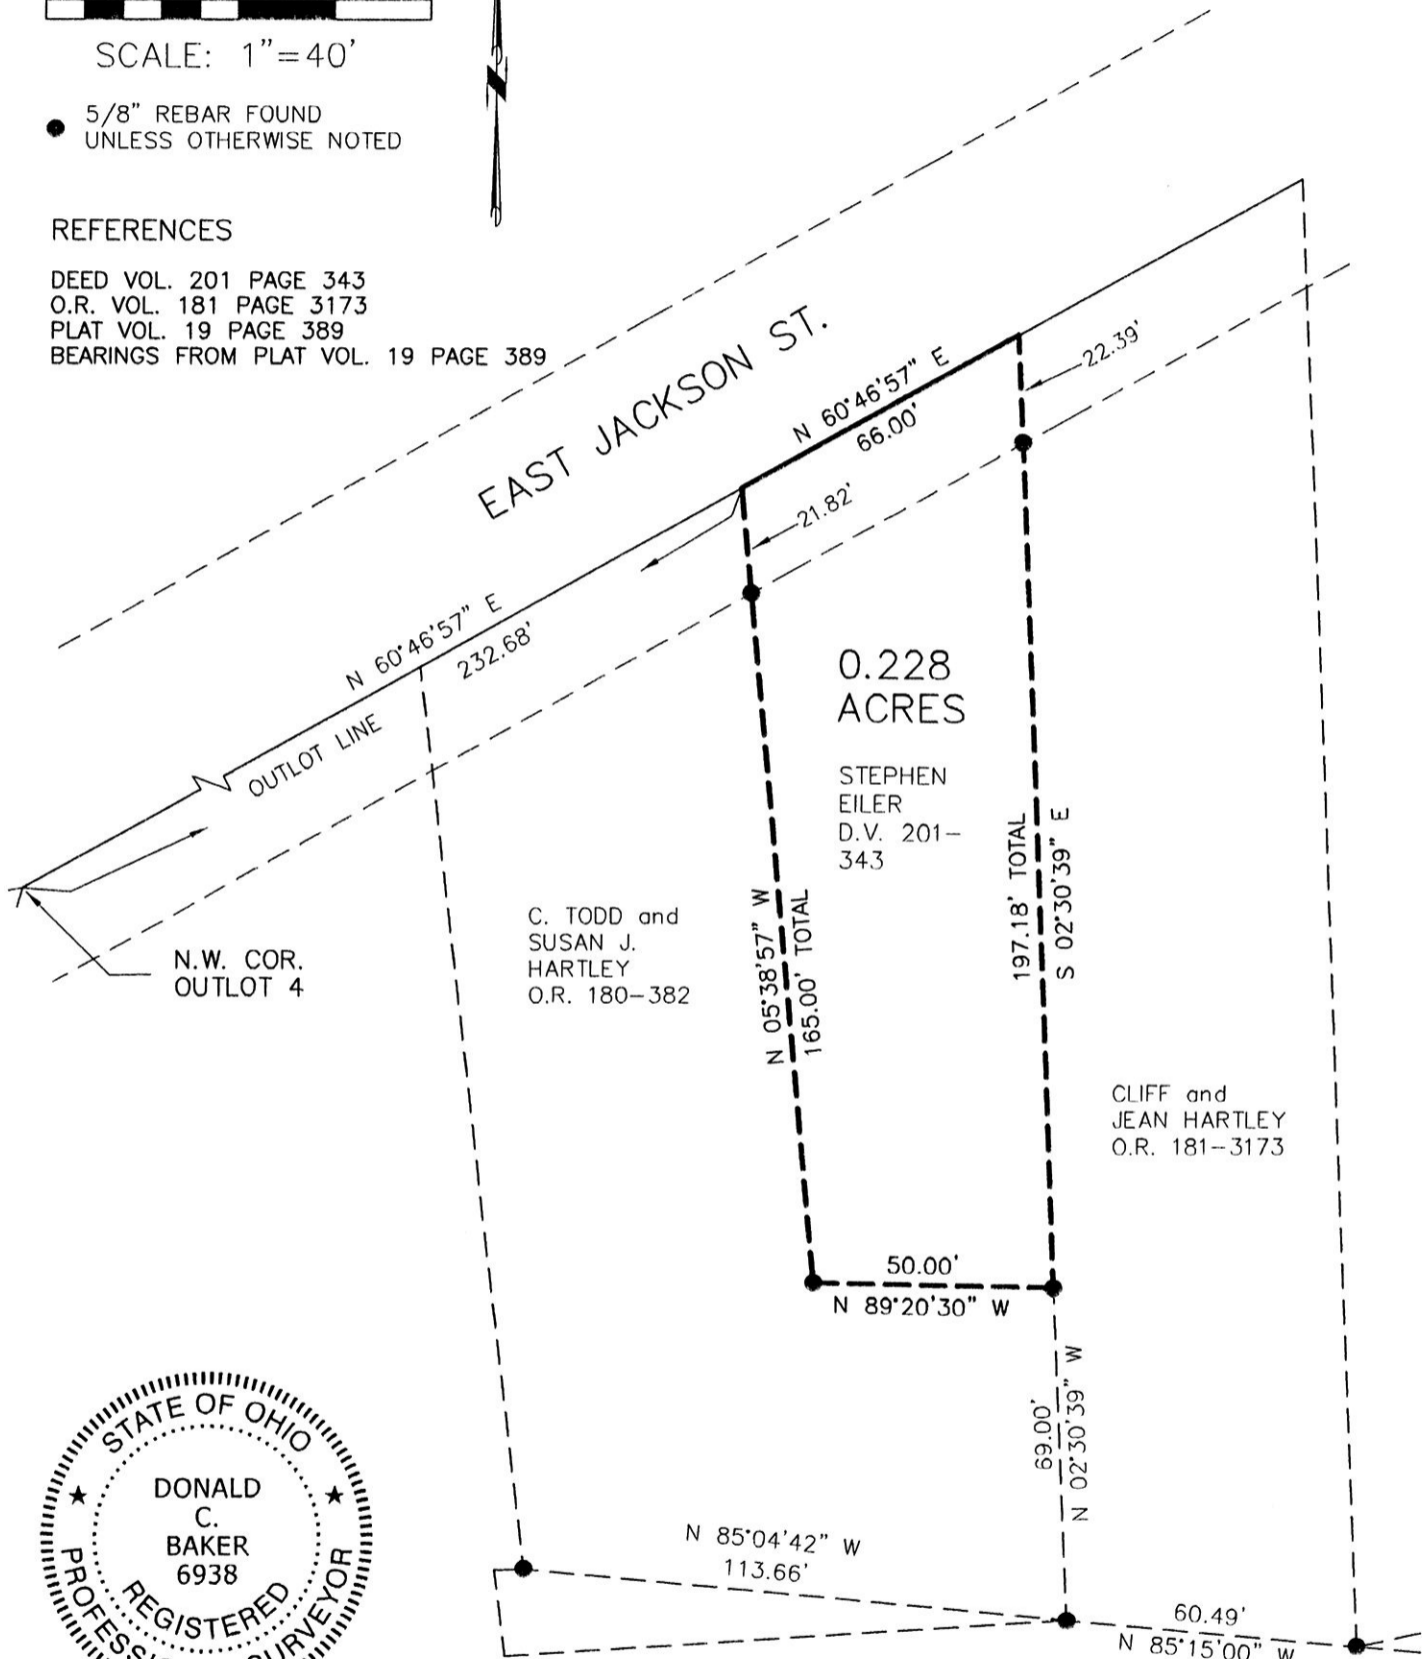

I CERTIFY THIS SURVEY TO BE CORRECT
 TO THE BEST OF MY KNOWLEDGE.

Donald C. Baker

DONALD C. BAKER P.S. 6938

DATE: SEPTEMBER 3, 2015

CJG\JNG

FILE NAME: WORK4\S-480-15\MLD

TX:4012171

8016337



DONALD C. BAKER SURVEYING
 138 N. CLAY STREET
 MILLERSBURG, OHIO 44654
 PH. 330-674-4788
 FAX 330-674-6027

PLAT APPROVED

9/14/15