



- ✕ SPIKE FOUND
- CAPPED PIN FOUND (SHAMP)

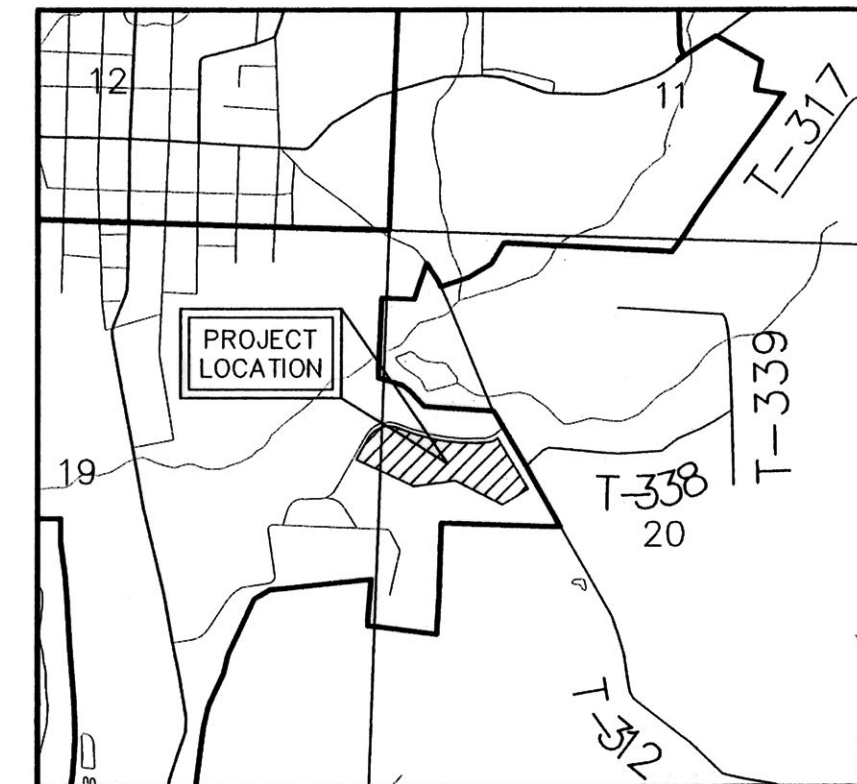


LOCATION MAP

201500096128  
 B: 19 P: 2827  
 FILED FOR RECORD IN  
 HOLMES COUNTY, OH  
 ANITA HALL, COUNTY RECORDER  
 10/05/2015 3:27 PM  
 PLAT MED. 43.26  
 PAGES: 1  
 ORV 253 P4 7017

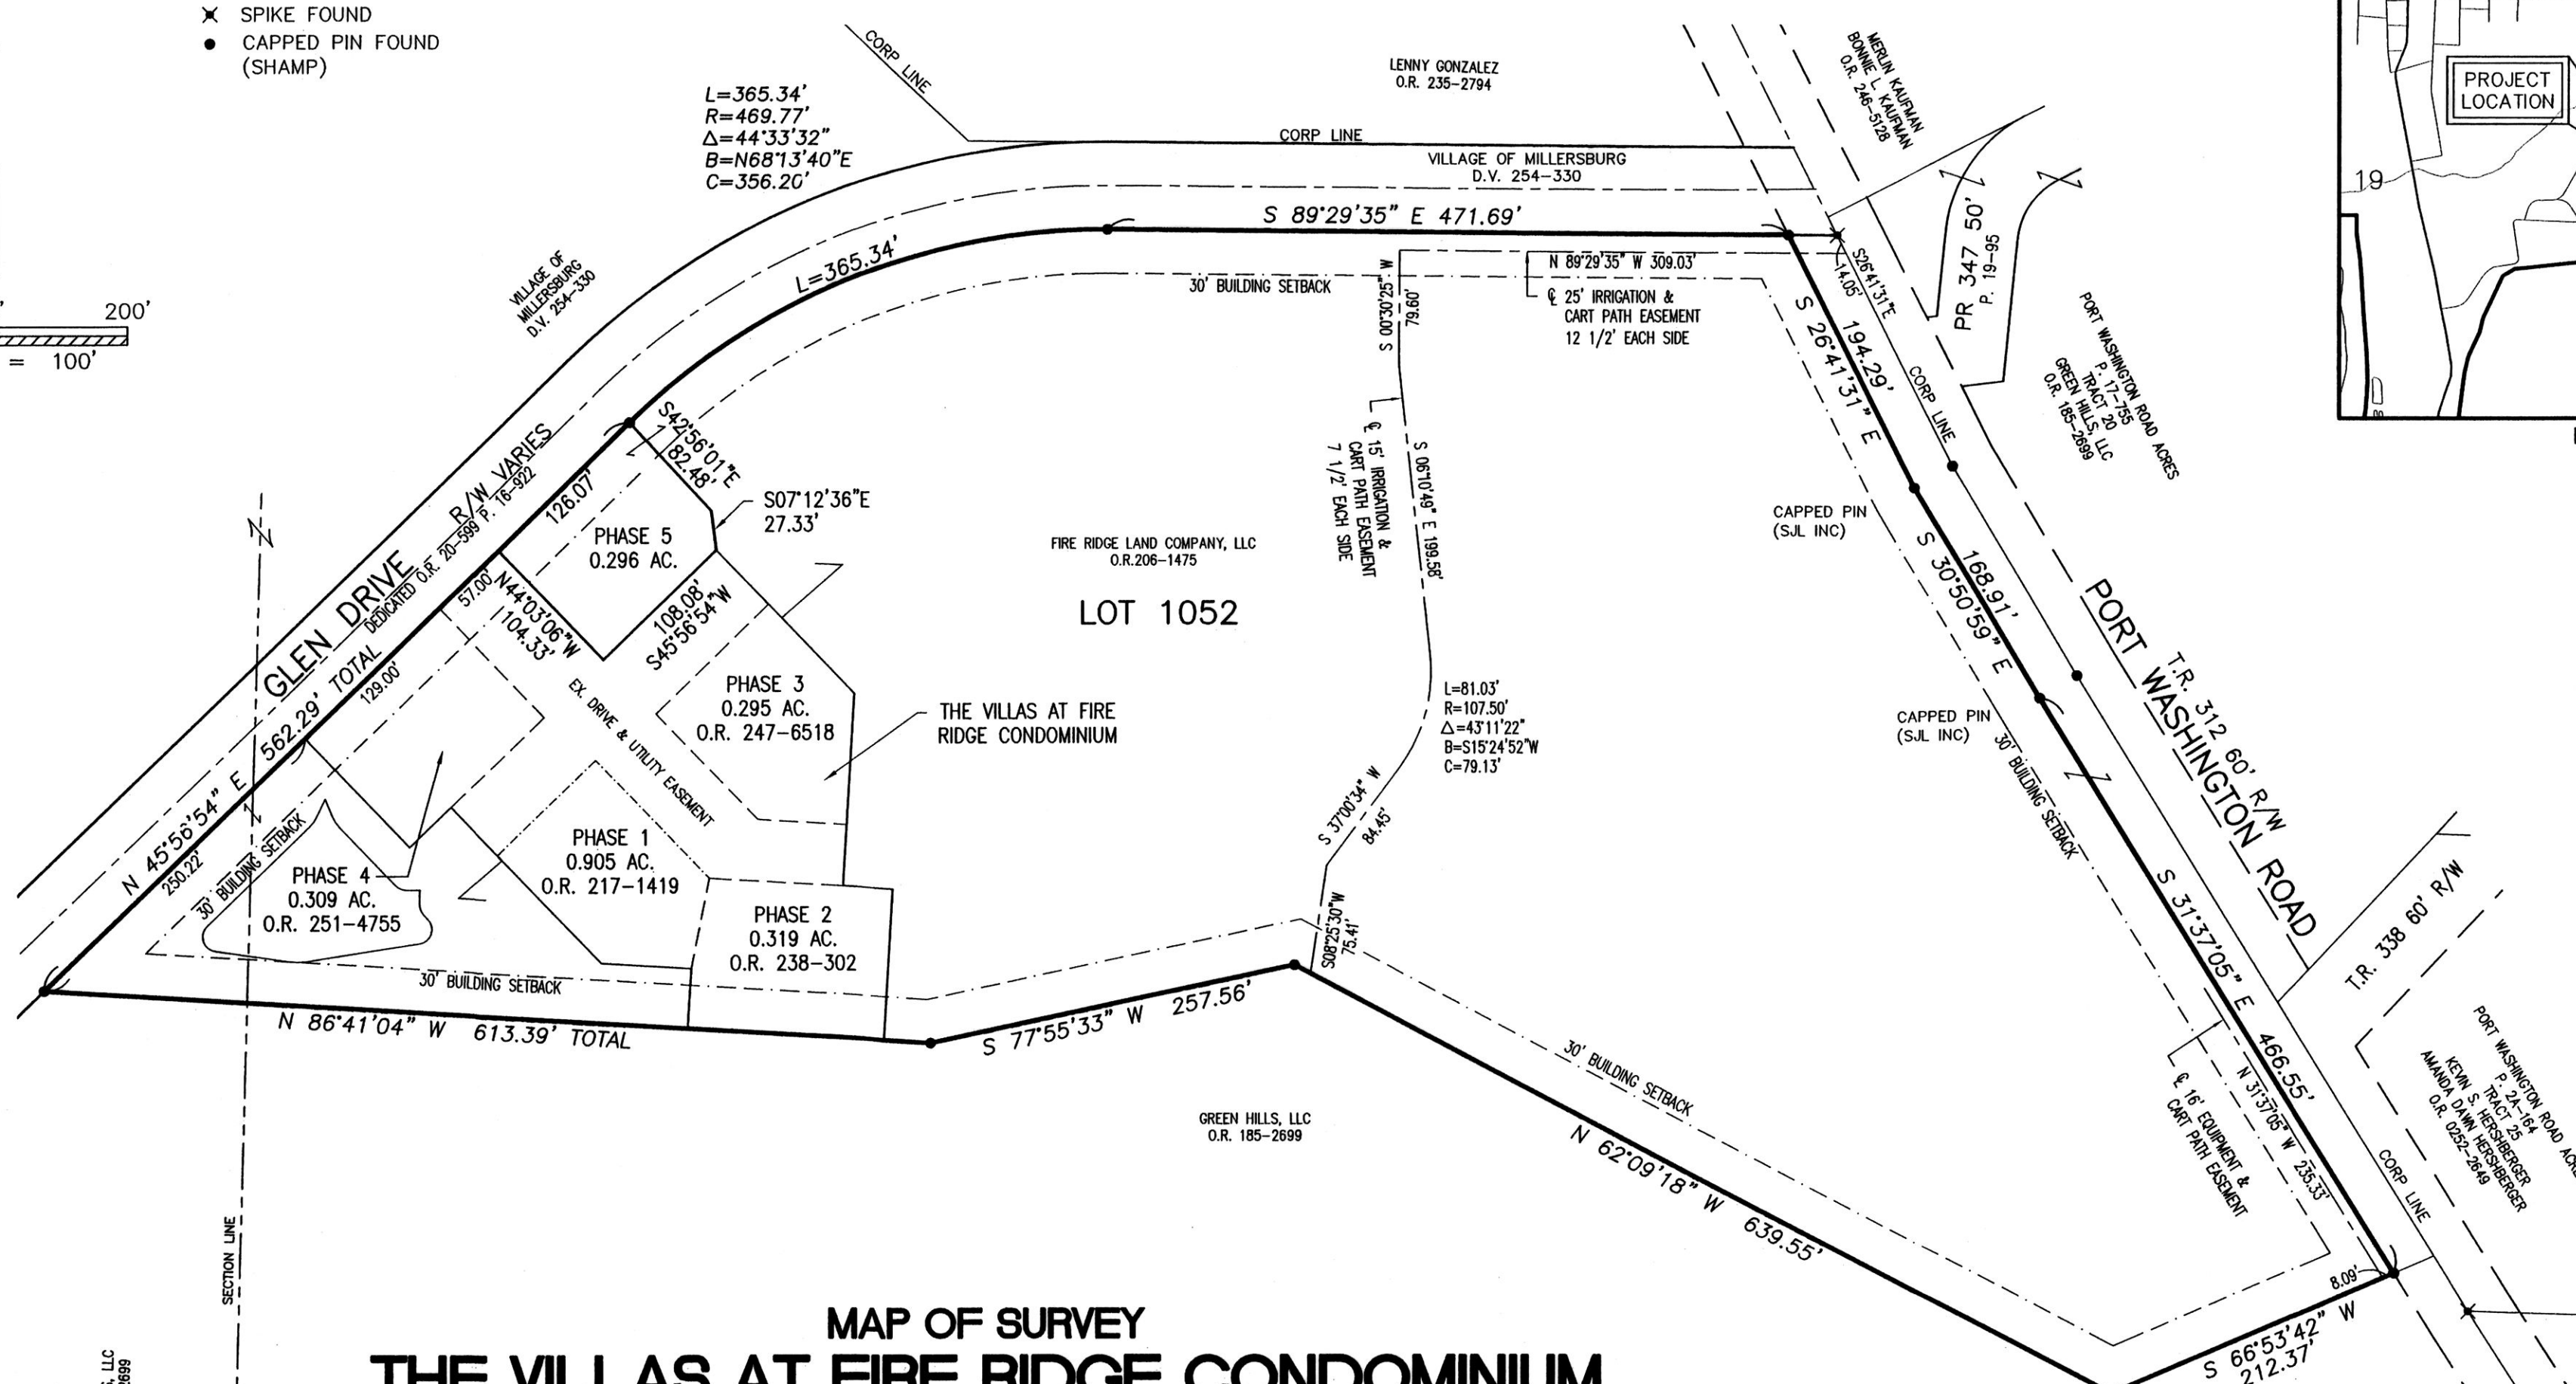

**MAP OF SURVEY**  
**THE VILLAS AT FIRE RIDGE CONDOMINIUM**  
**PHASE 5**  
 PART OF LOT 1052  
 VILLAS AT FIRE RIDGE ALLOTMENT  
 PLAT VOL 19, PG. 1665  
**VILLAGE OF MILLERSBURG**  
 HOLMES COUNTY, OHIO

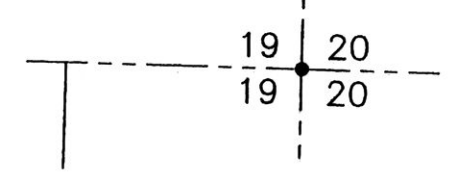

REFERENCE SURVEY  
 Survey of a 16.172 AC. parcel by Jim Shamp of Heartland Surveying, Inc.

**TRANSFER NOT NECESSARY**  
 DATE October 5, 2015  
 AUDITOR [Signature]

SURVEYOR'S DECLARATION: I declare that this plan was prepared from an actual survey. That the same shows graphically, insofar as possible, the location of the boundaries, the layout, location and dimensions of units and of the buildings, the location and layout of limited common elements, the location and layout of common elements, and the location of appurtenant easements, if any.



[Signature]  
 Mark E. Purdy, P.S. 7307  
 Date 6-30-15

	SHAFFER, JOHNSTON, LICHTENWALTER & ASSOCIATES, INC. Consulting Engineers & Surveyors 3477 Commerce Parkway, Suite C Wooster, Ohio 44691 TEL (330) 345-6377 FAX (330) 345-6725 EMAIL sjl@sjl-inc.com			
	DRAWN C. Falb	CHECKED	1" SCALE = 100'	DATE 06/30/15
DWG NO: EW-2332BE		JOB NO: EW-2332BE		SHEET 1 OF 3