


ORV 254 Pg 580

WALNUT CREEK TOWNSHIP
 1ST. QTR., LOT 1
 T-9 N; R-5 W
 HOLMES COUNTY, OHIO

SURVEYED FOR: STEVE MAAG

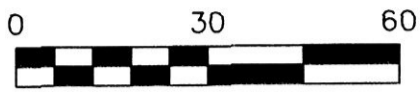


SCALE: 1" = 30'

- 5/8" REBAR FOUND UNLESS OTHERWISE NOTED
- 5/8" REBAR SET WITH I.D. CAP I.D. CAP MARKED "BAKER 6938"

REFERENCES

- DEED VOL. 204 PAGE 512
- DEED VOL. 189 PAGE 71
- O.R. VOL. 252 PAGE 912
- O.R. VOL. 243 PAGE 272
- PLAT VOL. 12 PAGE 27
- PLAT VOL. 10 PAGE 277
- BEARINGS FROM PLAT VOL. 18 PAGE 124

PAINT TWP. T-10 R-5
 WALNUT CREEK TWP. T-9 R-5
 LOT 1

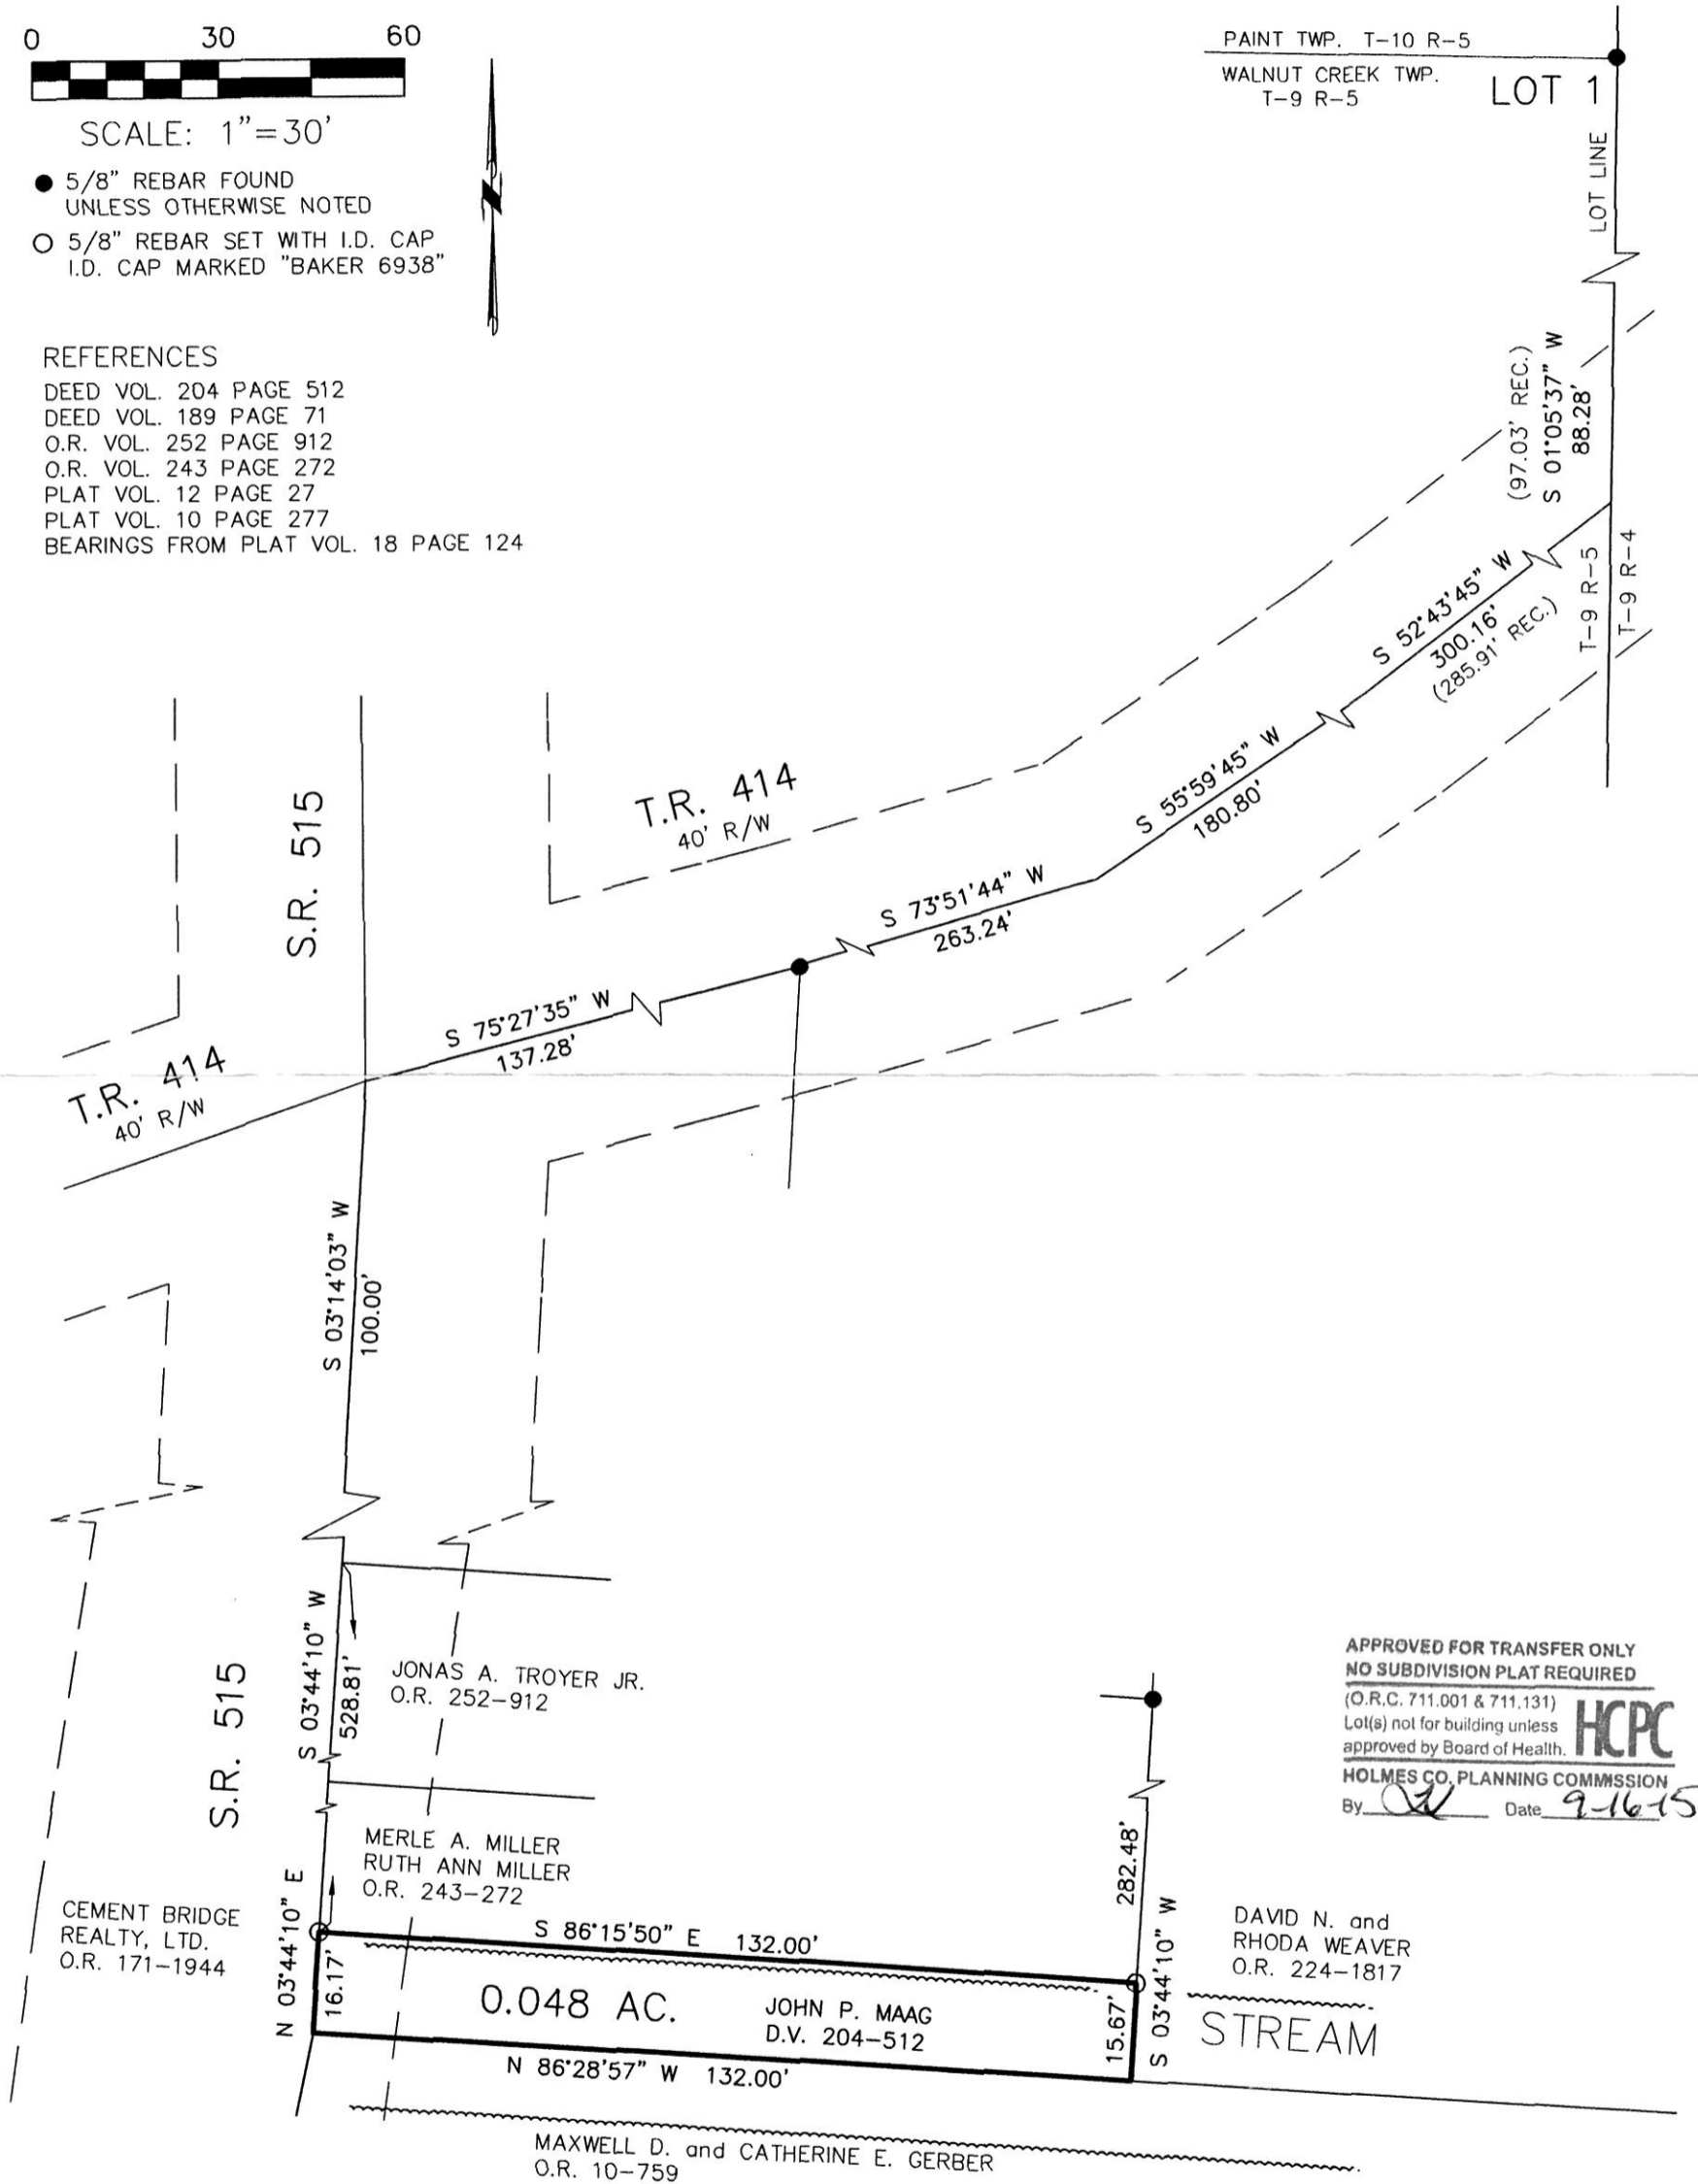

APPROVED FOR TRANSFER ONLY
 NO SUBDIVISION PLAT REQUIRED
 (O.R.C. 711.001 & 711.131)
 Lot(s) not for building unless approved by Board of Health.
HCPC
 HOLMES CO. PLANNING COMMISSION
 By: *[Signature]* Date: 9-16-15

DAVID N. and
 RHODA WEAVER
 O.R. 224-1817

STREAM

I CERTIFY THIS SURVEY TO BE CORRECT TO THE BEST OF MY KNOWLEDGE.

[Signature]
 DONALD C. BAKER P.S. 6938
 DATE: SEPTEMBER 3, 2015
 FDB\ALG
 FILE NAME: WORK4\S-403-15\MLD



DONALD C. BAKER SURVEYING
 138 N. CLAY STREET
 MILLERSBURG, OHIO 44654
 PH. 330-674-4788
 FAX 330-674-6027

PLAT APPROVED

9/15/15