

MECHANIC TOWNSHIP
 N.W. QTR. SECTION 1
 T-8 N; R-7 W
 HOLMES COUNTY, OHIO

SURVEYED FOR: ALLEN TROYER

0 200 400



SCALE: 1"=200'

- STONE FOUND
- 5/8" REBAR FOUND
UNLESS OTHERWISE NOTED
- 5/8" REBAR SET WITH I.D. CAP
I.D. CAP MARKED "BAKER 6938"



Additional approval for this and any adjacent properties **must** be requested and granted prior to any future transfers by deed. Recording of this document **does not** waive the requirements of local Health District Subdivision Regulations or other governing authorities which may be in effect at the time of any future deed transfer.



APPROVED FOR TRANSFER ONLY
 NO SUBDIVISION PLAT REQUIRED

(O.R.C. 711.001 & 711.131)

Lot(s) not for building unless approved by Board of Health.



HOLMES CO. PLANNING COMMISSION

By [Signature] Date 11-20-15

201500097040

B: 19 P: 2867

FILED FOR RECORD IN
 HOLMES COUNTY, OH

ANITA HALL, COUNTY RECORDER

12/03/2015 9:47 AM

SMALL PLAT: 40.00

PAGES: 1

REFERENCES

DEED VOL. 276 PAGE 335

O.R. VOL. 117 PAGE 338

O.R. VOL. 178 PAGE 1599

PLAT VOL. 16 PAGE 295


BEARINGS FROM

PLAT VOL. 16 PAGE 295

ORV 254 P4072

DARRELL W. HOOD
 ROBERTA HOOD MYERS
 KAREN L. MORELLO
 ROBYN HARFORD
 O.R. 117-338

JIM JELINEK LLC
 O.R. 178-1599

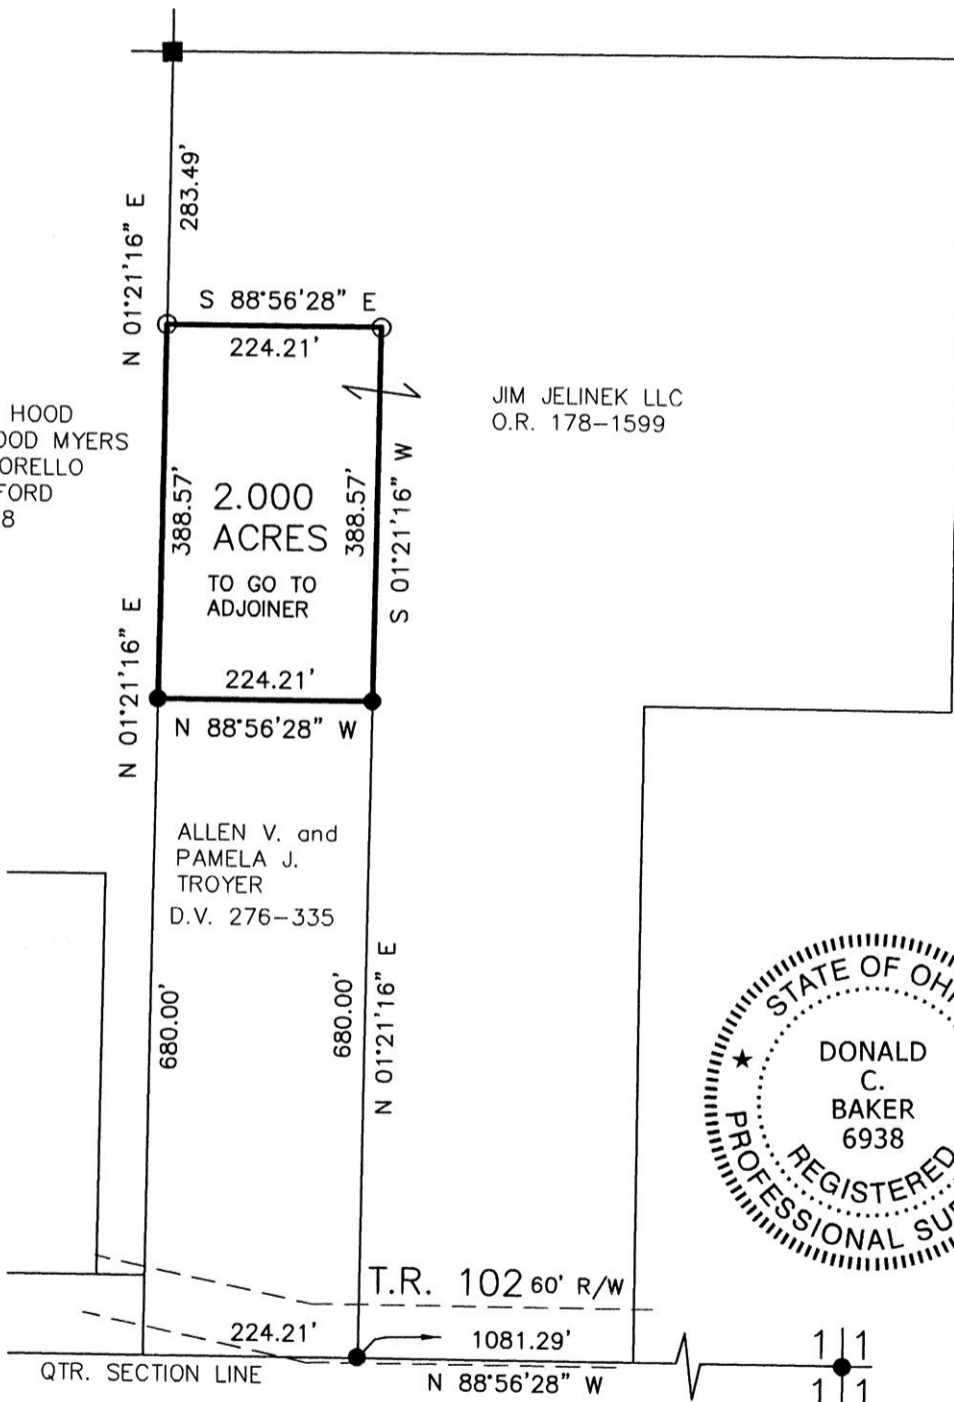

PLAT APPROVED

11/20/15



DONALD C. BAKER SURVEYING
 138 N. CLAY STREET
 MILLERSBURG, OHIO 44654

PH. 330-674-4788

FAX 330-674-6027

I CERTIFY THIS SURVEY TO BE CORRECT TO THE BEST OF MY KNOWLEDGE.

[Signature]

DONALD C. BAKER

P.S. 6938

DATE: NOV. 12, 2015

FDB\KES

FILE NAME: WORK4\S-625-15

