


ORV 251 P951

WASHINGTON TOWNSHIP
 N.W. QTR. SECTION 13
 S.W. QTR. SECTION 13
 T-19 N; R-15 W
 HOLMES COUNTY, OHIO

SURVEYED FOR: WILLIAM T. YOUNG
 JUDY M. SMETZER


REFERENCES

- DEED VOL. 59 PAGE 467
- DEED VOL. 44 PAGE 594
- DEED VOL. 76 PAGE 262
- DEED VOL. 98 PAGE 325
- DEED VOL. 240 PAGE 30
- O.R. VOL. 103 PAGE 636
- O.R. VOL. 254 PAGE 1389
- O.R. VOL. 254 PAGE 3363
- PLAT VOL. 4 PAGE 41
- PLAT VOL. 10 PAGE 858
- PLAT VOL. 17 PAGE 441
- PLAT VOL. 18 PAGE 202
- BEARINGS FROM
 PLAT VOL. 18 PAGE 202

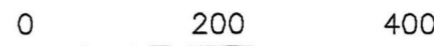

SCALE: 1"=200'

- STONE FOUND
- ▲ R.R. SPIKE FOUND
- 5/8" REBAR FOUND
- UNLESS OTHERWISE NOTED
- MAG NAIL SET
- 5/8" REBAR SET WITH I.D. CAP
- I.D. CAP MARKED "BAKER 6938"

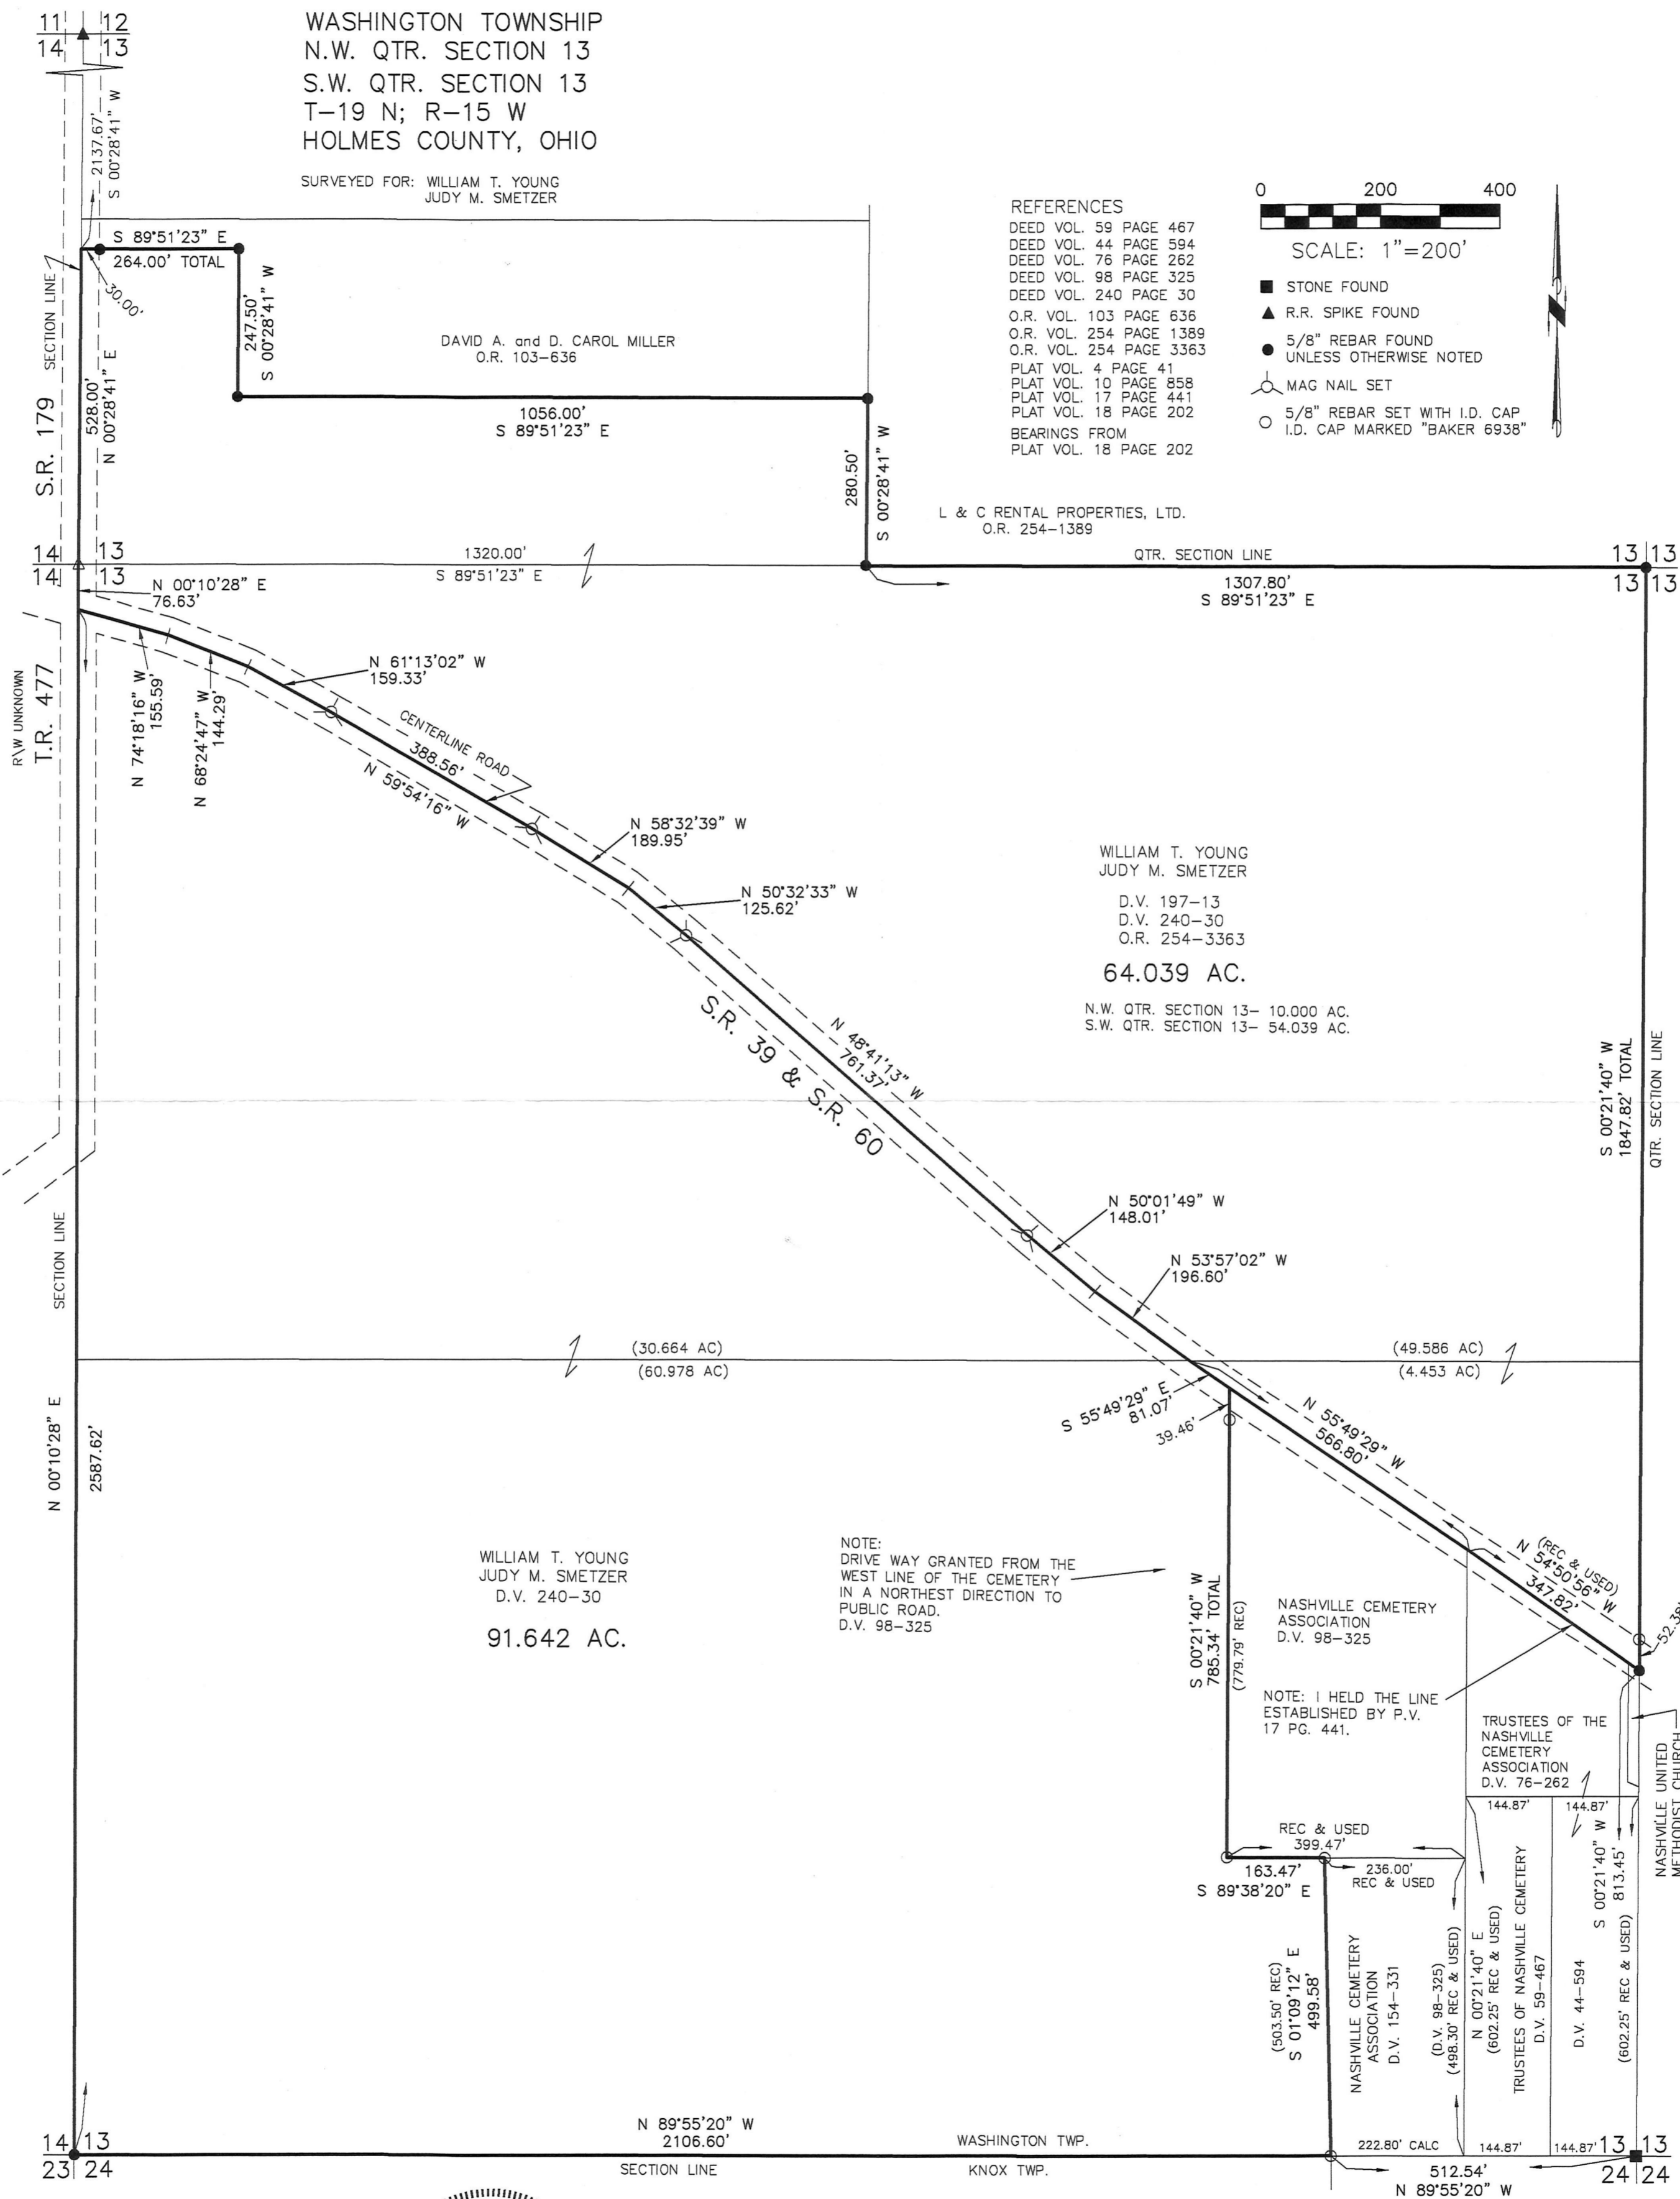

I CERTIFY THIS SURVEY TO BE CORRECT
 TO THE BEST OF MY KNOWLEDGE.

 DONALD C. BAKER P.S. 6938
 DATE: JUNE 22, 2016
 FDB\KES
 FILE NAME: WORK4\S-308-16



BAKER SURVEYING, LLC
 138 N. CLAY STREET
 MILLERSBURG, OHIO 44654
 PH. 330-674-4788
 FAX 330-674-6027

PLAT APPROVED

7/13/2016 TD