


THE BELOW LICENSED PROFESSIONAL ENGINEER CERTIFIES THAT TO THE BEST OF HIS KNOWLEDGE AND BELIEF THIS PLAN GRAPHICALLY SHOWS ALL THE PARTICULARS OF THE BUILDINGS AS CONSTRUCTED.

Harry D. Matter
HARRY D. MATTER, REGISTERED PROFESSIONAL ENGINEER E-040167 DATE 10/3/16
THE BELOW LICENSED PROFESSIONAL SURVEYOR CERTIFIES THAT TO THE BEST OF HIS KNOWLEDGE AND BELIEF THIS PLAN ACCURATELY REFLECTS THE LOCATION OF IMPROVEMENTS AND RECORDED EASEMENTS.
Robert D. Allison
ROBERT D. ALLISON, REGISTERED PROFESSIONAL SURVEYOR 6589 DATE 10/3/2016

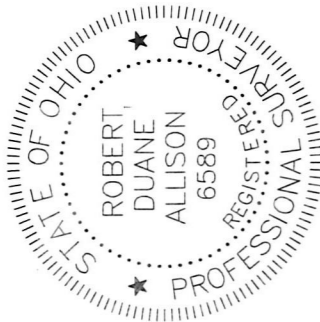

201600102093
B: 19 P: 3087
FILED FOR RECORD IN
HOLMES COUNTY, OH
ANITA HALL, COUNTY RECORDER
10/26/2016 9:05 AM
SMALL PLAT . 40.00
PAGES: 1
DRV 258 PG 260



NOTE:
DO NOT SCALE DRAWINGS. IT IS THE RESPONSIBILITY OF EACH CONTRACTOR TO COORDINATE HIS WORK ON THIS SHEET WITH ALL OTHER SHEETS AND REPORT ANY DISCREPANCIES TO ARCHITECT FOR VERIFICATION.



UNIT 25

UNIT 24

FRONT ELEVATION

SCALE: 3/16" = 1'-0"



UNIT 24

RIGHT SIDE ELEVATION

SCALE: 3/16" = 1'-0"

BUILDING 11, UNITS 23, 24 AND 25

BA WILDER
Architectural Services
Commercial, Industrial & Residential Design
487 4th Street NW Suite B, New Philadelphia, Ohio 44663 Phone: (330) 334-4064 Fax: (330) 334-4219

PRELIMINARY
NOT FOR
CONSTRUCTION

Brace A. Wilder Lic. #11790
Expiration Date: 12/31/17

© COPYRIGHT 2016
ALL IDEAS, DESIGN ARRANGEMENTS AND INDICATED OR REFERENCED BY THIS DRAWING ARE OWNED BY AND THE PROPERTY OF BA WILDER ARCHITECTURAL SERVICES, LLC AND NO PARTS, ENTIRE OR PARTIAL, SHALL BE REPRODUCED OR TRANSMITTED IN ANY FORM OR BY ANY MEANS, ELECTRONIC OR MECHANICAL, INCLUDING PHOTOCOPYING, RECORDING, OR BY ANY INFORMATION STORAGE AND RETRIEVAL SYSTEM, WITHOUT THE WRITTEN PERMISSION OF BA WILDER ARCHITECTURAL SERVICES, LLC.

New Building For:
The Cove at Walnut Creek
Walnut Creek, Ohio 44687

JOB NO	16-1720
Start Date	2-25-16
Rel. Date	
Plot Date	5-7-16
D.J.S.	

3 OF 5

