

MECHANIC TOWNSHIP  
 N.W. QTR. SECTION 19  
 T-8 N; R-7 W  
 HOLMES COUNTY, OHIO

SURVEYED FOR: WANDA BRINKER ESTATE



SCALE: 1"=200'

- STONE FOUND
- 5/8" REBAR FOUND  
UNLESS OTHERWISE NOTED
- 5/8" REBAR SET WITH I.D. CAP  
I.D. CAP MARKED "BAKER 6938"

REFERENCES

- O.R. VOL. 205 PAGE 2529
- O.R. VOL. 37 PAGE 246
- O.R. VOL. 252 PAGE 3269
- O.R. VOL. 252 PAGE 4466
- PLAT VOL. 19 PAGE 283
- PLAT VOL. 19 PAGE 528
- PLAT VOL. 19 PAGE 2724
- BEARINGS FROM  
PLAT VOL. 19 PAGE 2724

I CERTIFY THIS SURVEY TO BE CORRECT  
 TO THE BEST OF MY KNOWLEDGE.


*Donald C. Baker*

DONALD C. BAKER P.S. 6938

DATE: AUGUST 1, 2017

KES\ADC

FILE NAME: WORK4\S-342-17

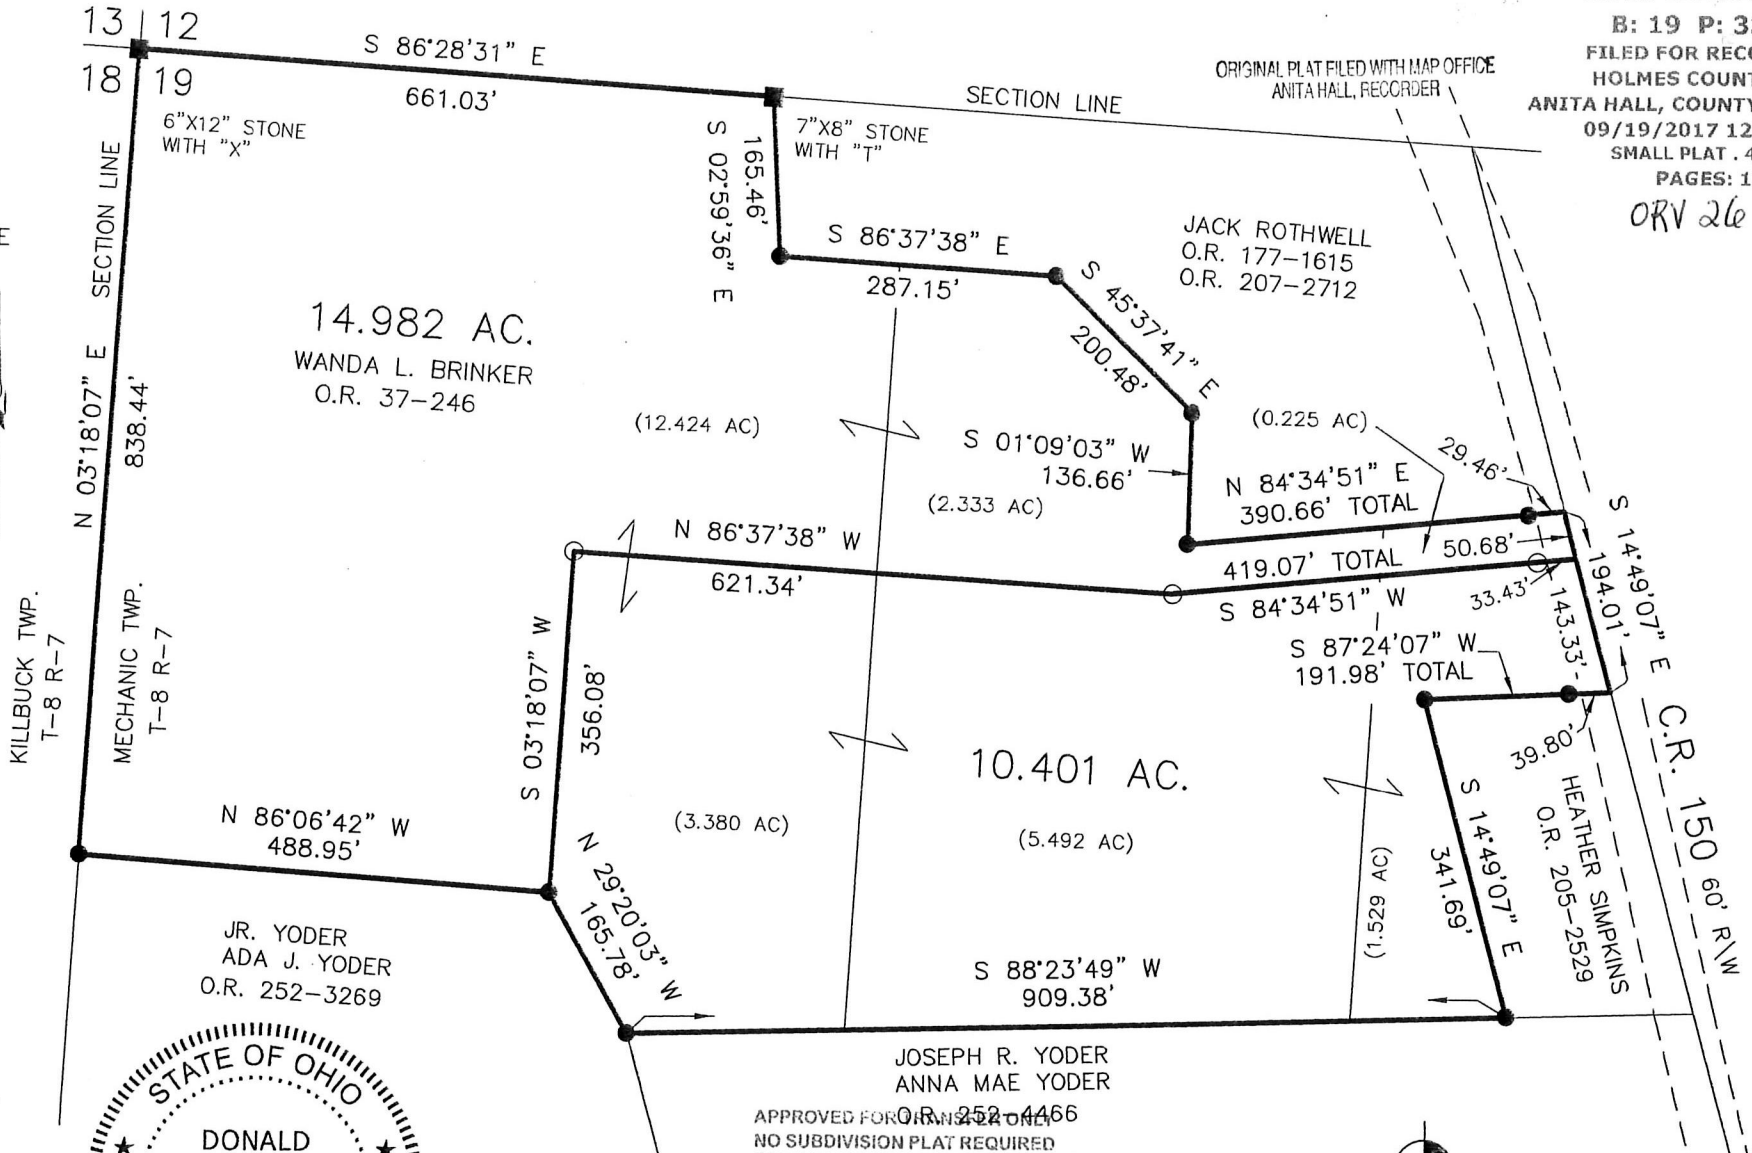

201700107104

B: 19 P: 3303

FILED FOR RECORD IN  
 HOLMES COUNTY, OH  
 ANITA HALL, COUNTY RECORDER

09/19/2017 12:43 PM

SMALL PLAT . 40.00

PAGES: 1

ORV 261 PG-3983



APPROVED FOR RECORDATION  
 NO SUBDIVISION PLAT REQUIRED

(O.R.C. 711.001 & 711.131)  
 Lot(s) not for building unless  
 approved by Board of Health.

HOLMES CO. PLANNING COMMISSION

By *[Signature]* Date *9/14/17*



BAKER SURVEYING, LLC  
 138 N. CLAY STREET  
 MILLERSBURG, OHIO 44654  
 PH. 330-674-4788  
 FAX 330-674-6027

PLAT APPROVED

*9/5/2017 TD*

