


WALNUT CREEK TOWNSHIP
 N.E. & S.E. QTRS. SECTION 18
 T-9 N; R-5 W
 HOLMES COUNTY, OHIO
 SURVEYED FOR: DUSTIN MILLER

- REFERENCES
 DEED VOL. 233 PAGE 187
 DEED VOL. 52 PAGE 458
 O.R. VOL. 216 PAGE 2175
 PLAT VOL. 3 PAGE 26 B
 PLAT VOL. 5 PAGE 37
 PLAT VOL. 4 PAGE 95
 PLAT VOL. 4 PAGE 83
 PLAT VOL. 5 PAGE 68
 PLAT VOL. 5 PAGE 41
 PLAT VOL. 14 PAGE 711
 PLAT VOL. 12 PAGE 388
 PLAT VOL. 18 PAGE 434
 PLAT VOL. 14 PAGE 927
 PLAT VOL. 10 PAGE 825
 PLAT VOL. 19 PAGE 3129
 PLAT VOL. 4 PAGE 168
 PLAT VOL. 19 PAGE 1386
 PLAT VOL. 2 PAGE 117
 PLAT VOL. 10 PAGE 683
 PLAT VOL. 18 PAGE 615
 PLAT VOL. 10 PAGE 741
 PLAT VOL. 12 PAGE 68
 BEARINGS ASSUMED

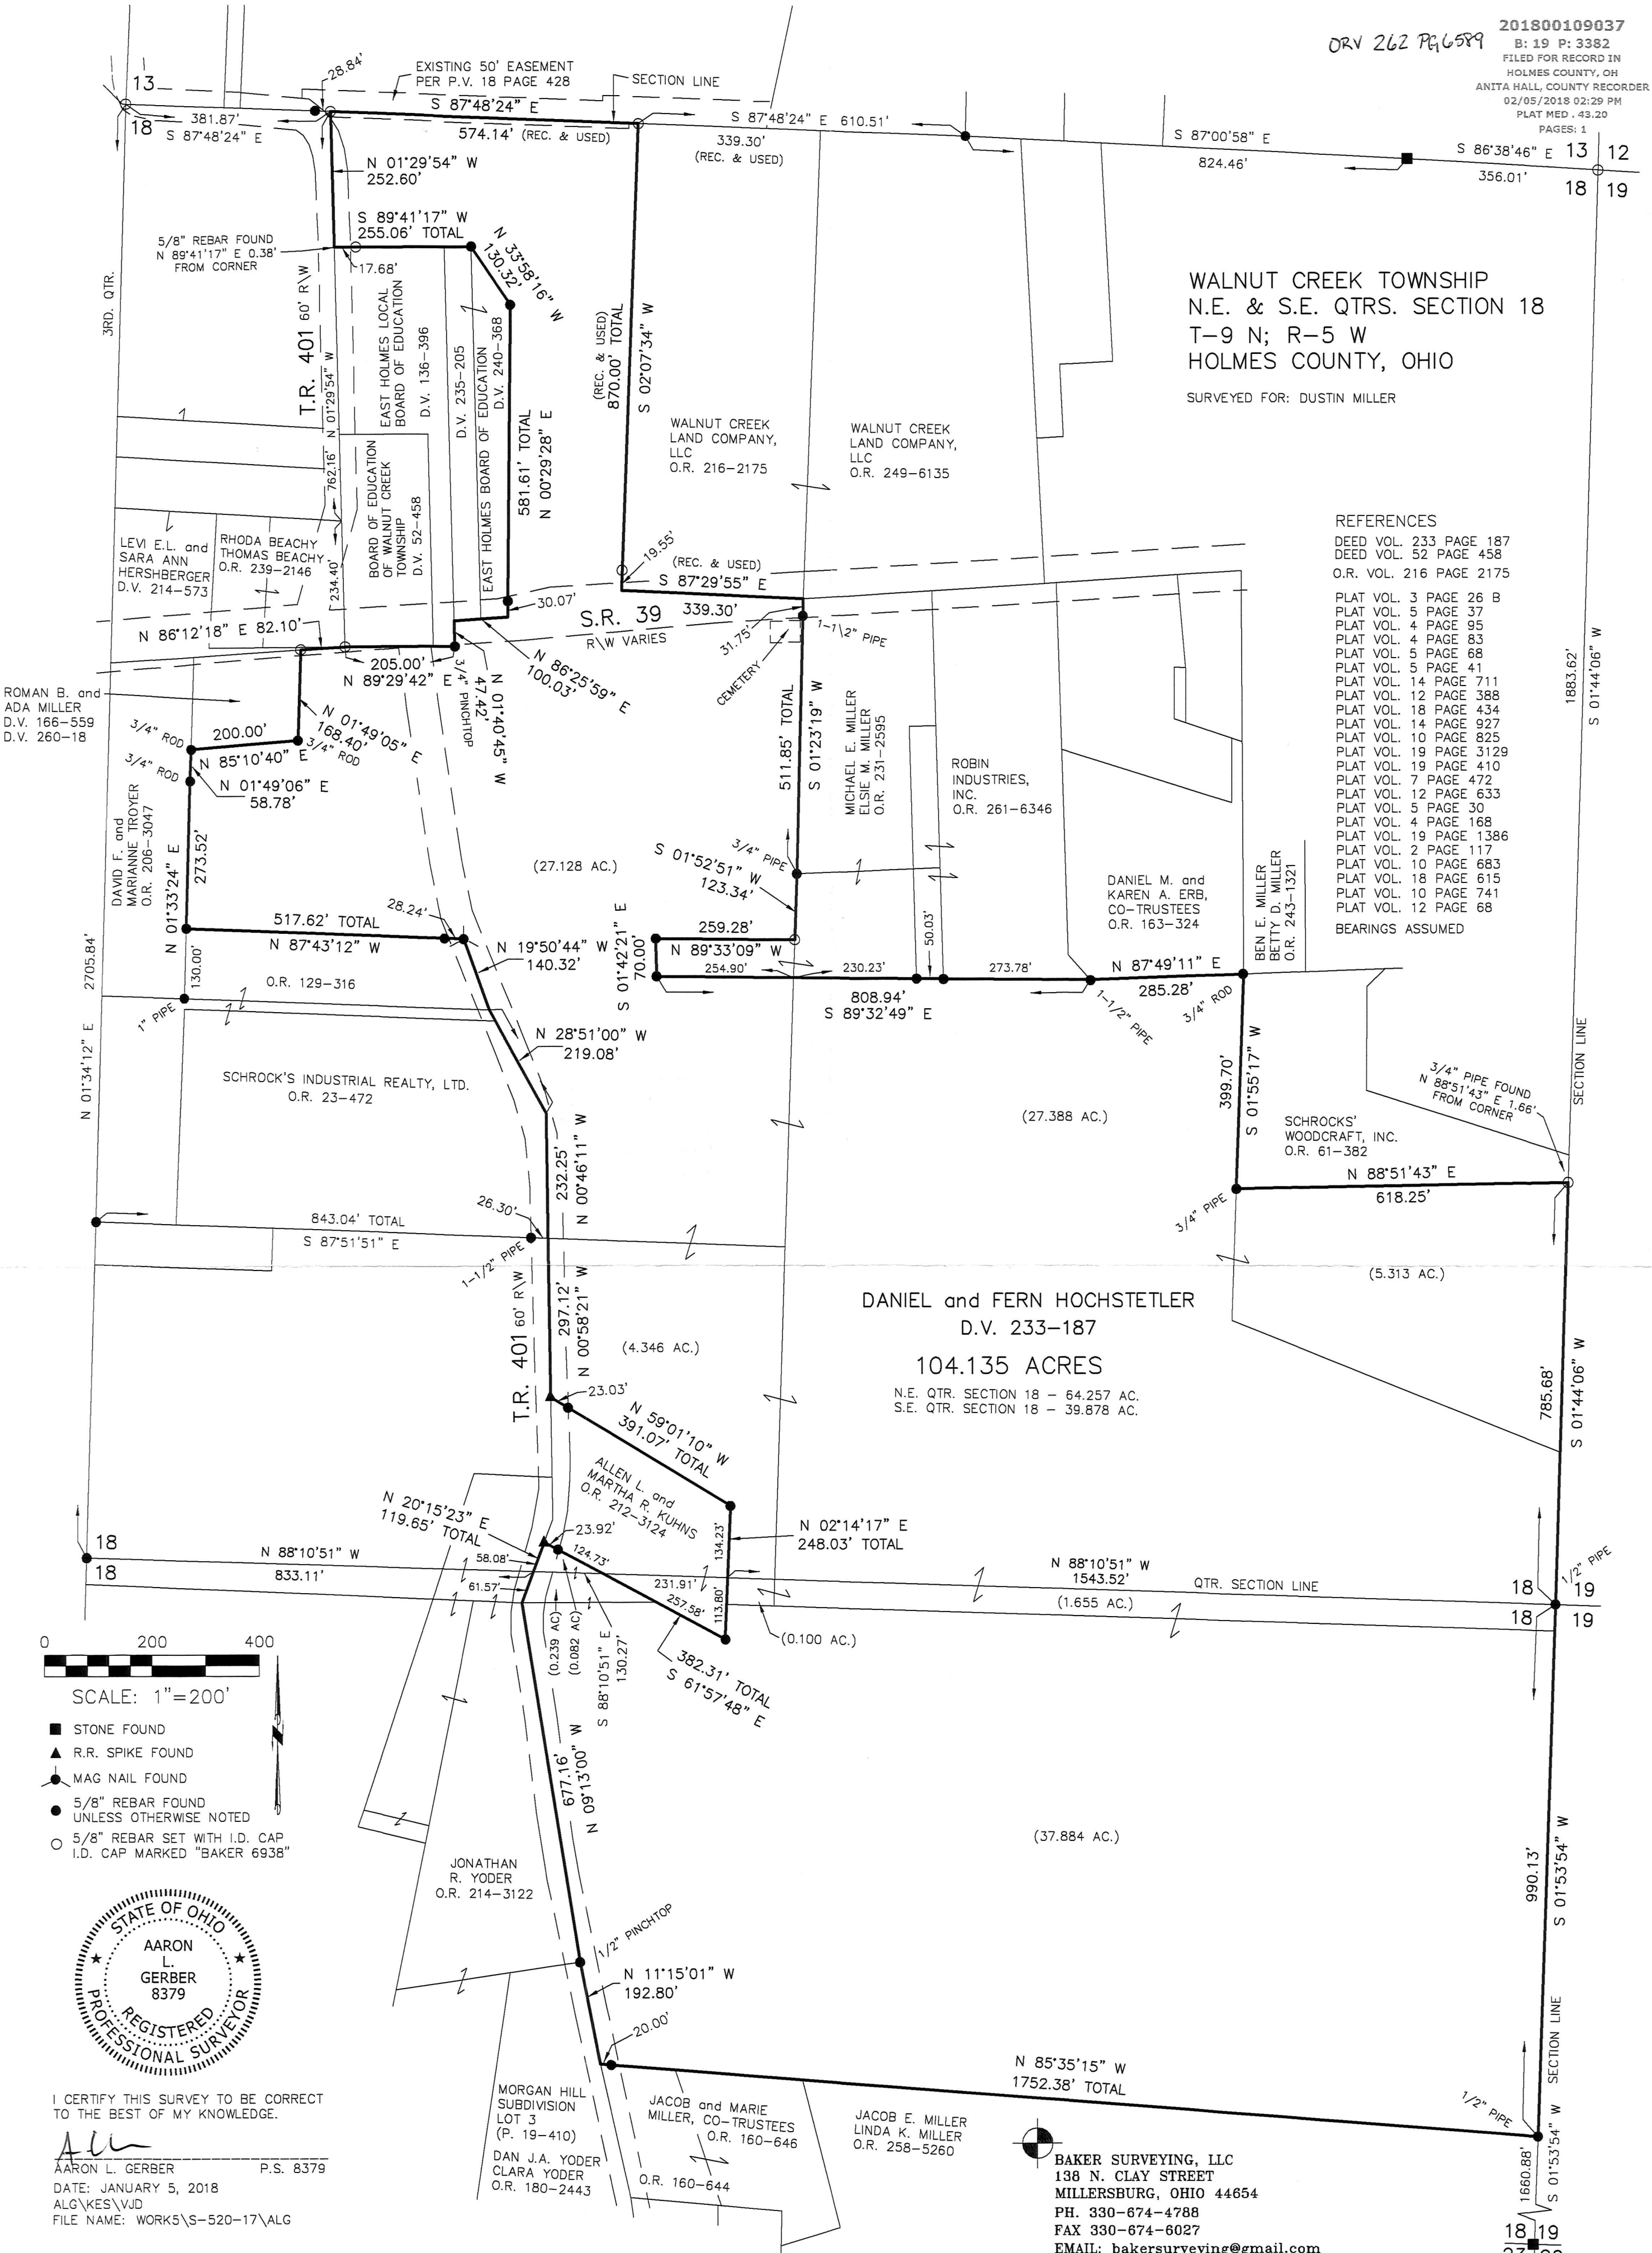

0 200 400
 SCALE: 1"=200'
 ■ STONE FOUND
 ▲ R.R. SPIKE FOUND
 ● MAG NAIL FOUND
 ● 5/8" REBAR FOUND
 UNLESS OTHERWISE NOTED
 ○ 5/8" REBAR SET WITH I.D. CAP
 I.D. CAP MARKED "BAKER 6938"



I CERTIFY THIS SURVEY TO BE CORRECT
 TO THE BEST OF MY KNOWLEDGE.
 Aaron L. Gerber P.S. 8379
 DATE: JANUARY 5, 2018
 ALG/KES/VJD
 FILE NAME: WORKS\S-520-17\ALG

DANIEL and FERN HOCHSTETLER
 D.V. 233-187
 104.135 ACRES
 N.E. QTR. SECTION 18 - 64.257 AC.
 S.E. QTR. SECTION 18 - 39.878 AC.

BAKER SURVEYING, LLC
 138 N. CLAY STREET
 MILLERSBURG, OHIO 44654
 PH. 330-674-4788
 FAX 330-674-6027
 EMAIL: bakersurveying@gmail.com

APPROVED FOR TRANSFER ONLY
 NO SUBDIVISION PLAT REQUIRED
 (O.R.C. 711.001 & 711.131)
 Lot(s) not for building unless
 approved by Board of Health.
 HOLMES CO. PLANNING COMMISSION
 By: [Signature] Date: 1/17/18

PLAT APPROVED
 1/17/2018