


ORV 262 PG 7253

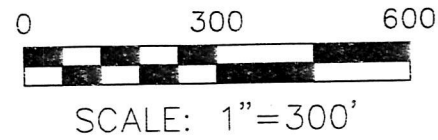


- 5/8" REBAR FOUND UNLESS OTHERWISE NOTED
- 5/8" REBAR SET WITH I.D. CAP I.D. CAP MARKED "BAKER 6938"

MONROE TOWNSHIP  
 2ND. QTR., LOT 9  
 T-9 N; R-8 W  
 HOLMES COUNTY, OHIO

SURVEYED FOR: ERIC HANSEN

REFERENCES

- DEED VOL. 207 PAGE 81
- DEED VOL. 267 PAGE 764
- O.R. VOL. 258 PAGE 7052
- PLAT VOL. 8 PAGE 473
- PLAT VOL. 13 PAGE 114
- PLAT VOL. 12 PAGE 468
- PLAT VOL. 15 PAGE 82
- BEARINGS FROM  
 PLAT VOL. 12 PAGE 468

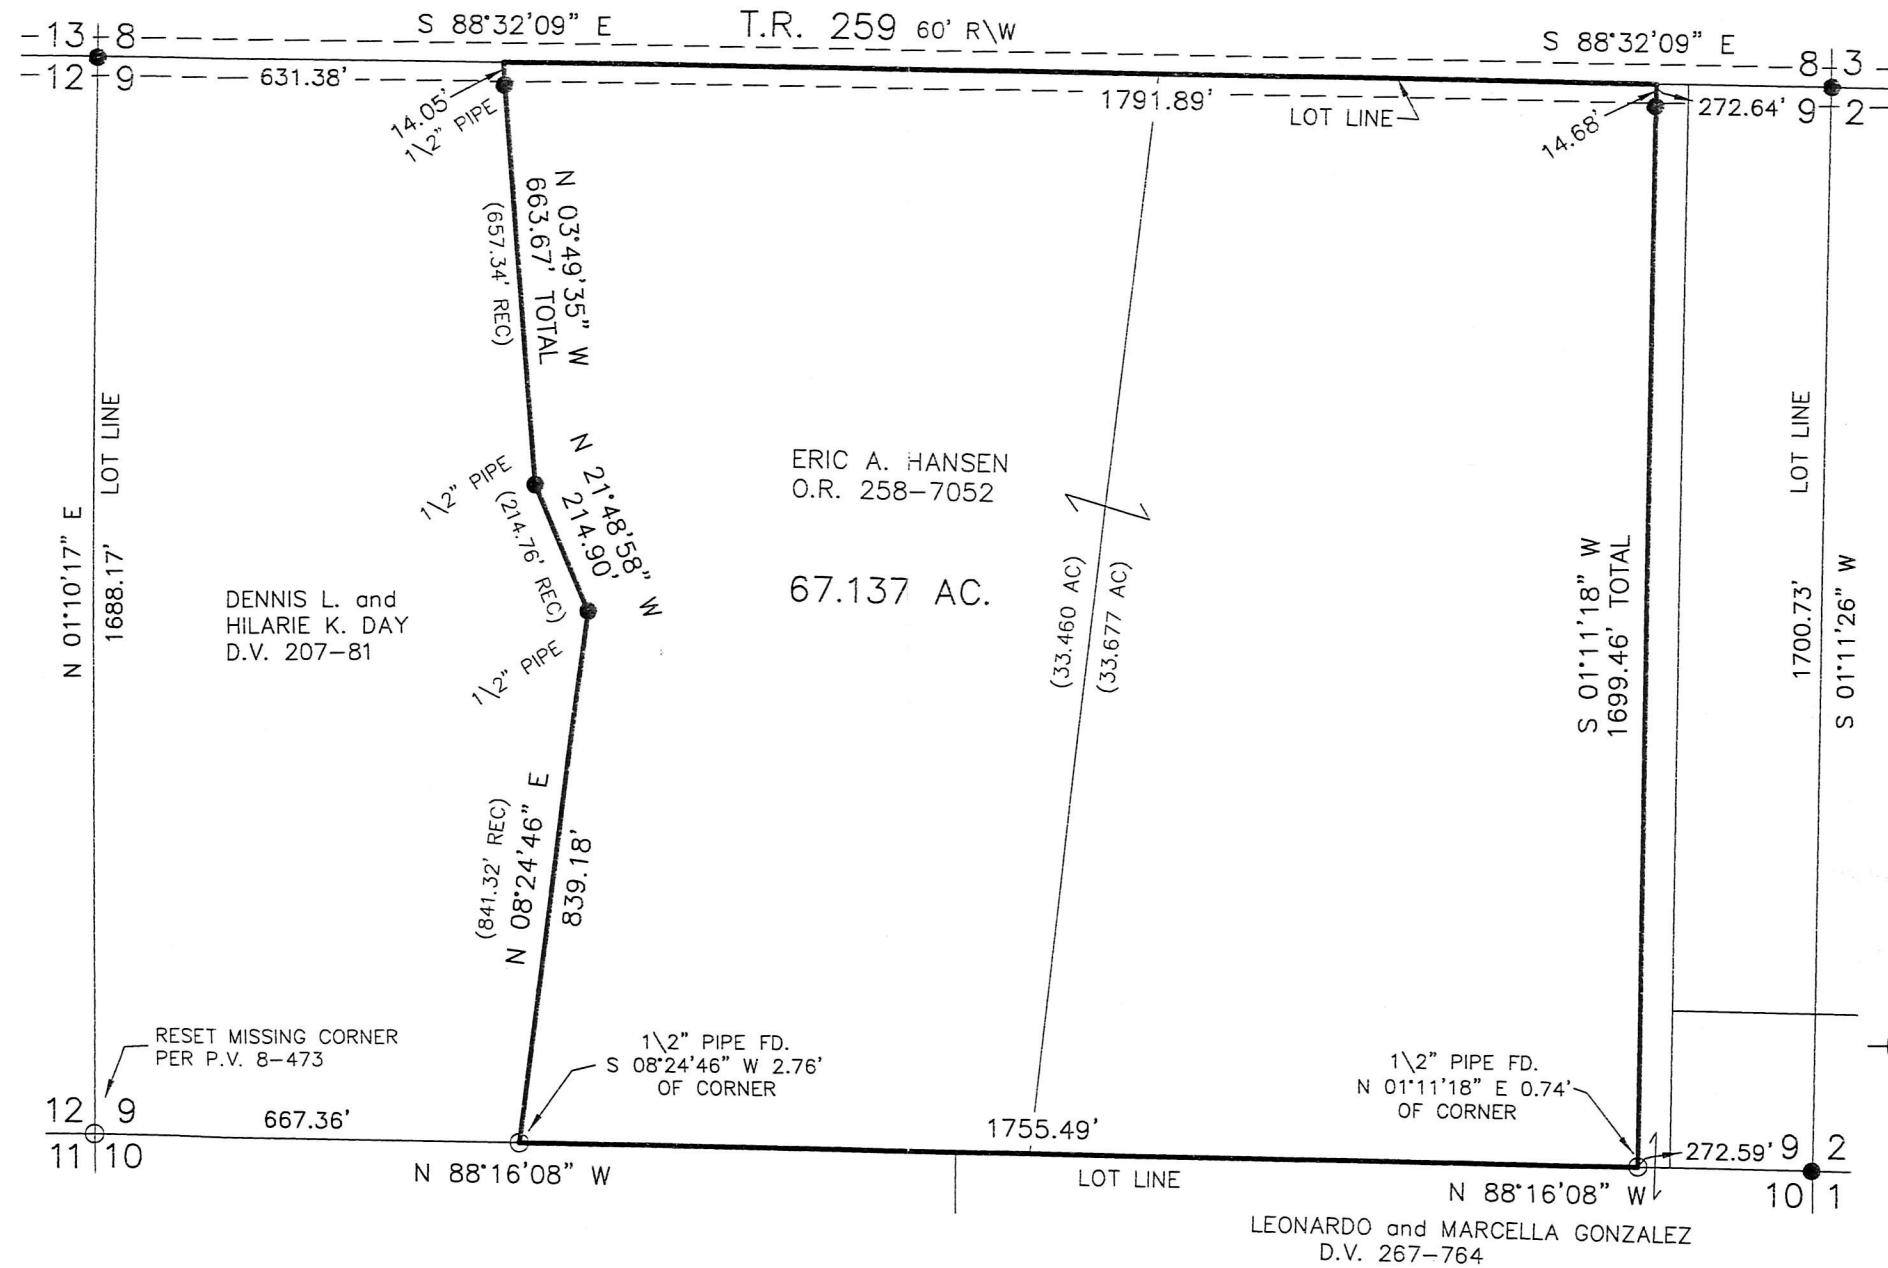

I CERTIFY THIS SURVEY TO BE CORRECT TO THE BEST OF MY KNOWLEDGE.

*Donald C. Baker*

DONALD C. BAKER P.S. 6938  
 DATE: OCT. 16, 2017  
 FDB\KES  
 FILE NAME: WORK4\S-501-17


APPROVED FOR TRANSFER ONLY  
 NO SUBDIVISION PLAT REQUIRED

(O.R.C. 711.001 & 711.131)  
 Lot(s) not for building unless approved by Board of Health.



HOLMES CO. PLANNING COMMISSION

By: *[Signature]* Date: 10/25/17

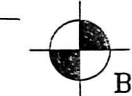

BAKER SURVEYING, LLC  
 138 N. CLAY STREET  
 MILLERSBURG, OHIO 44654  
 PH. 330-674-4788  
 FAX 330-674-6027

PLAT APPROVED

10/19/2017

