



RESURVEY OF O.R. VOL. 255 PG. 1714

BERLIN TOWNSHIP
 1ST. QTR., LOT 21
 T-9 N; R-6 W
 HOLMES COUNTY, OHIO

SURVEYED FOR: MARCUS ERB

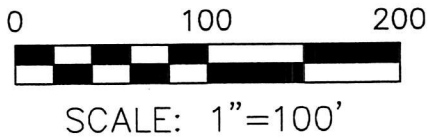

- 5/8" REBAR FOUND UNLESS OTHERWISE NOTED
- 5/8" REBAR SET WITH I.D. CAP I.D. CAP MARKED "BAKER 6938"

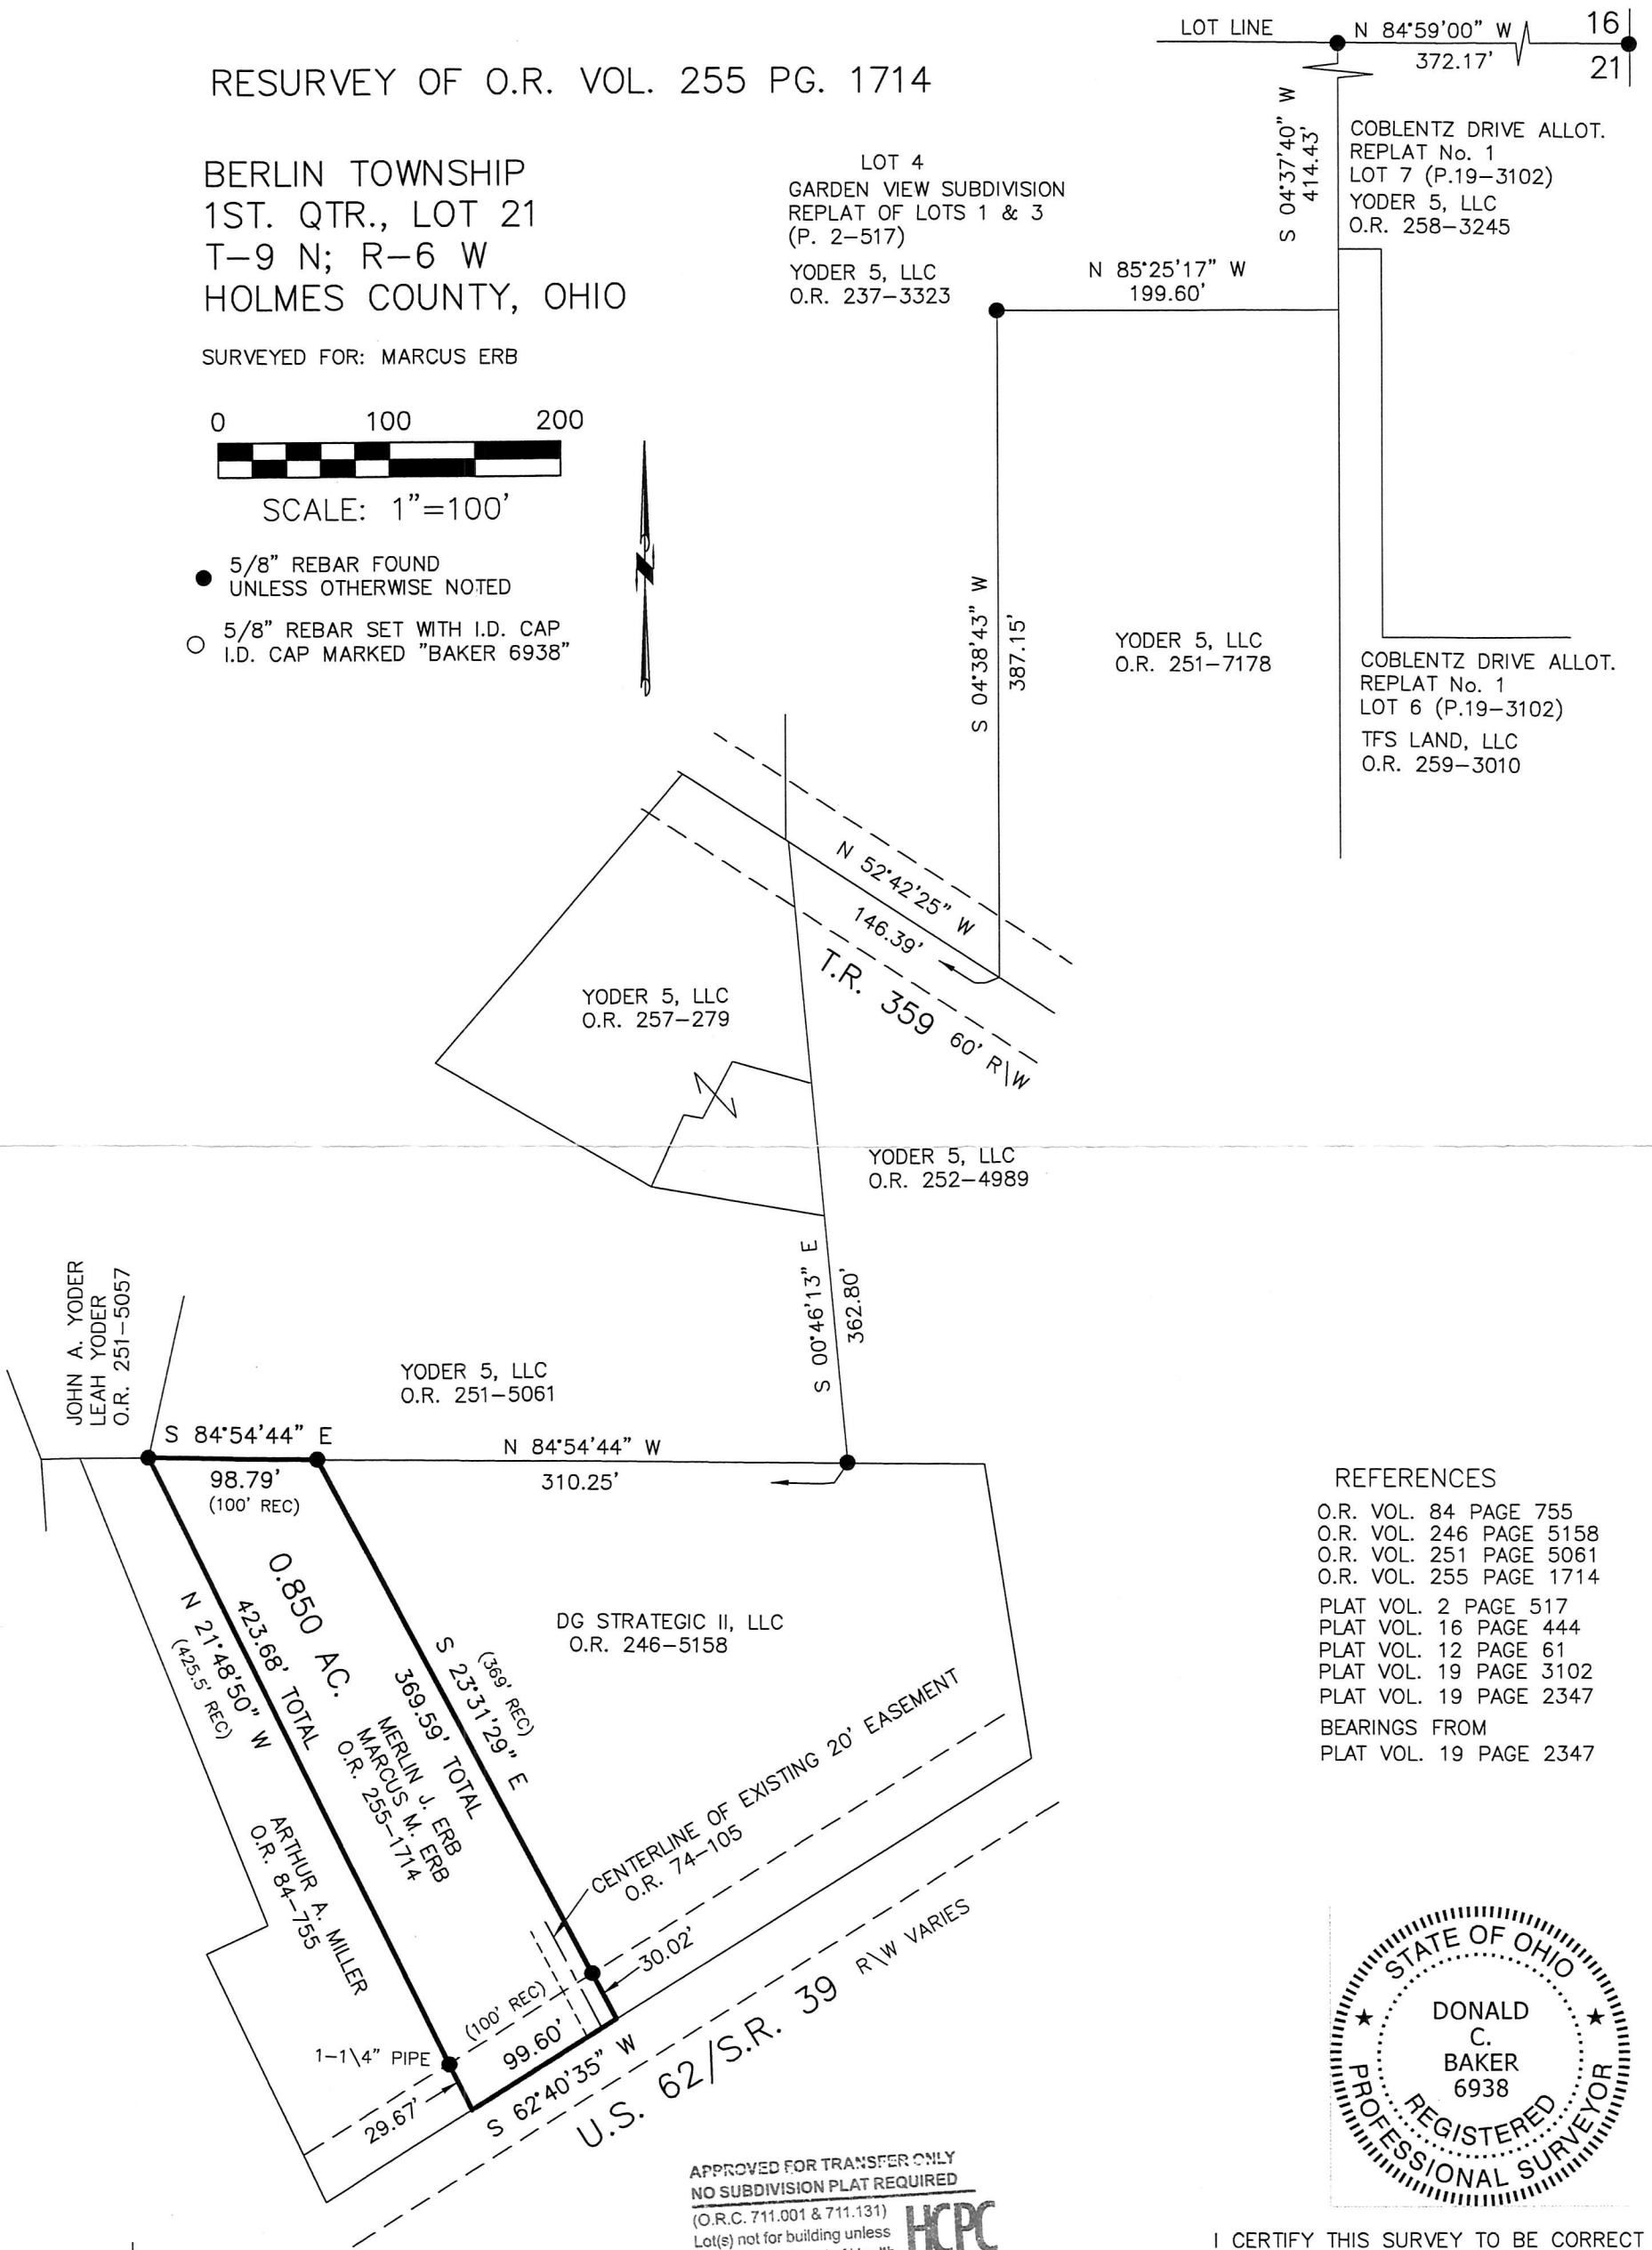

- REFERENCES
- O.R. VOL. 84 PAGE 755
 - O.R. VOL. 246 PAGE 5158
 - O.R. VOL. 251 PAGE 5061
 - O.R. VOL. 255 PAGE 1714
 - PLAT VOL. 2 PAGE 517
 - PLAT VOL. 16 PAGE 444
 - PLAT VOL. 12 PAGE 61
 - PLAT VOL. 19 PAGE 3102
 - PLAT VOL. 19 PAGE 2347
 - BEARINGS FROM PLAT VOL. 19 PAGE 2347



APPROVED FOR TRANSFER ONLY
 NO SUBDIVISION PLAT REQUIRED
 (O.R.C. 711.001 & 711.131)
 Lot(s) not for building unless approved by Board of Health.
 HOLMES CO. PLANNING COMMISSION
 By [Signature] Date 12/21/17

I CERTIFY THIS SURVEY TO BE CORRECT TO THE BEST OF MY KNOWLEDGE.
[Signature]
 DONALD C. BAKER P.S. 6938
 DATE: DEC. 14, 2017
 FDB\VJD
 FILE NAME: WORK4\S-612-17

BAKER SURVEYING, LLC
 138 N. CLAY STREET
 MILLERSBURG, OHIO 44654
 PH. 330-674-4788
 FAX 330-674-6027

PLAT APPROVED
 12/21/2017 TD