



ORV 266 page 4334

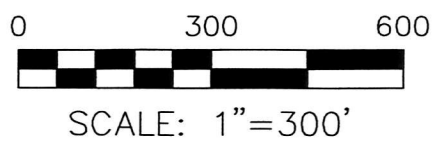

- STONE FOUND
- 1/2" PIPE FOUND UNLESS OTHERWISE NOTED
- 5/8" REBAR SET WITH I.D. CAP I.D. CAP MARKED "BAKER 6938"

REFERENCES  
 DEED VOL. 5 PAGE 446  
 O.R. VOL. 182 PAGE 644  
 O.R. VOL. 201 PAGE 458  
 O.R. VOL. 218 PAGE 96  
 PLAT VOL. 8 PAGE 95  
 PLAT VOL. 12 PAGE 829  
 PLAT VOL. 13 PAGE 132  
 PLAT VOL. 16 PAGE 946  
 PLAT VOL. 19 PAGE 464  
 SURVEY RECORD 3 PAGE 366  
 SURVEY RECORD 4 PAGE 91  
 SURVEY BY JIM GUTE DATED MAY 1976  
 BEARINGS FROM SURVEY RECORD BOOK 4 PAGE 91

RICHLAND TOWNSHIP  
 S.W. QTR. SECTION 25  
 T-8 N; R-8 W  
 HOLMES COUNTY, OHIO  
 SURVEYED FOR: DOUG DIX

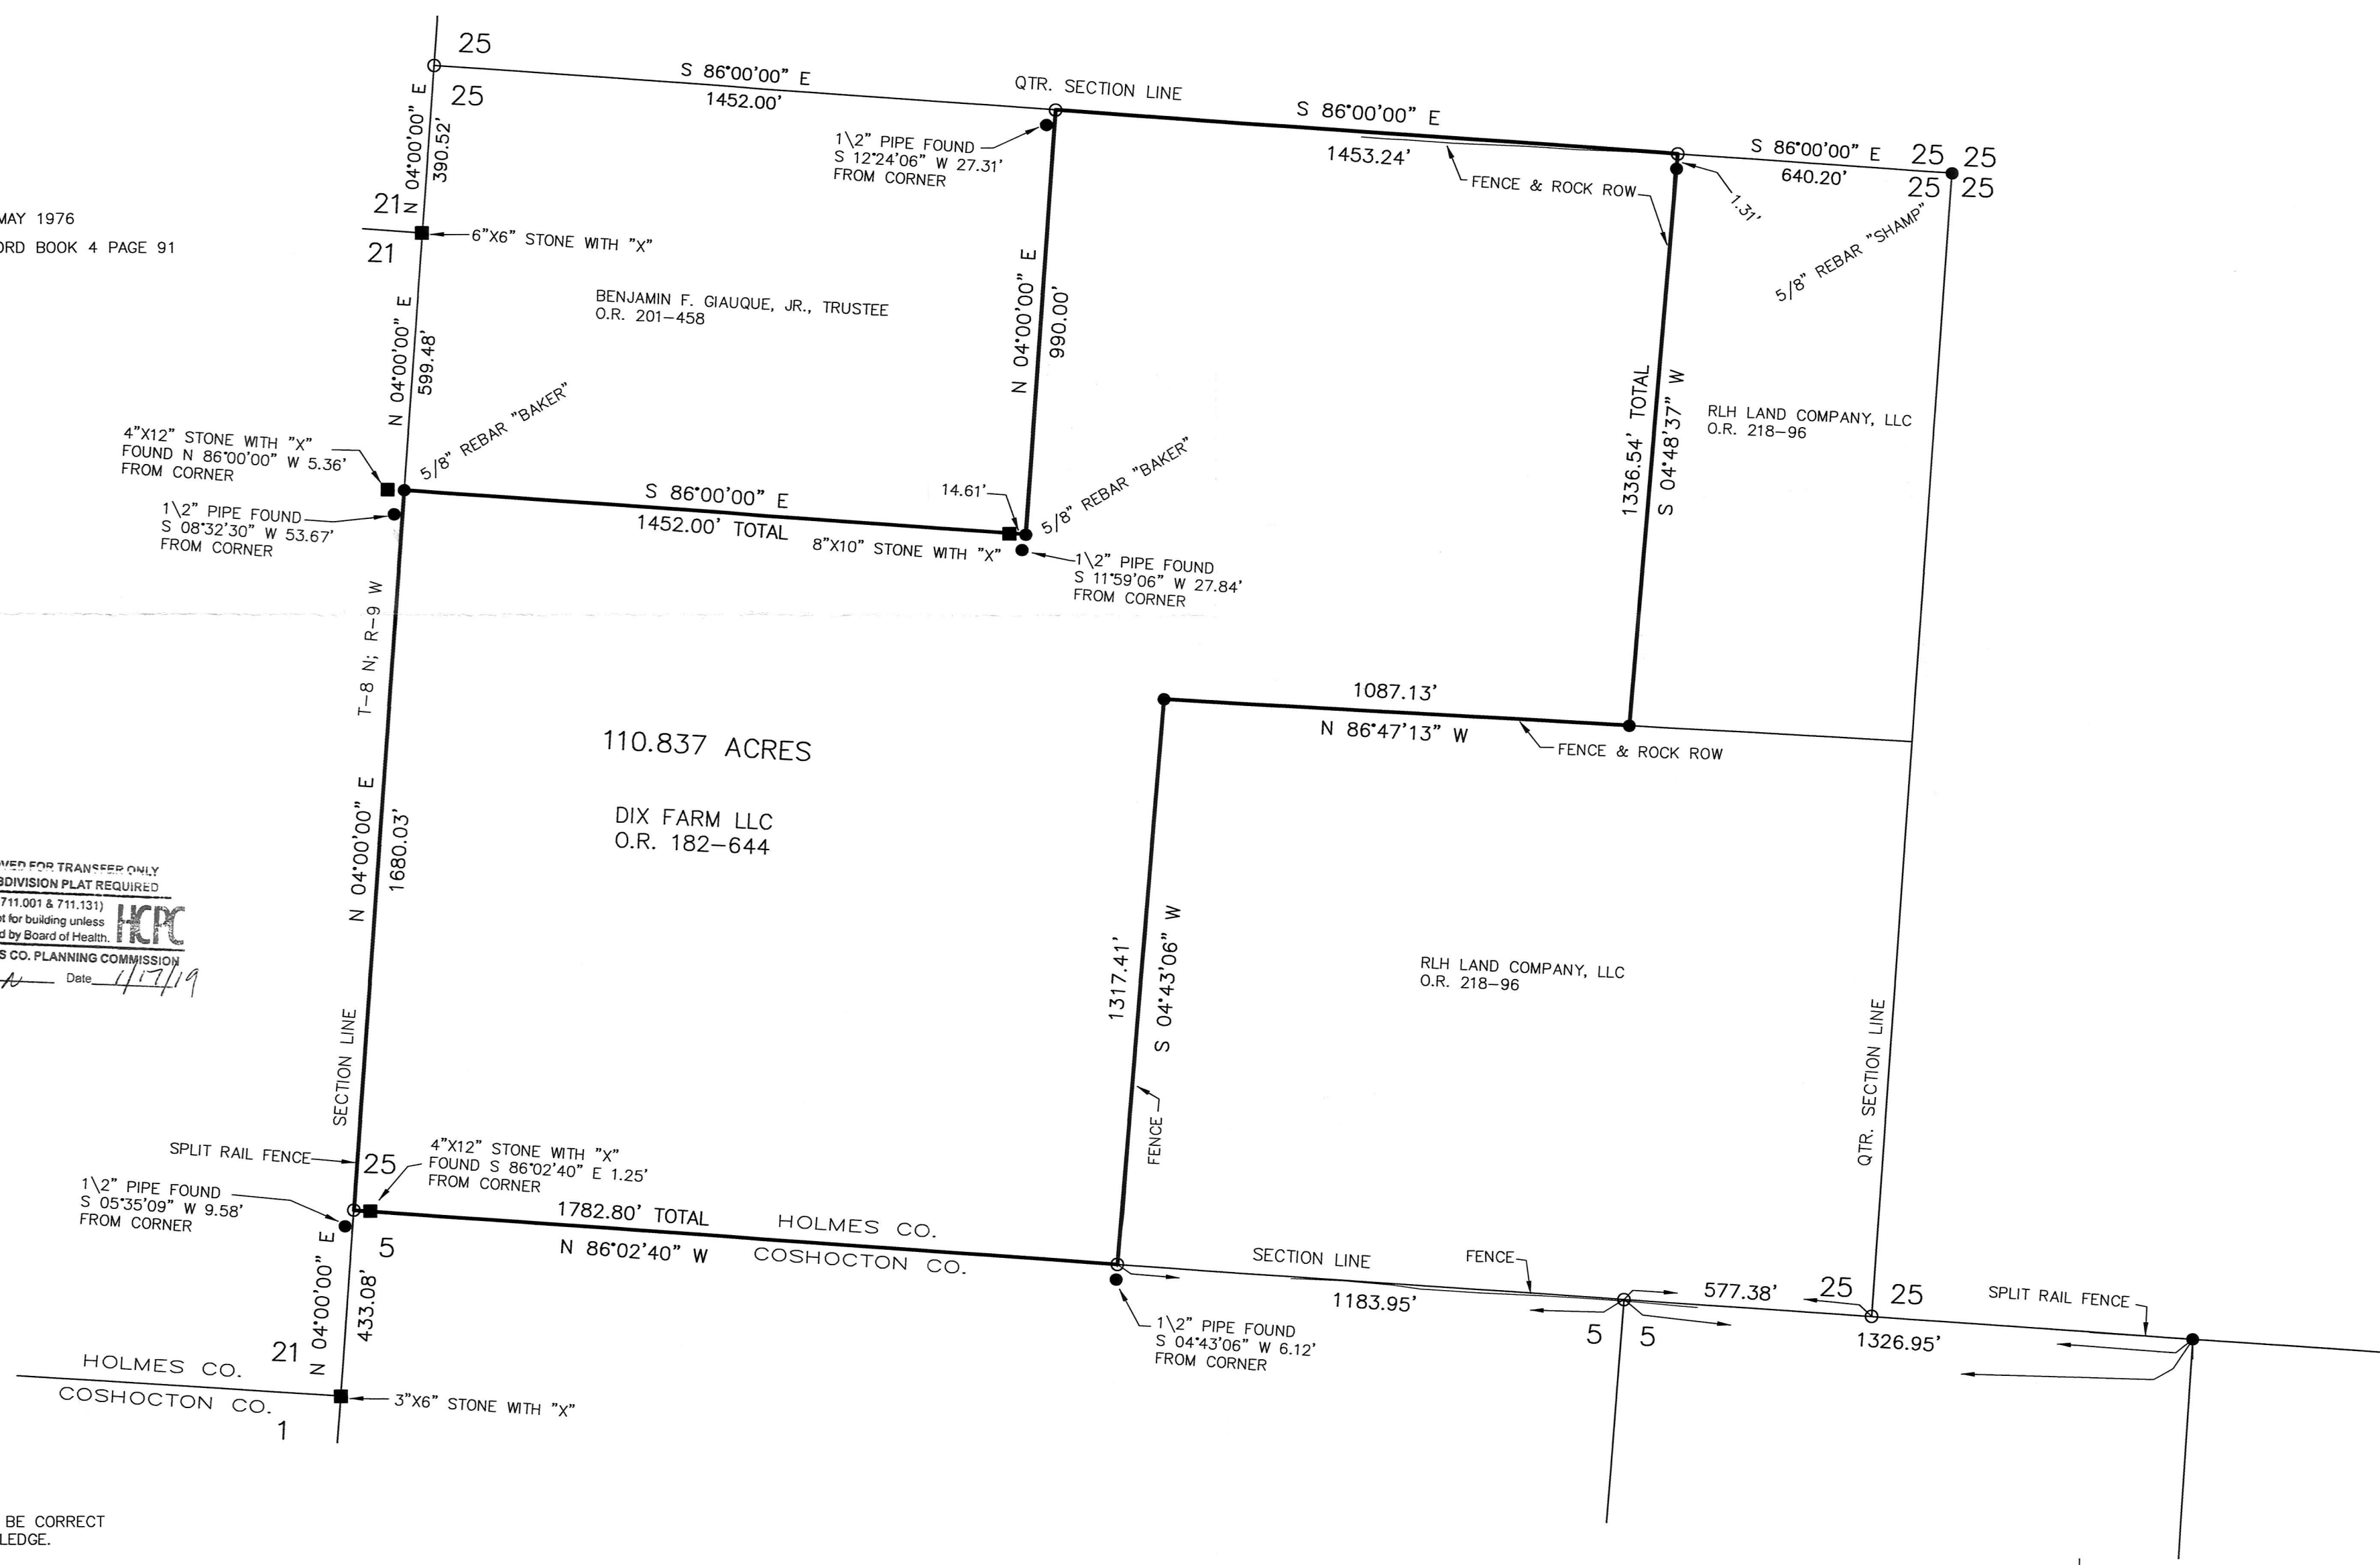

APPROVED FOR TRANSFER ONLY  
 NO SUBDIVISION PLAT REQUIRED  
 (O.R.C. 711.001 & 711.131)  
 Lot(s) not for building unless  
 approved by Board of Health  
 HOLMES CO. PLANNING COMMISSION  
 By: *[Signature]* Date: 1/17/19



I CERTIFY THIS SURVEY TO BE CORRECT TO THE BEST OF MY KNOWLEDGE.

*A-L-G*  
 AARON L. GERBER P.S. 8379  
 DATE: MARCH 9, 2012  
 ALG\CJG  
 FILE NAME: WORK3-2012\S-69-12\MLD

PLAT APPROVED

*1/17/2019*

DONALD C. BAKER SURVEYING  
 138 N. CLAY STREET  
 MILLERSBURG, OHIO 44654  
 PH. 330-674-4788  
 FAX 330-674-6027