


ORV 268 P6046

REFERENCES  
O.R. VOL. 157 PAGE 79  
O.R. VOL. 84 PAGE 121  
O.R. VOL. 268 PAGE 4302  
O.R. VOL. 259 PAGE 4876  
PLAT VOL.18 PAGE 44  
PLAT VOL.18 PAGE 413  
PLAT VOL.19 PAGE 484  
PLAT VOL.19 PAGE 3450  
BEARINGS FROM  
PLAT VOL.18 PAGE 44


HARDY TOWNSHIP  
N.E. QTR. SECTION 24  
T-9 N; R-6 W  
HOLMES COUNTY, OHIO

SURVEYED FOR: EUGENE FORCE

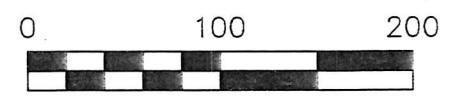

SCALE: 1"=100'

- STONE FOUND
- ▲ R.R. SPIKE FOUND
- 5/8" REBAR FOUND UNLESS OTHERWISE NOTED
- 5/8" REBAR SET WITH I.D. CAP I.D. CAP MARKED "BAKER 6938"

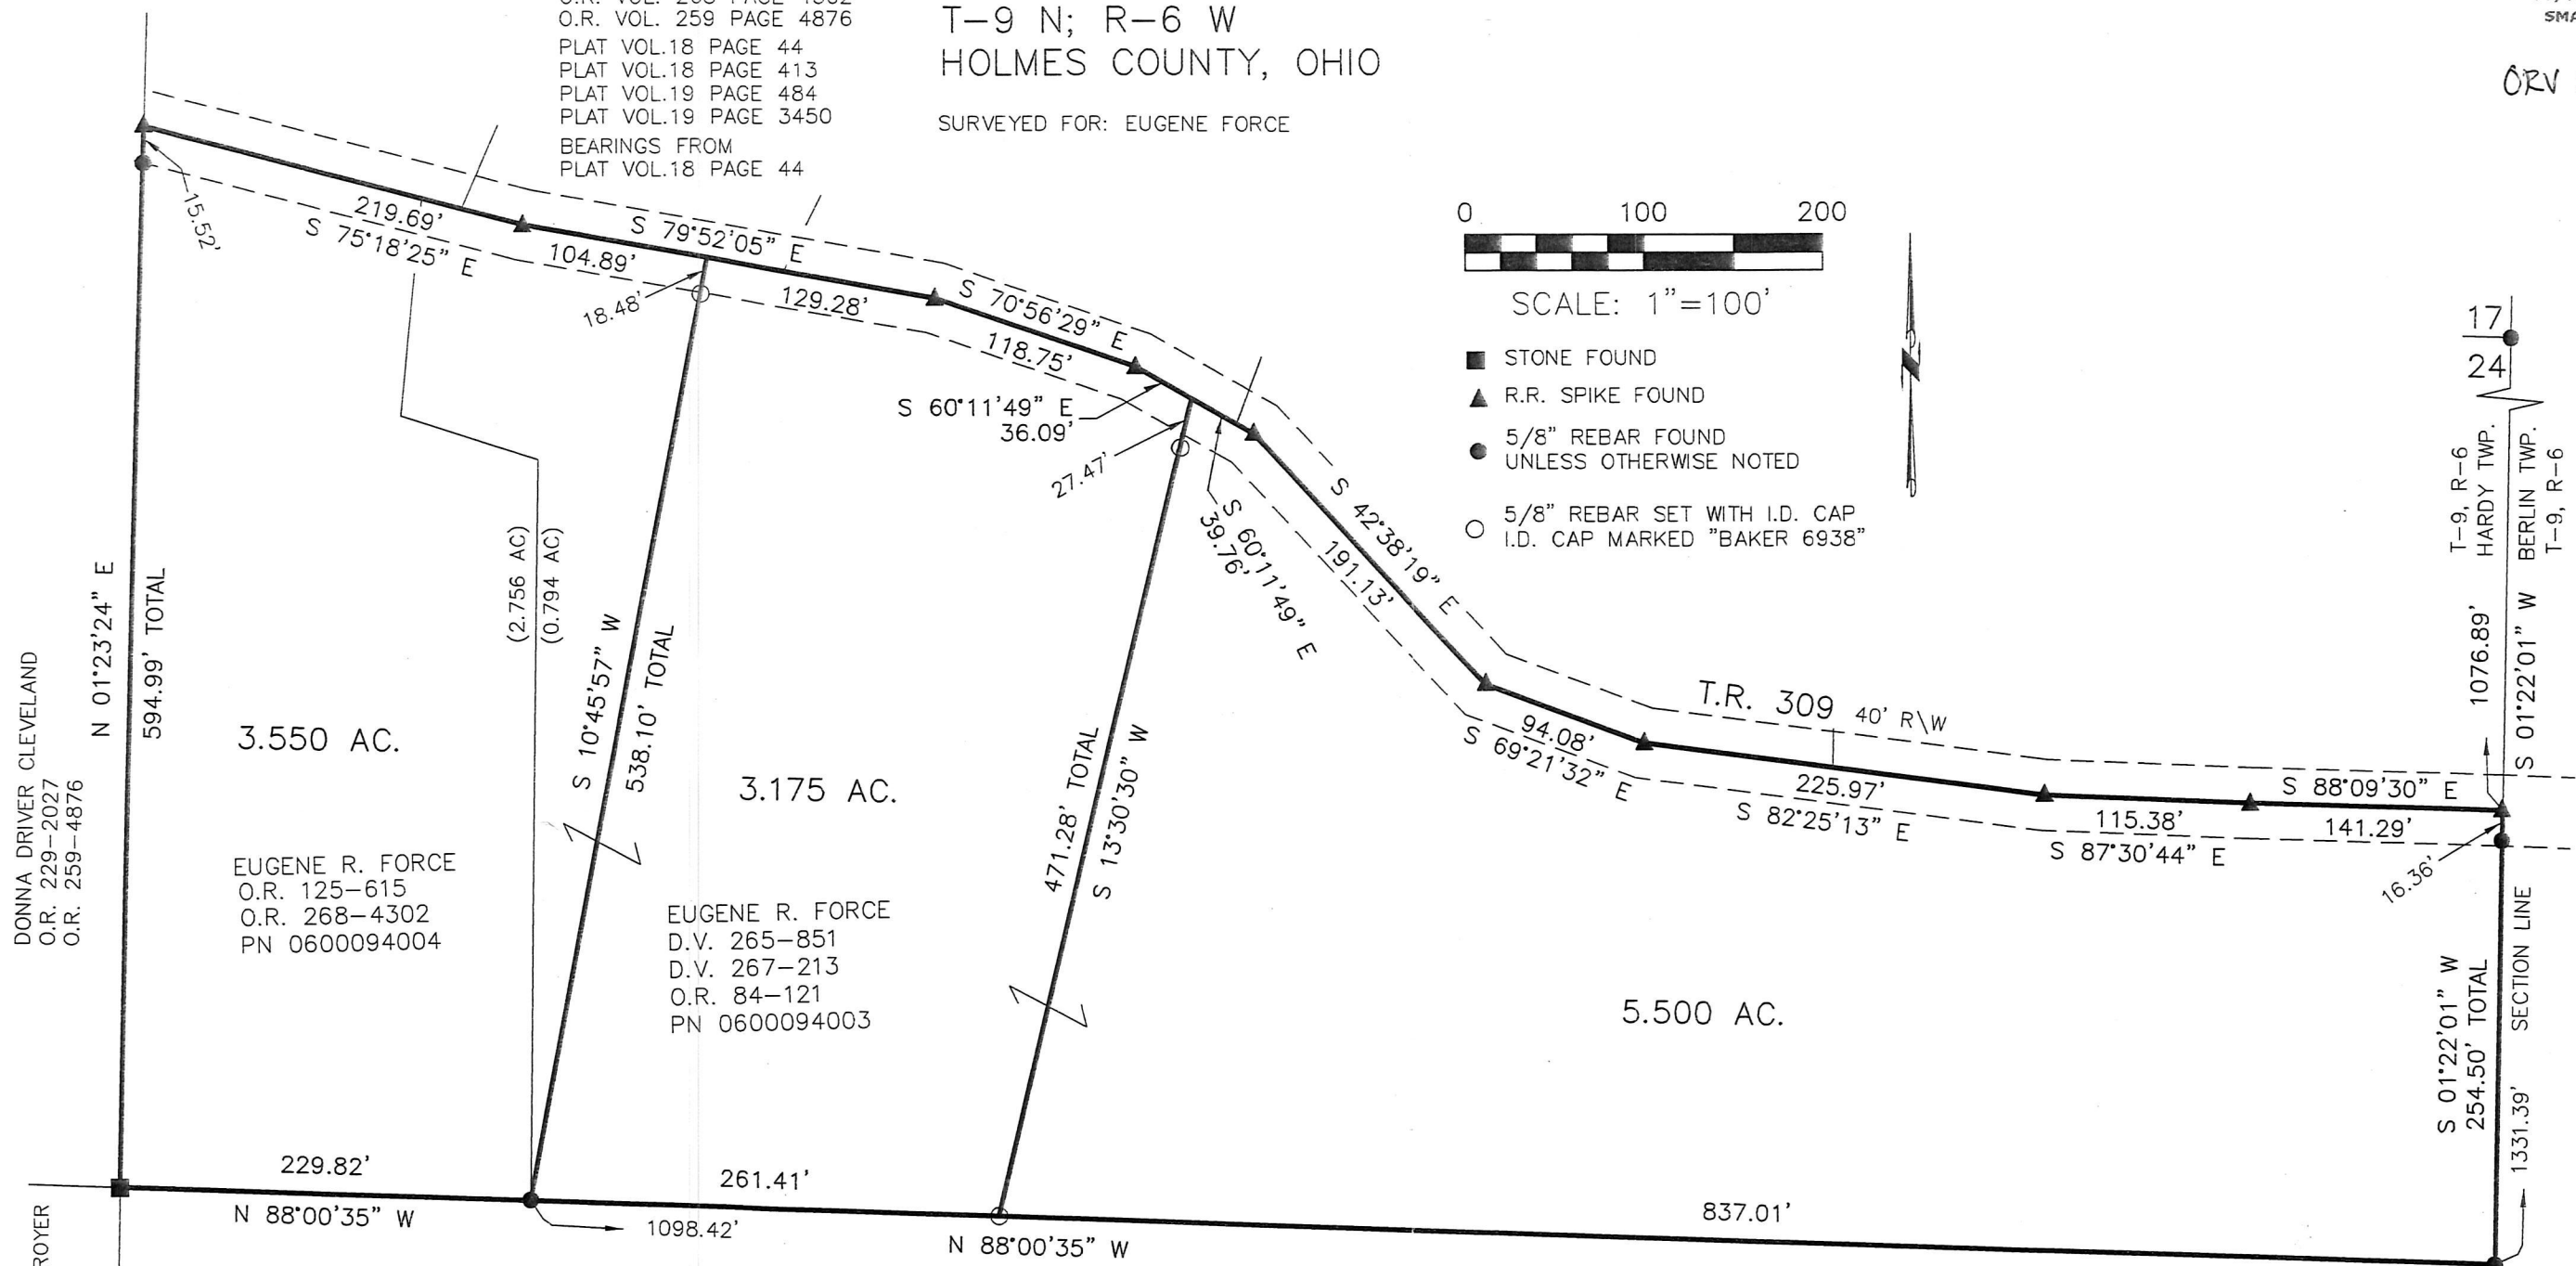

DONNA DRIVER CLEVELAND  
O.R. 229-2027  
O.R. 259-4876

EUGENE R. FORCE  
O.R. 125-615  
O.R. 268-4302  
PN 0600094004

EUGENE R. FORCE  
D.V. 265-851  
D.V. 267-213  
O.R. 84-121  
PN 0600094003

MARY R. RABER, TRUSTEE  
O.R. 157-75  
ERVIN A. RABER, TRUSTEE  
O.R. 157-79

DAVID J. and FANNIE TROYER  
O.R. 86-880

I CERTIFY THIS SURVEY TO BE CORRECT TO THE BEST OF MY KNOWLEDGE.

*Donald C. Baker*

DONALD C. BAKER P.S. 6938  
DATE: JUNE 18, 2019  
FDB/VJD  
FILE NAME: WORK6\S-191-19



BAKER SURVEYING, LLC  
138 N. CLAY STREET  
MILLERSBURG, OHIO 44654  
PH. 330-674-4788  
FAX 330-674-6027

APPROVED FOR TRANSFER ONLY  
NO SUBDIVISION PLAT REQUIRED  
(O.R.C. 711.001 & 711.131)  
Lot(s) not for building unless approved by Board of Health.  
HOLMES CO. PLANNING COMMISSION

By *[Signature]* Date *8/7/19*

PLAT APPROVED

*8/7/2019*