


DN 273 P5064

Knox Township
N.E. Qtr. Section 24
T-19 N; R-15 W
Holmes County, Ohio

SURVEYED FOR: Virginia Landfair

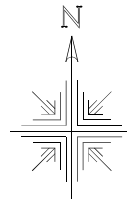

0 100 200


Scale 1"=100'

REFERENCES:

Deeds as shown

- Plat Vol. 19 Page 3864
- Plat Vol. 14 Page 416
- Plat Vol. 19 Page 647
- Plat Vol. 05 Page 83
- Unrecorded survey by William Long dated May 2, 1988
- Unrecorded survey by William Long dated Dec. 10 1986

Basis of Bearing from Grid North, Ohio State Plane
 Coordinate System, North Zone, NAD 83.

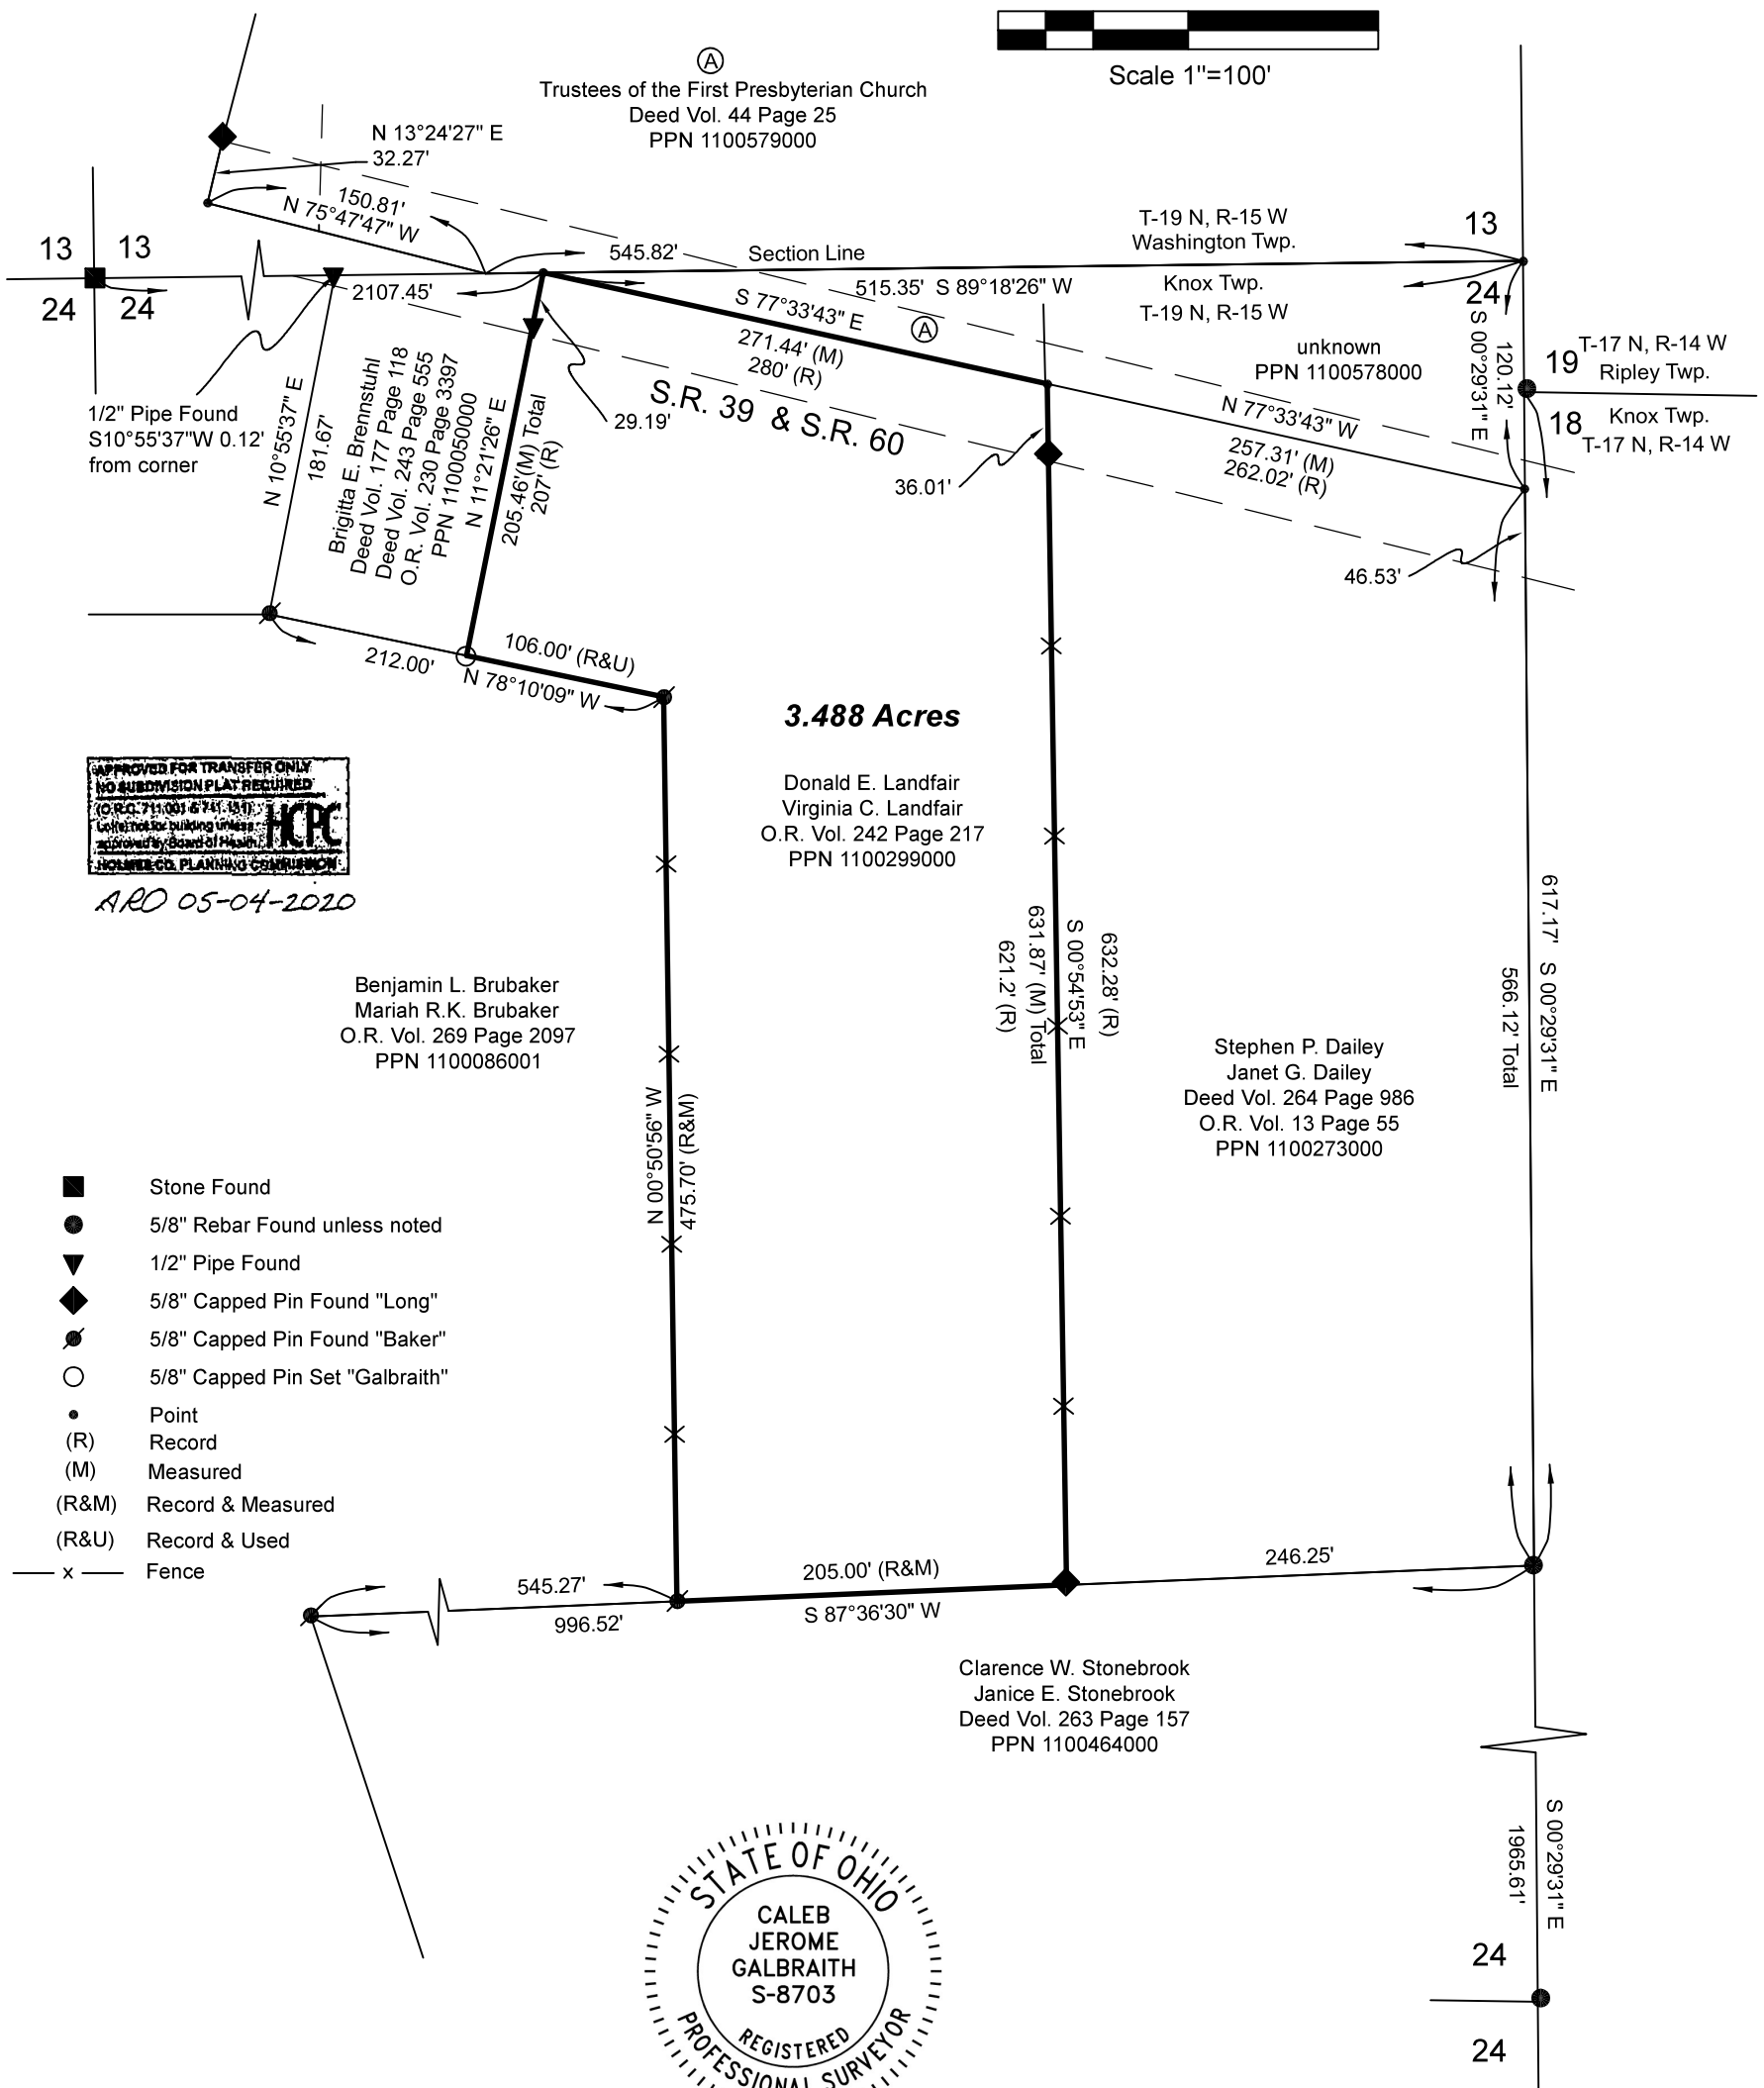

- Stone Found
- 5/8" Rebar Found unless noted
- ▼ 1/2" Pipe Found
- ◆ 5/8" Capped Pin Found "Long"
- 5/8" Capped Pin Found "Baker"
- 5/8" Capped Pin Set "Galbraith"
- Point
- (R) Record
- (M) Measured
- (R&M) Record & Measured
- (R&U) Record & Used
- x — Fence



Pioneer Surveying & Services, LLC.
 5434 Township Road 377
 Millersburg, Ohio 44654
 Phone: 330-231-0497

Email: caleb@pioneersurveyingandservices.com

I certify this survey to be correct to the best of
 my knowledge.

Caleb Galbraith

Caleb Jerome Galbraith P.S. 8703
 Date: March 20, 2020
 Job ID: 3420-H21

Plat Approved
 5/5/2020 TD

