

SALT CREEK TOWNSHIP
3RD. QTR., LOT 6
T-10 N; R-6 W

HARDY TOWNSHIP
N.E. QTR. SECTION 4
T-9 N; R-6 W
HOLMES COUNTY, OHIO

SURVEYED FOR: AARON MILLER

REFERENCES

DEED VOL. 257 PAGE 595
O.R. VOL. 248 PAGE 5962
PLAT VOL. 14 PAGE 62
PLAT VOL. 16 PAGE 491
BASIS OF BEARINGS FROM
PLAT VOL. 16 PAGE 491



I CERTIFY THIS SURVEY TO BE CORRECT
TO THE BEST OF MY KNOWLEDGE.

Donald C. Baker


DONALD C. BAKER P.S. 6938
DATE: JULY 30, 2020
FDB\TAB
FILE NAME: WORK6\S-406-20

0 60 120



SCALE: 1"=60'

- STONE FOUND
- 5/8" REBAR FOUND
UNLESS OTHERWISE NOTED
- 5/8" REBAR SET WITH I.D. CAP
I.D. CAP MARKED "BAKER 6938"

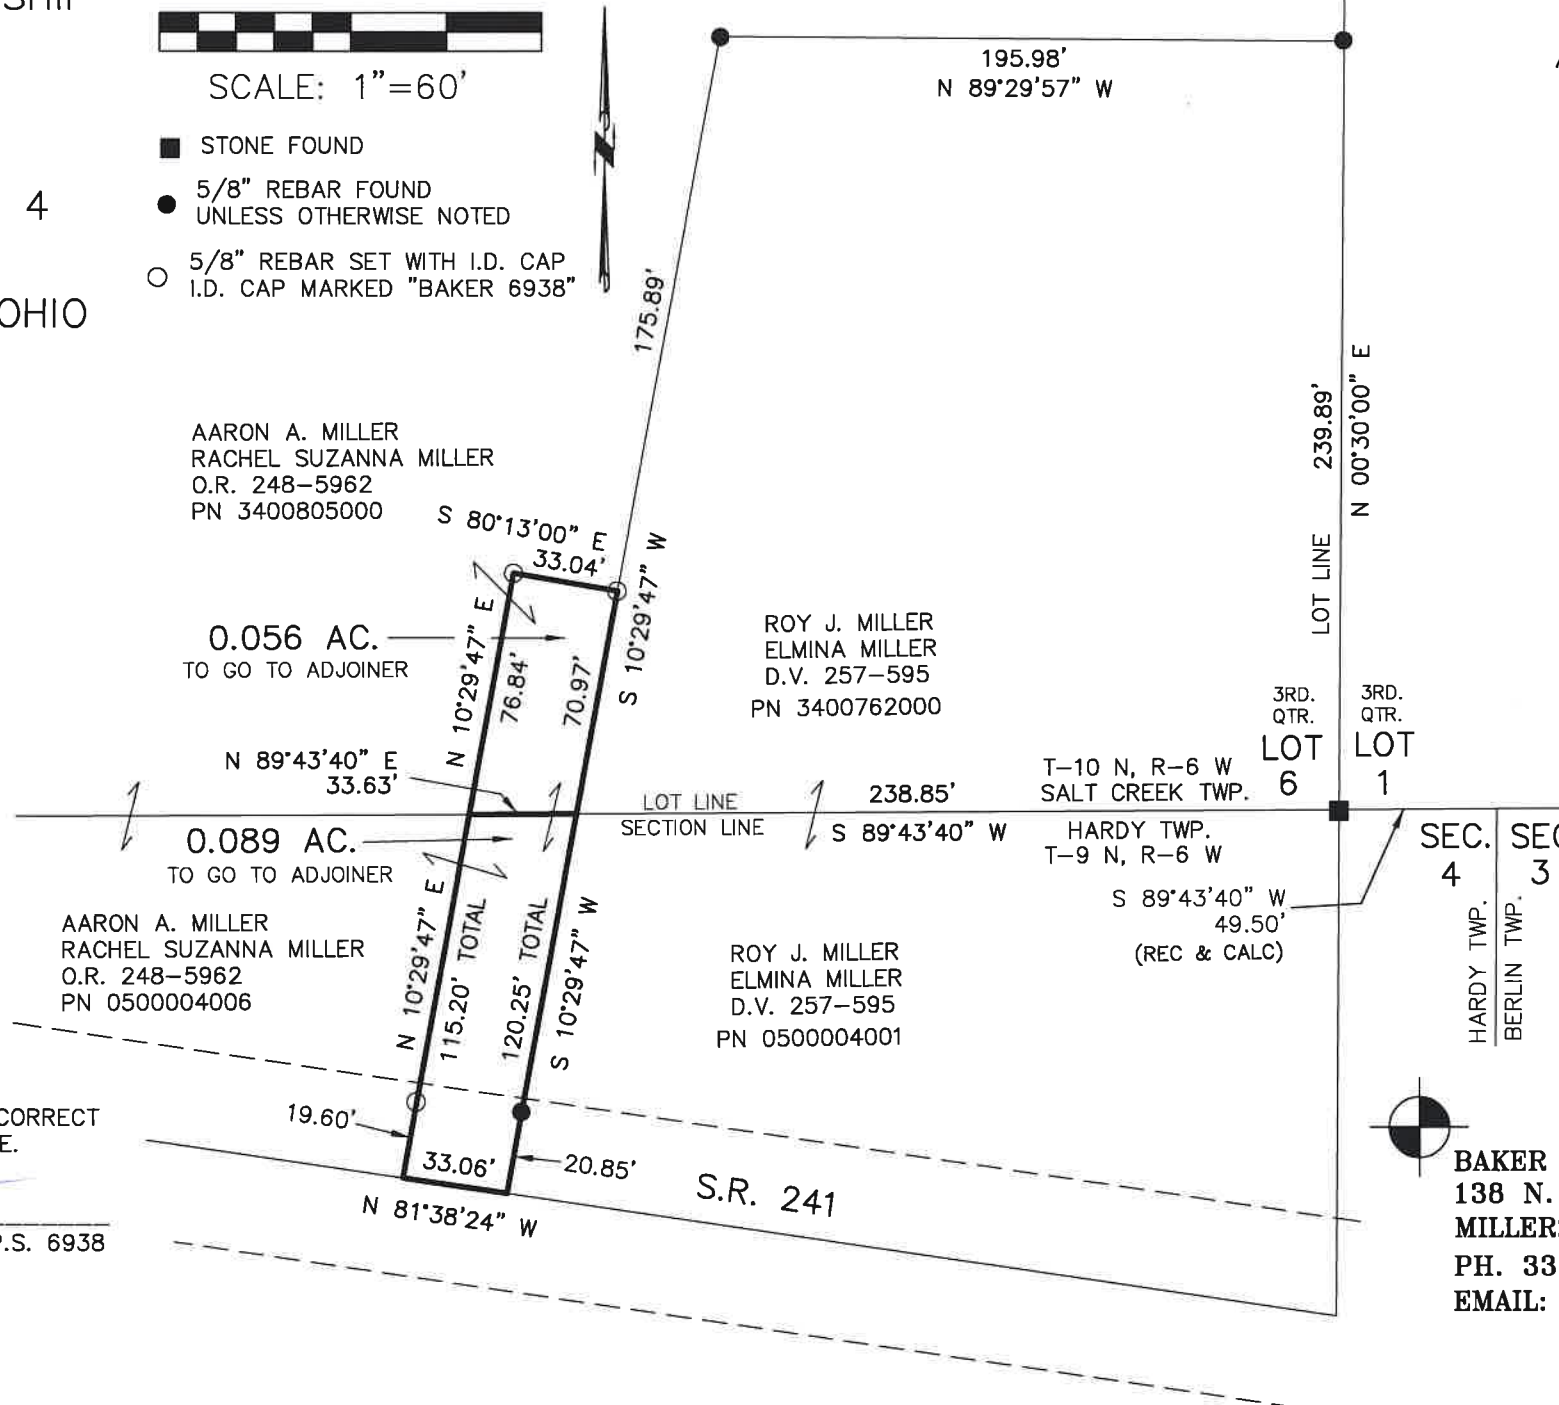

202100013676
B: 19 P: 4308
FILED FOR RECORD IN
HOLMES COUNTY, OH
ANITA HALL, COUNTY RECORDER
02/19/2021 09:34 AM
SMALL PLAT . 40.00
PAGES: 1
ORV 275 PG 6739


APPROVED FOR TRANSFER ONLY
NO SUBDIVISION PLAT REQUIRED
(O.R.C. 711.001 & 711.131)
Lot(s) not for building unless
approved by Board of Health
HOLMES CO. PLANNING COMMISSION
By TS Date 1/26/2021



Plat Approved

Holmes County Map Office

1/25/2021 Rg

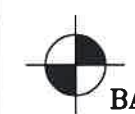

BAKER SURVEYING, LLC
138 N. CLAY STREET
MILLERSBURG, OHIO 44654
PH. 330-674-4788
EMAIL: bakersurveying@gmail.com