

Killbuck Township S.E. Qtr. Section 8 T-8 N; R-8 W Holmes County, Ohio

SURVEYED FOR: Josh Landfair


REFERENCES:

Deeds as shown

ORV 277 P 1467

Plat Vol.19 Page 4152

Basis of Bearing Grid North, Ohio State Plane
Coordinate System, North Zone, NAD 83

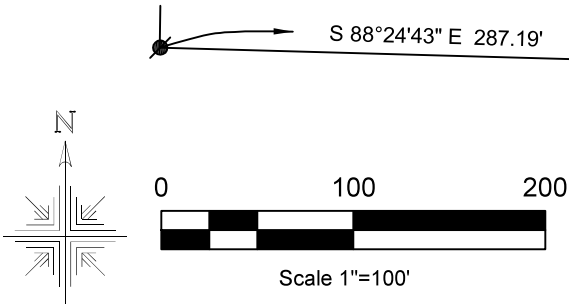

- Stone Found
- 5/8" Rebar Found unless noted
- ⊙ 5/8" Capped Pin Found "Baker"
- 5/8" Capped Pin Set "Galbraith"
- Point



I certify this survey to be correct to the best of my knowledge.

Caleb Jerome Galbraith P.S. 8703
Date: April 26, 2021
Job ID: 8521-H19

Pioneer Surveying & Services, LLC.
5434 Township Road 377
Millersburg, Ohio 44654
Phone: 330-231-0497
Email: caleb@pioneersurveyingandservices.com



APPROVED FOR TRANSFER ONLY
NO SUBDIVISION PLAT REQUIRED

(O.R.C. 711.001 & 711.131)

Lot(s) not for building unless approved by Board of Health

HOLMES CO. PLANNING COMMISSION

By AO Date 5/11/2021



Plat Approved

Holmes County Map Office

5/11/2021 Rg

