

Mechanic Township  
S.E. Qtr. Section 2  
T-8 N, R-6 W  
Holmes County, Ohio

Surveyed For: Myron Hershberger

20220000924


B: 19 P: 4635  
FILED FOR RECORD IN  
HOLMES COUNTY, OH  
ANITA HALL, COUNTY RECORDER  
02/28/2022 12:12 PM  
SMALL PLAT . 40.00  
PAGES: 1  
ORV 280 PG 4381

REFERENCES:


Deeds as shown

- Plat Vol. 18 Page 212
- Plat Vol. 18 Page 101
- Plat Vol. 11 Page 167
- Plat Vol. 19 Page 3483
- Plat Vol. 18 Page 605
- Plat Vol. 19 Page 3904
- Plat Vol. 19 Page 4168
- Plat Vol. 19 Page 129
- Plat Vol. 19 Page 2561
- Plat Vol. 19 Page 2534

Basis of Bearings from Grid North, Ohio State Plane Coordinate System, North Zone, NAD 83.

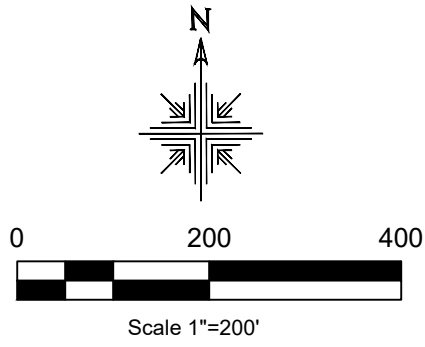

- Stone Found
- ⊙ Pipe Found
- 5/8" Rebar Found unless noted
- 5/8" Capped Pin Found "Baker"
- 5/8" Capped Pin Found "Galbraith"
- ▲ 5/8" Capped Pin Found "RLK"
- 5/8" Capped Pin Set "Galbraith"
- Point

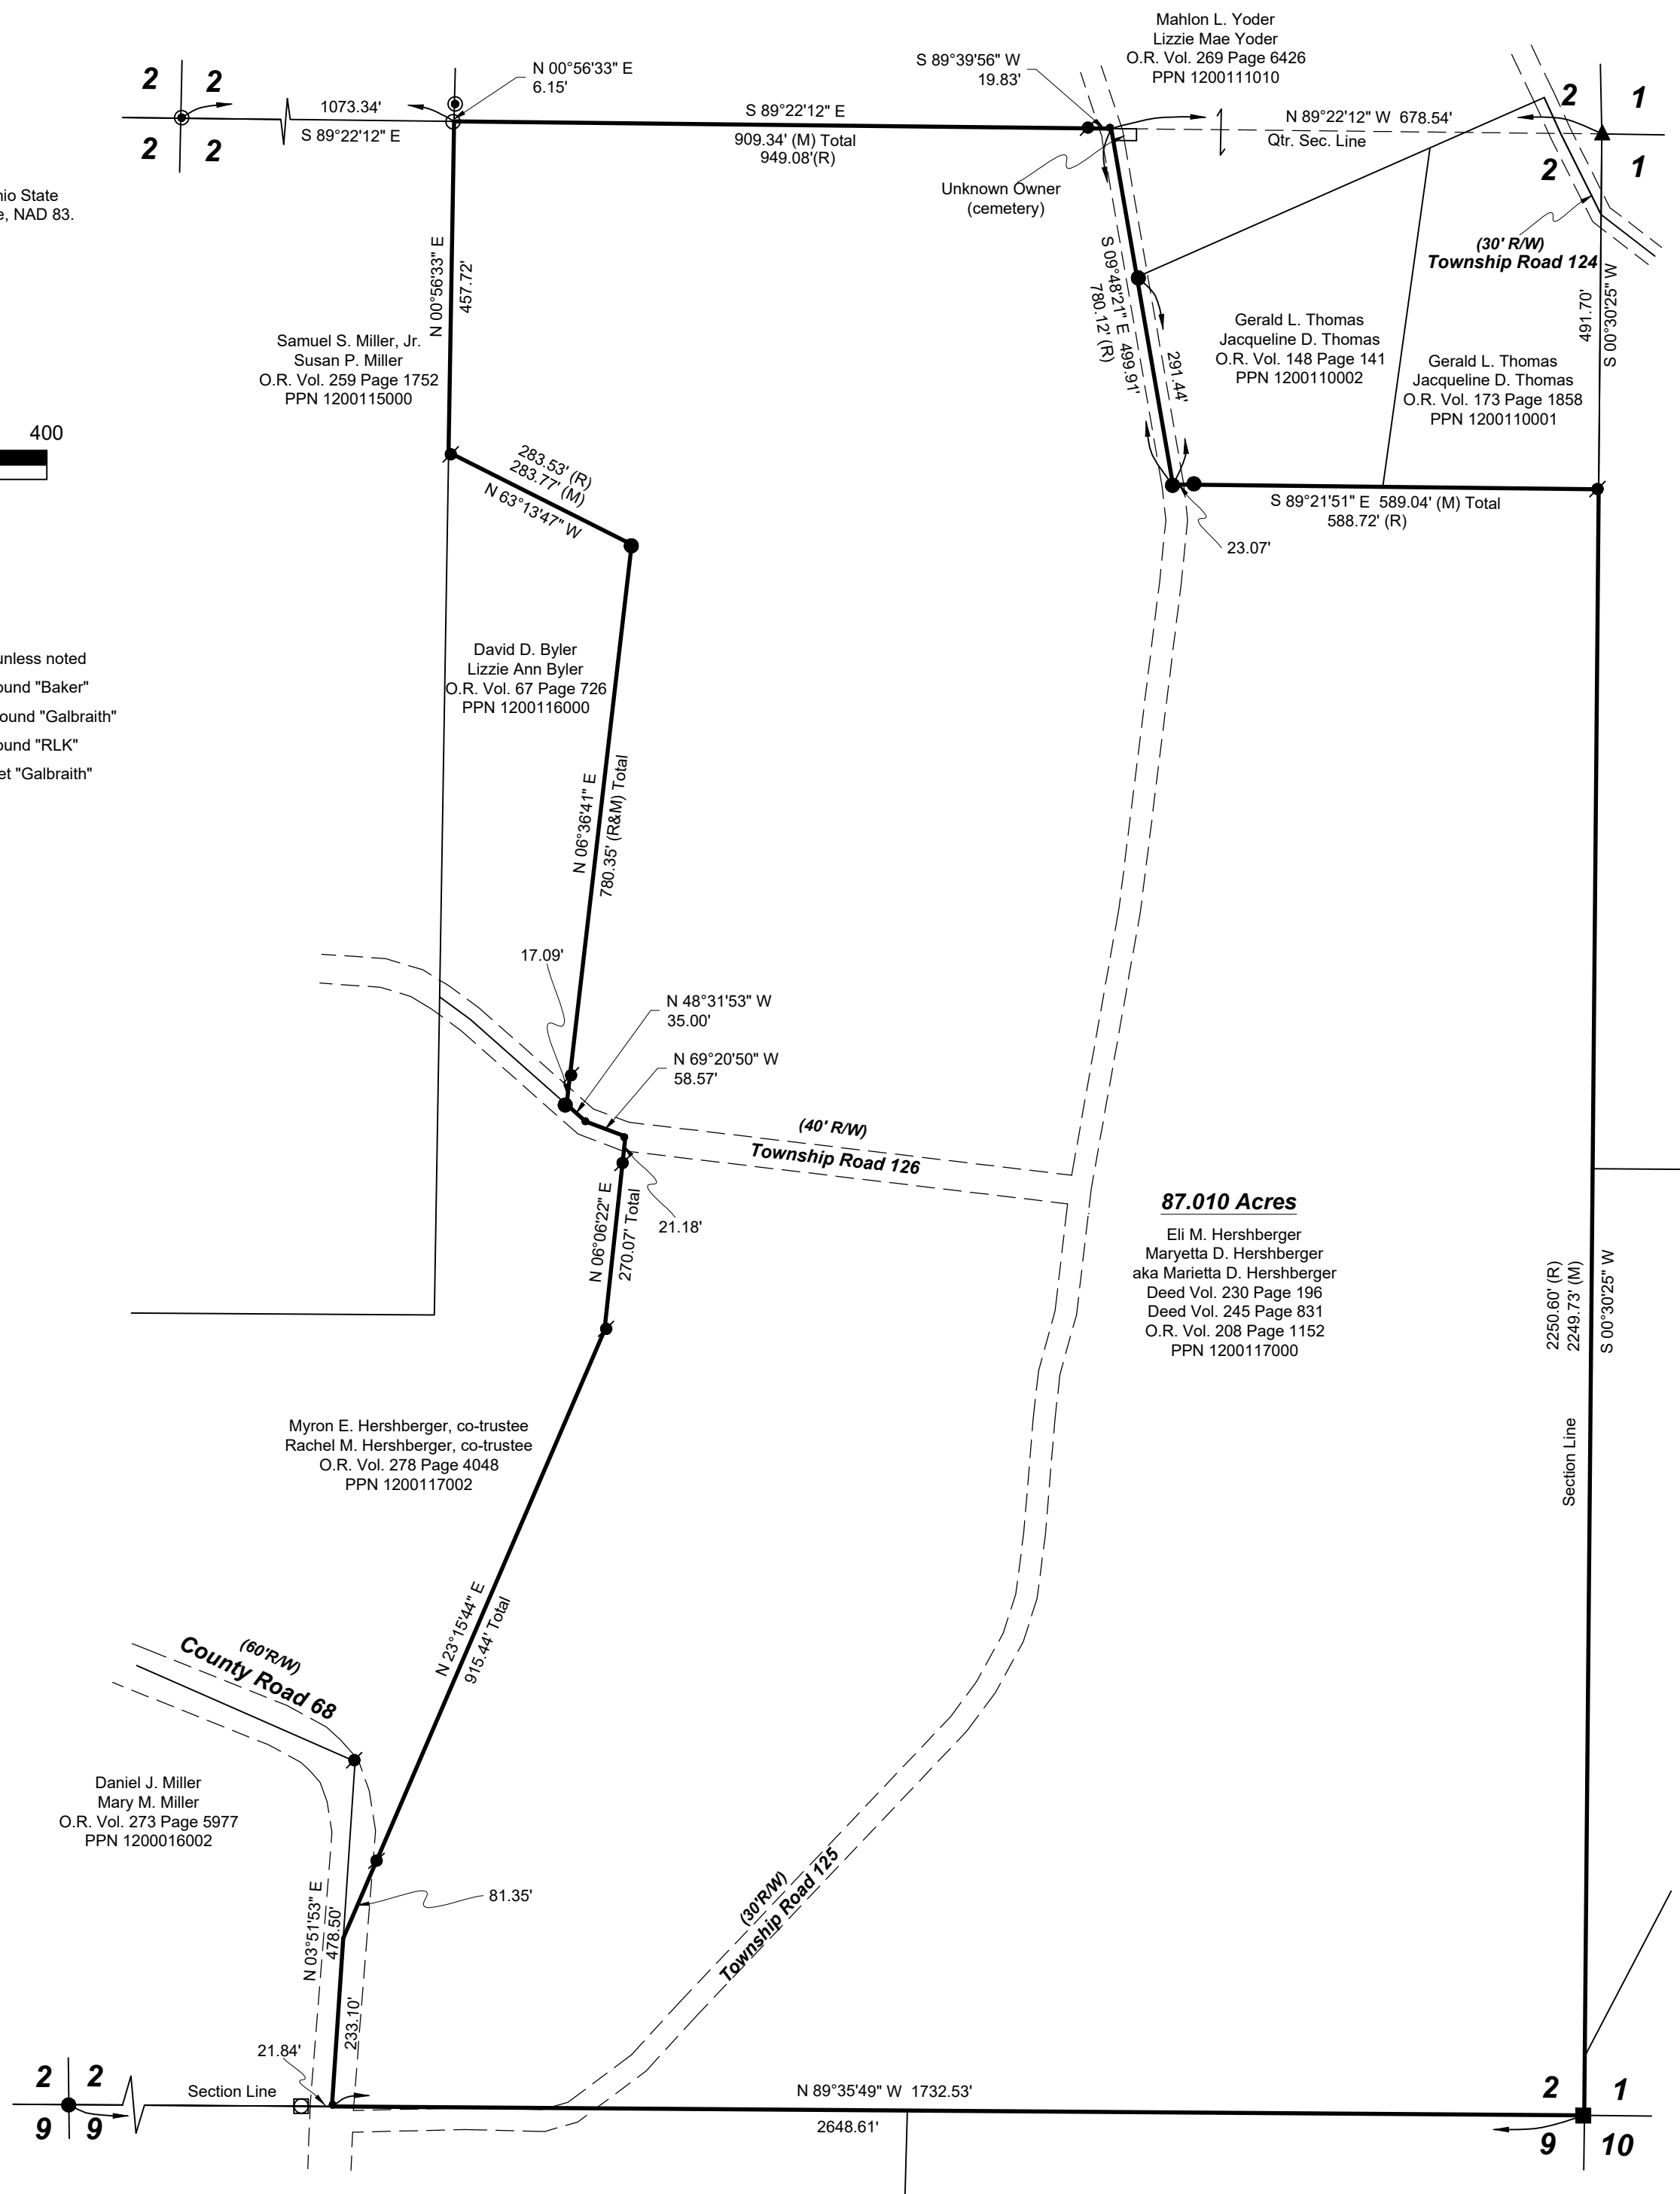

Pioneer Surveying & Services, LLC.  
5434 Township Road 377  
Millersburg, Ohio 44654  
Phone: 330-231-0497  
Email: caleb@pioneersurveyingandservices.com



CERTIFICATE OF ACCURACY

I certify this survey to be correct to the best of my knowledge.

Caleb Jerome Galbraith P.S. 8703  
Date: Jan. 12, 2022  
Job ID: 24421-H23



APPROVED FOR TRANSFER ONLY  
NO SUBDIVISION PLAT REQUIRED

(O.R.C. 711.001 & 711.131)  
Lot(s) not for building unless approved by Board of Health  
HOLMES CO. PLANNING COMMISSION  
By AO Date 2/02/2022

Plat Approved

Holmes County Map Office

1/31/2022 BH