

202300001956
B: 19 P: 5002
FILED FOR RECORD IN
HOLMES COUNTY, OH
ANITA HALL, COUNTY RECORDER
05/17/2023 08:52 AM
SMALL PLAT . 40.00
PAGES: 1

ORV 285 Pg 3956

Paul J. Miller
Barbara L. Miller
OR 275/1951
PPN 1500305005

Roman J. Miller
Ella N. Miller
OR 265/256



I believe this survey to be correct
to the best of my knowledge.

Edward A. Gasbarre
Edward A. Gasbarre, P.S. 7036

1/03/23
Date


APPROVED FOR TRANSFER ONLY
NO SUBDIVISION PLAT REQUIRED
(O.R.C. 711.001 & 711.131)
Lot(s) not for building unless
approved by Board of Health
HOLMES CO. PLANNING COMMISSION
By AO Date 4/25/2023



Plat Approved

Holmes County Map Office

4/25/2023 MM

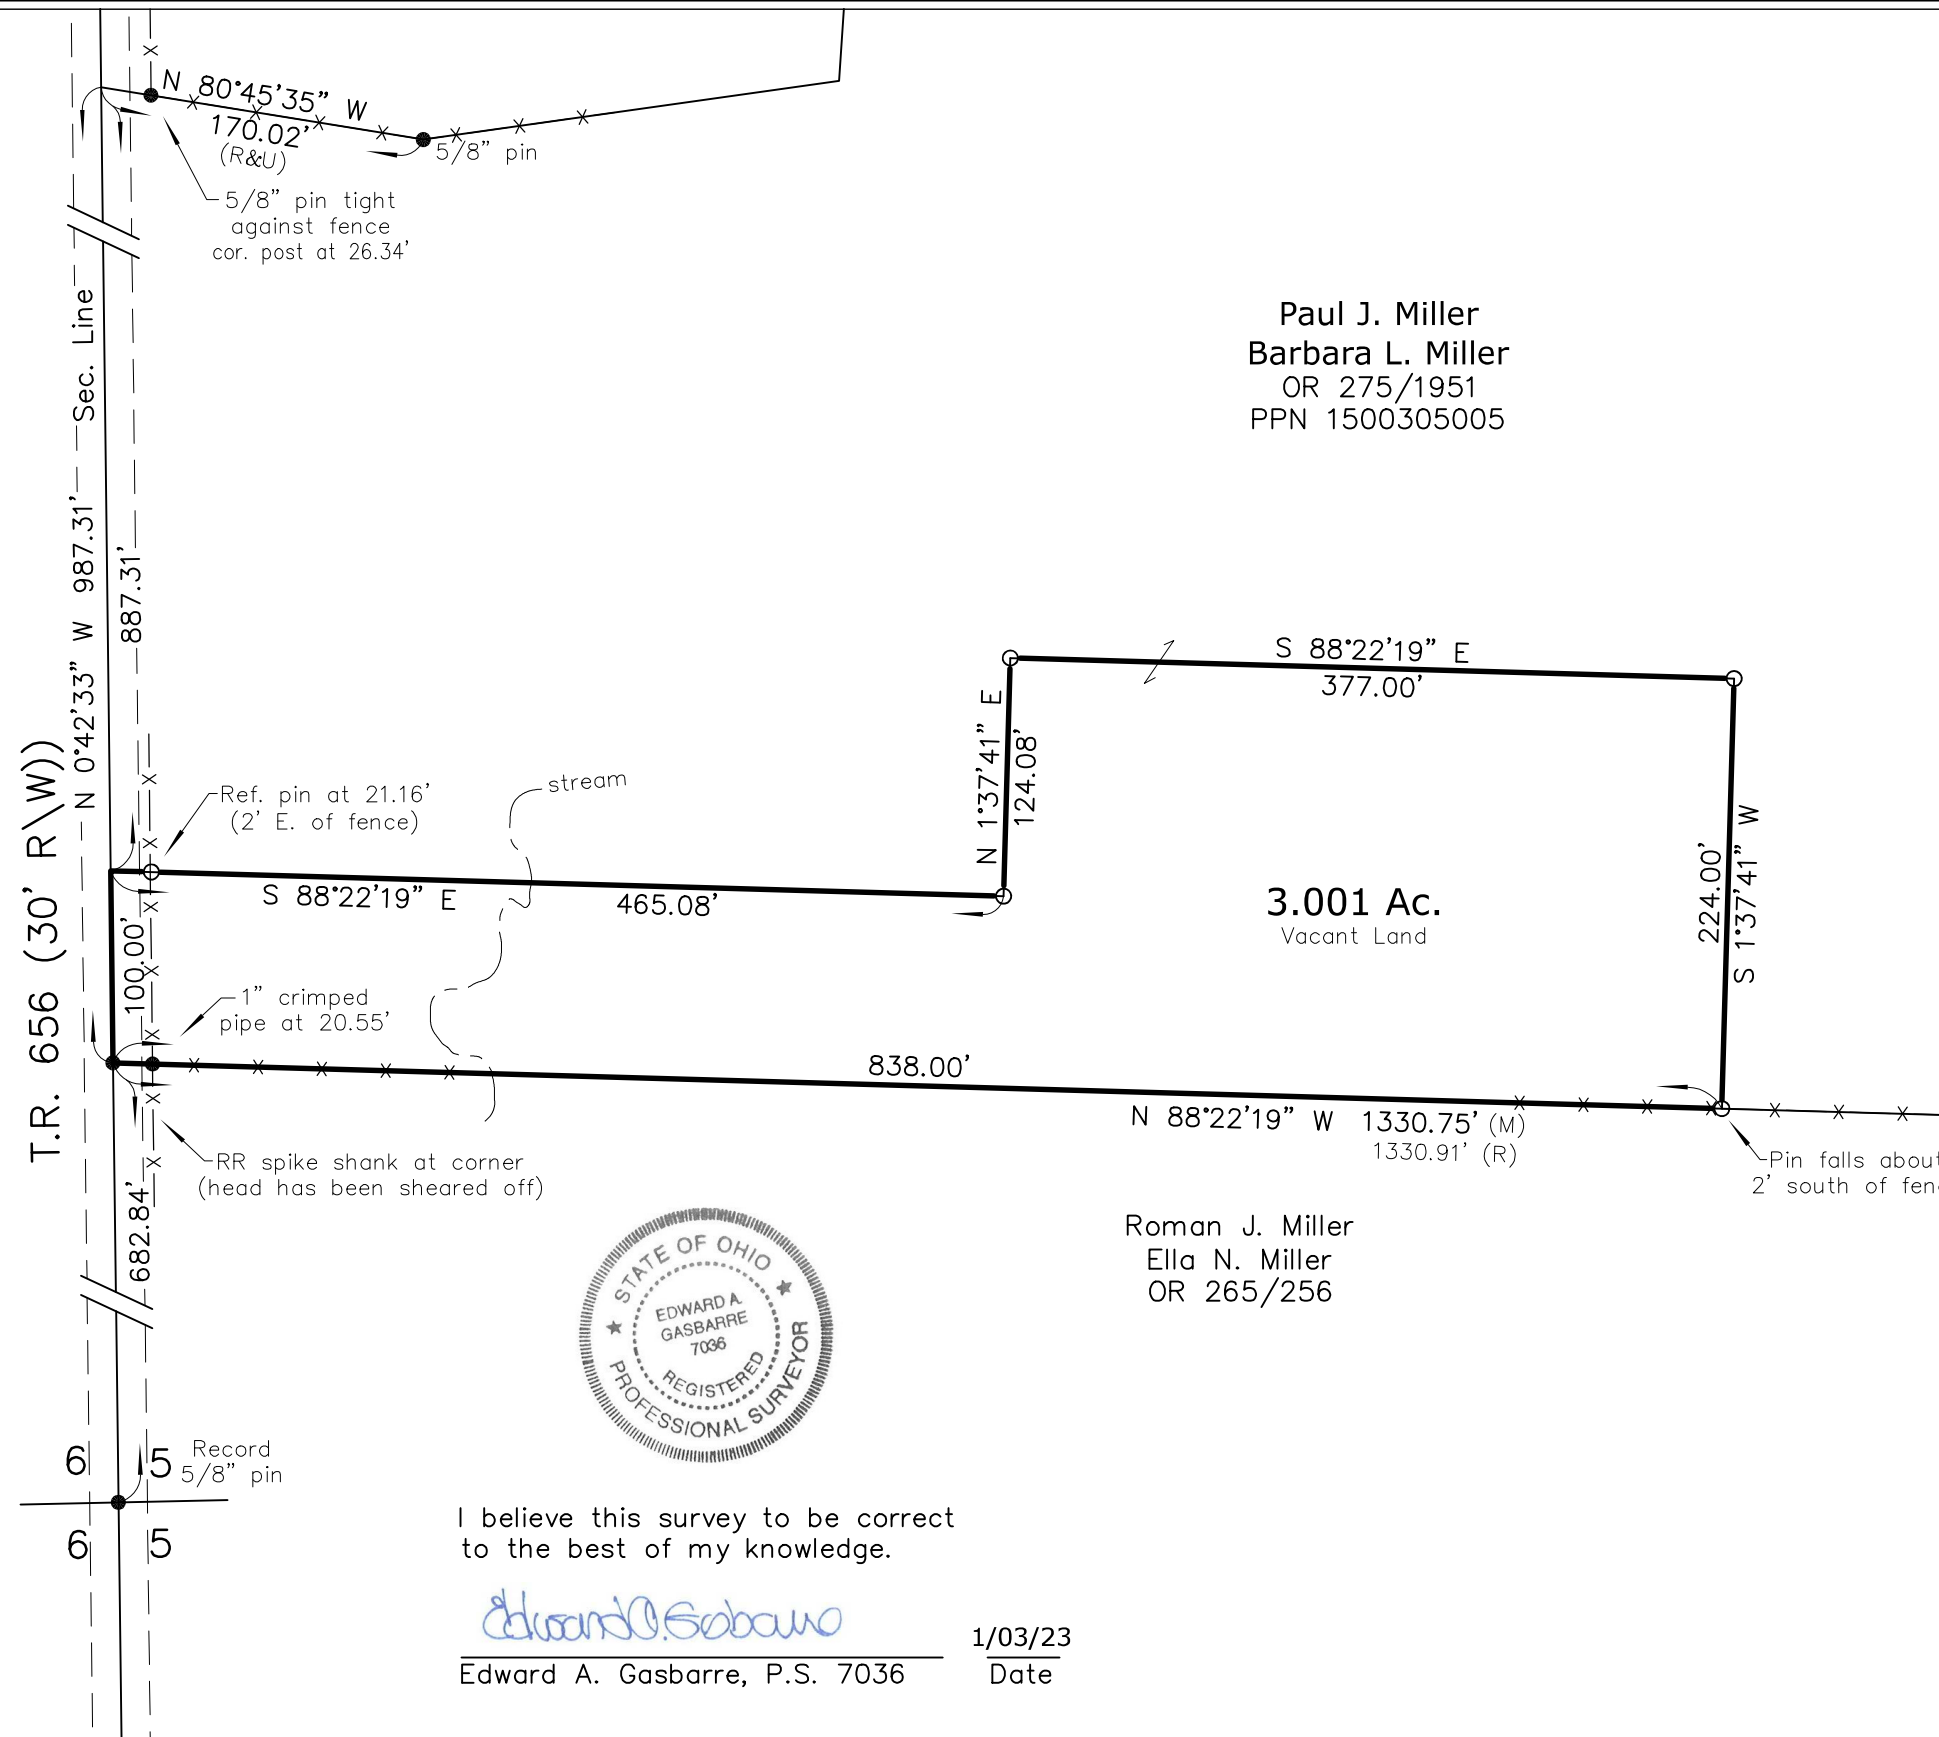


P. & B. Miller Split Survey

Paint Township, NW Qtr. Sec. 5, T-14N, R-11W
Congress Lands North of the Old Seven Ranges
Holmes County, Ohio

Legend

- set ∅ set previously ● found △ - Spike or magnail set
- 5/8"x30" Steel Rod W/Yellow I.D. Cap ▲ - Spike or magnail found
- Marked "Gasbarre Wooster, Ohio" X-X Fence Line Evident
- - Iron/Steel monument found R - Record Dimension
- Described in Drawing M - Measured Dimension
- - Stone monument found U - Used Record Dimension

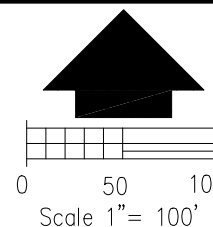

Basis of Bearings south property line per P.V. 19, Pg. 4265.
Ref. Surveys: P.V. 10, Pg. 667, P.V. 12, Pg. 462, P.V. 18, Pg. 854, P.V. 19, Pg. 660
Drawing: 222091.dwg January 3, 2022

R.W. **Gasbarre** & Associates, Inc.
Professional Land Surveying
401 South Market St. - P.O. Box 44
Wooster, Ohio 44691
PH 330-264-9499