


West

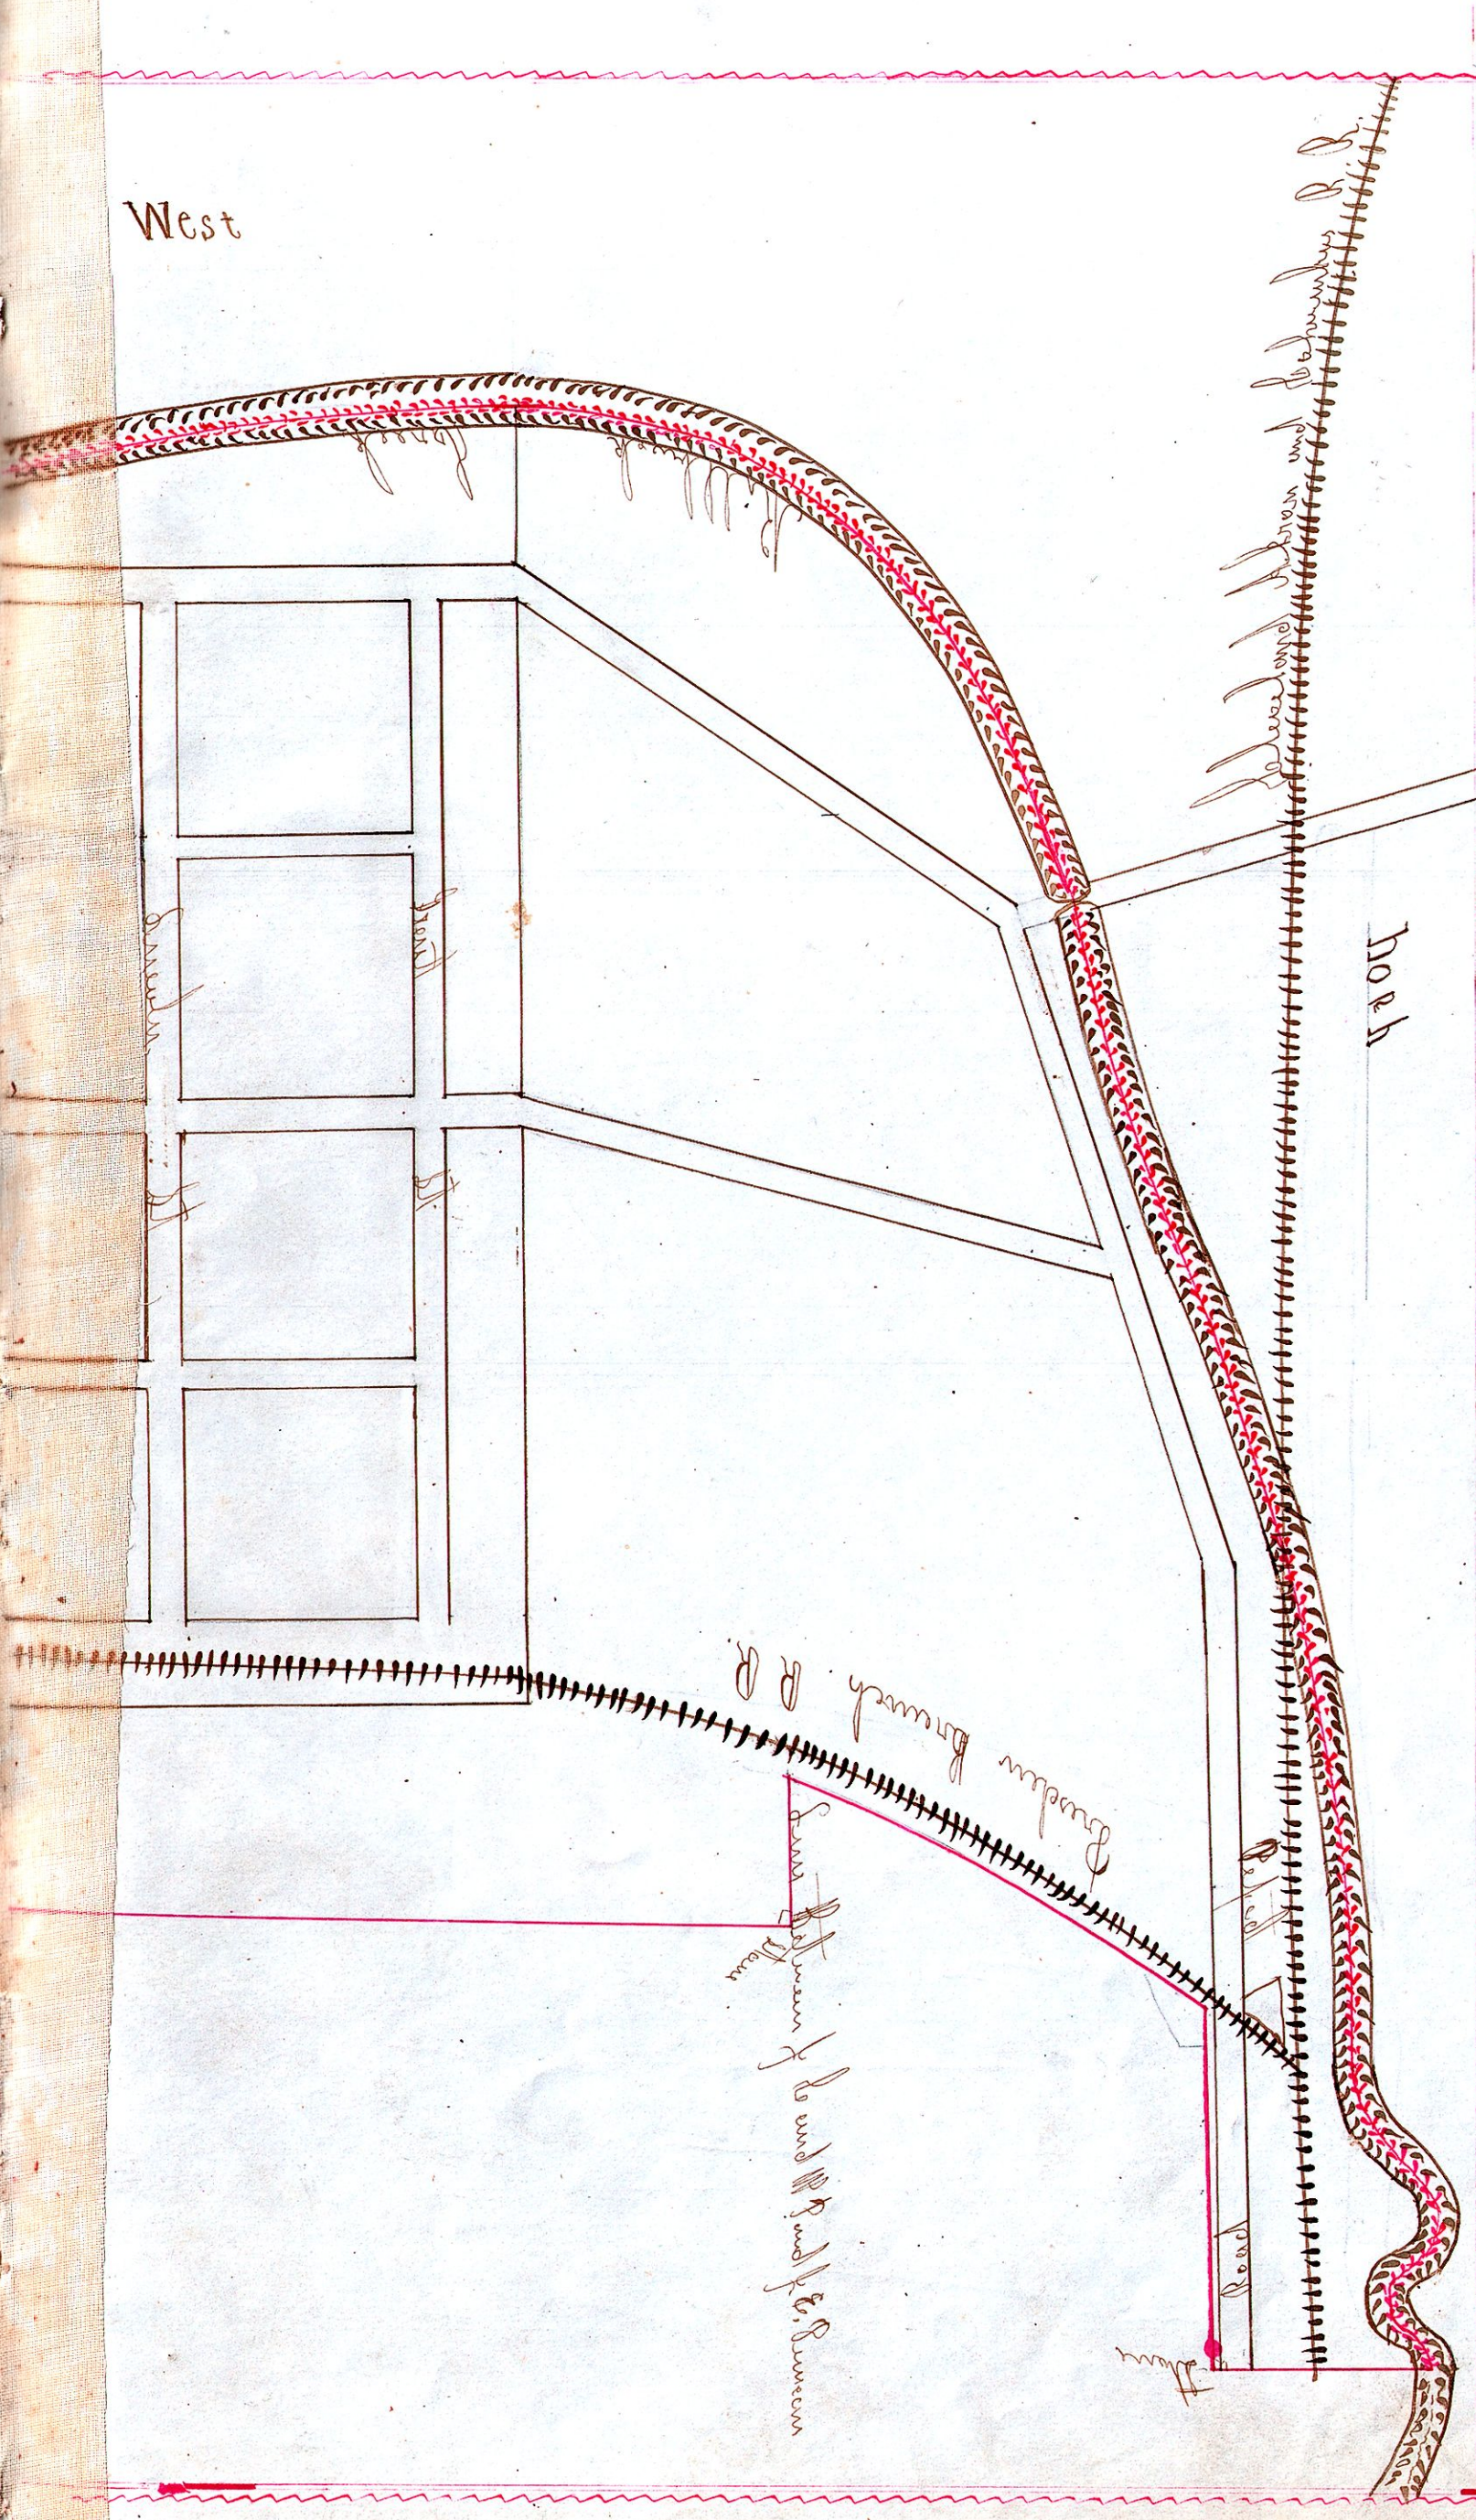

Black line indicates old Corporation limits Red line as extended

Petition for Annexation

304

Petition and Plat
of the
Additions to the
Incorporated Village of
the Village of Killbuck

Transcript of the Commissioners Journal
 of the Proceedings before the Board of Commissioners
 in the Matter of the Annexation of the Territory to the
 Incorporated Village of Killbuck Ohio
 Commissioners Journal Vol 9 Page 14 March
 Session 1895. Auditor's office Holmes county
 Millersburg Ohio, March 1895. In the matter of the Annexation of Territory to the
 Incorporated Village of Killbuck Ohio.

On the 4th day of March 1895. Said Board being in regular session
 A Petition was presented to said Board praying for the annexation of certain territory
 in said petition described: to to the incorporated Village of Killbuck Ohio, which was
 duly filed on said day in the office of the Auditor of said county.

This Board fixed the 7th day of May 1895, at 10 A.M. at the courthouse
 in said County for the hearing of said Petition and ordered notice to be given of
 the time and place of said hearing in the Holmes county Journal used by Posters
 in the County sought to be annexed as provided by law.

Commissioners Journal Vol 9 Page 23 May Session 1895, Auditor's office
 Holmes County Millers Ohio, May 7th 1895

In the matter of annexation of certain Territory to the Incorporated Village of
 Killbuck Holmes County Ohio,

Before the Board of Commissioners of Holmes county Ohio
 This Matter this 7th day of May 1895, came on for hearing pursuant to the order
 made by this Board March 4 1895, with the full Board present and it being
 established to the satisfaction of the Board by public hearing this day by
 evidence that the Incorporated Village of Killbuck Ohio, through its council
 duly passed an ordinance by a majority vote thereof authorizing the annexation
 to said Village the territory in the Petition described, that said Village by said
 ordinance authorized its Solicitor to prosecute the proceedings necessary to
 effect such annexation that the Petition herein was presented to this Board
 at its regular March Session 1895, and was duly filed in the office of the
 Auditor of said County, that said Petition states further that under said
 ordinance passed by said Village as aforesaid, the territory in said Petition described
 was authorized to be

annexed to said Village; that the Petition contains an accurate
 description of said territory that said Petition is accompanied by an accurate
 Plat of said territory that said Petition is signed by the persons authorized
 by law and the said ordinance to prosecute the proceedings for the annexation of
 said territory to said Village; that notice containing the substance of the
 Petition and the time and place of this hearing was published in the Holmes
 County Journal or Newspaper printed and of general circulation in said
 Holmes County, for a period of six consecutive weeks prior to the hearing
 and commencing in the issue of paper on the 7th day of March 1895,
 that copies of said Notice were posted on each of the several tracts proposed
 to be annexed to said Village

On the 14th day of March 1895, the same being not less than six weeks prior to the hearing; and that all necessary preliminary steps in this matter have been properly taken, and said board of commissioners viewing same to pass on the merits of this matter from the testimony, find that the Petitioner contains all the matters required by the statutes in such cases that the statements of the Petitioner are true that the tract of each of said tracts proposed to be annexed to said village are accurately described and are not in either tract unnecessarily large or small; that the map or plat accompanying said Petition and bounding the several tracts proposed to be annexed is accurate, that the Person who name is subscribed to said Petition was duly authorized in the premises by said village; that notice has been given as required; that it is right and proper that the prayer of said Petition be granted; It is therefore on this 17th day of May 1895. ordered by the Board that the territory described in said Petition be and the same is hereby annexed to said Incorporated Village of Killbuck and made part thereof as prayed for in the Petition; that the recorder enter all the proceedings and orders made by the board in this matter upon the journal and cause a transcript thereof together with the petition and plat to be forwarded to the Clerk of said Incorporated Village

R. P. Samuel
 J. M. Spencer
 Daniel Helmuth

Commissioners

J. D. Seifer, Sec J. M. Spencer, Pres
 authorized by virtue of an ordinance passed by the council of the incorporated Village of Killbuck Ohio. by a majority vote thereof at a meeting held on the 7th day of February 1895. the following territory hereafter described was authorized by the action of said council in the passage of said ordinance (a copy of which is herewith attached) to be annexed to the said incorporated Village to wit: Beginning at the south west corner of the occupation line at the south side of alley and center of Killbuck creek; thence south in the center of said creek to a stone on bank of said creek; thence in easterly direction sixty (60) feet north of Joseph Kaufman's picket fence to a stone on hill; thence in northerly direction to the south west corner of graveyard fence; thence northerly along said fence to J. D. and W. Duvessins fire fence; thence west on line of said fence to the East line of the Right of way of the Dresden branch Railway; thence in a northerly direction on said easterly line of Right of way to the Public Road fence; thence in North East direction along said fence to a stone; thence North to center of Killbuck creek;

Thence South in center of Killbuck Creek to the place of Beginning;
A plot of said Territory above described is herewith attached and made part
of this Petition and filed herewith and shews the lines and boundaries
of said Territory to be annexed as aforesaid to said Village,

Said ordinance further authorizes and delegates P. P. Bass, to proceed as soon
- practicable and to proceed according to law and cause said Territory to be annexed
to said Village. Therefore I P. P. Bass, pray your honorable body to take such
action as is provided by law to cause said Territory to be annexed to said Village
And we the undersigned land owners residing on said Territory to be annexed
do ask of your honorable body to grant this our Petition and Prayer and that
the said Territory as described in this Petition be annexed to the Incorporated
Village of Killbuck Ohio.

J. A. Gray
W. A. Beard
M. E. Purdy, M.P.

J. A. Burkwood
J. J. Rogers
A. A. Bell

And we the undersigned land owners of said Territory to be annexed but
residing in the said corporation of this Village of Killbuck Ohio do ask of
your honorable body to grant this our Petition and Prayer that the said Territory
as described in this Petition be annexed to the said corporation of the
Village of Killbuck Ohio

John Fisher Charles D. Rogers M. W. Seywillan J. J. Pusey
Filed March 4th 1845, J. B. Sefer Auditor

I do hereby certify this to be a true copy of uncorrection papers
of the Holmes County Commissioners upon an file in my office
at the Village of Killbuck in said County

A. E. Rykendaal
Clerk of said Village

309

Ordinance No 45


Thence South in center of said Creek to a stone on bank of said Creek thence in Easterly direction sixty (60) feet North of Joseph Carpenters Picket fence to a corner stone on hill, thence in a Northerly direction to the South West corner of brownwood fence thence Northerly along said fence to J. C. and W. Cummings line fence. Thence west on line of said fence to the East line of Right of way of the Dresden branch Railway. Thence in Northerly direction on said Easterly line of Right of way to the Public Road fence. Thence in a Northerly direction along said fence to a stone. Thence North to center of Killbuck Creek. Thence South in center of creek to place of beginning.

Sec 2nd be it further ordained that P. P. Base be and is hereby appointed to prosecute the proceedings necessary to complete such annexation according to law
Sec 3rd be it further ordained that this ordinance shall be in force from and after its passage and due notice given by posting as required by law, done at the council chamber this 11th day of January A.D. 1895,

By a majority vote of Council

O. A. Shrimplin
Relief
Deed

Seal

P. P. Base Mayor of Killbuck Village Ohio

I do hereby certify this to be a true copy as passed as aforesaid of the above ordinance
P. P. Base Mayor,



Sec 1st that the application of the council of the Incorporated Village of Killbuck in said county and others for the annexation of the following described Territory to the Village of Killbuck: a certified transcript of the Proceedings of the County Commissioners together with the Petition Map and other papers relating thereto are on file with the Village Clerk. A. S. Beginning at the South West corner of the Corporation line at the South side of alley and center of Killbuck Creek. Thence South in center of said Creek to a stone on bank of said Creek; Thence in a Easterly direction sixty (60) feet North of Joseph Carpenters Picket fence to a corner stone on hill; Thence in a Northerly direction to the South West corner of brownwood fence.

Thence Northward along said fence to S. B. and M. P. Purness line fence;
 Thence west on line of said fence to the East line of Right of way of the
 Brecken Branch Railway; Thence in a Northward direction on said Easterly line
 of Right of way to the Public Road fence; Thence in a North East direction
 along said fence to a stone; Thence North to center of Killbuck Creek;
 Thence South in center of said creek to the place of beginning; he end is hereby
 accepted.

Sec 2 This ordinance shall take effect and be in force from and after
 the Expiration period allowed by Law: Passed this 15th day of July A.P. 1895,
 A. E. Kirkendall John M. Lacey
 Clerk of said Village Mayor

I do hereby certify this to be a true
 copy of the ordinance Passed by the Council of the Corporation Village
 of Killbuck on July 15th 1895.
 A. E. Kirkendall, Clerk

Notice of Assessment.

Notice is hereby given that a petition was filed in the exaction office of
 Holmes County, Ohio, on the fourth day of March 1895, praying for the
 Assessment of the following described Property to the Village of
 Killbuck Ohio, to wit

Beginning at the South west corner of the Corporation line at the South
 side of alley and center of Killbuck creek thence South in center of said
 creek to a stone on bank of said creek, thence in a Easterly direction sixty (60)
 feet North of Joseph Barchenters picket fence to a corner stone on hill
 Thence in a Northward direction to the South west corner of graveyard
 fence, thence Northward along said fence to S. B. and M. P. Purness
 line fence, thence west on line of said fence to the East line of Right of way
 of the Brecken Branch Railway, thence in a Northward direction on said
 Easterly line of Right of way to the Public Road fence; Thence in a North
 East direction along said fence to a stone; Thence North to center of Killbuck
 Creek, thence South in center of Killbuck Creek, to Place of beginning.

Said Petition will be for hearing on the 7th day of May 1895, at 10 o'clock
 in the court house in Millersburg Ohio.

By order of Commissioners March 7th 1895,

J. D. Newton, being first duly sworn
 says that he is the publisher of the Holmes County Farmer, a weekly
 Newspaper printed and published in the County of Holmes and State
 of Ohio, and having a general circulation therein, that the Notice, a
 copy of which is herewith attached was published in said Holmes
 County Farmer for 6 consecutive weekly Publications,
 commencing on the 7th day of March 1895;

J. D. Newton

Sworn to by said J. D. Newton before me and by him subscribed
 in my presence this 17th day of June A.P. 1895.

R. W. Jammyhill Probate Judge

Received for Record July 25 A.P. 1895,

Record September 13th A.P. 1895.

John Bucky Recorder,