

V208 P483 #5
10 AC. Tract
Betty L. Wm. P. & Karl Herman
Line "8" to I.R.(S) 13 is a truer
representation of the PRA &
HAR TWP line than is the
E T.R. 198.

Line I.R.(S) 13 to "A" is a truer
representation of the SALE
HAR TWP line than is
E T.R. 409.


Apparent line of
occupation between
N. Line S4, T9N, R6W
and S. Line Lot 7, 3rd
1/4, T10N, R6W.

T.R. 198 was laid out in
June 1898 as per R.R. 4
p. 397-398 & 415-416.
It was specifically
stated as to be on the
line between Hardy
Prairie & Salt Creek
Twp. It was an alter-
ation to #244 which

is T.R. 198 from Honey Run Rd.
(C.R. 203) on line between
S4 & S5, T9N, R6W to Millers-
burg - Massillon Rd. (R.R. 241).
#244 had a 30' R/W as laid
out in April 1858. In process
mention was made of 60'
R/W however this was not
certified. Therefore it is

the opinion of the hereon
signed author that this
R/W shall be taken as
30'.

To date, by a search of
available records, it
is the opinion of the
hereon signed author,
it is hard to prove
whether it ever was
or was not officially
recognized as a road.

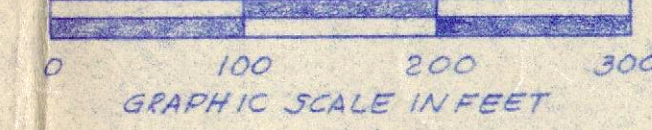

PLAT OF A SURVEY FOR
HOLMES LIMESTONE
COMPANY
Sacs. 485, T9N, R6W &
Lot 7, 3rd 1/4, T10N, R6W &
Lot 10 & 11, 3rd 1/4, T10N, R6W.
Robert L. Kasner P.S. 5193
R.E. 28820

