


T.H. 353
Old T.H. 205
40' x 100'

Lot 4

Lot 3

S.R. 557

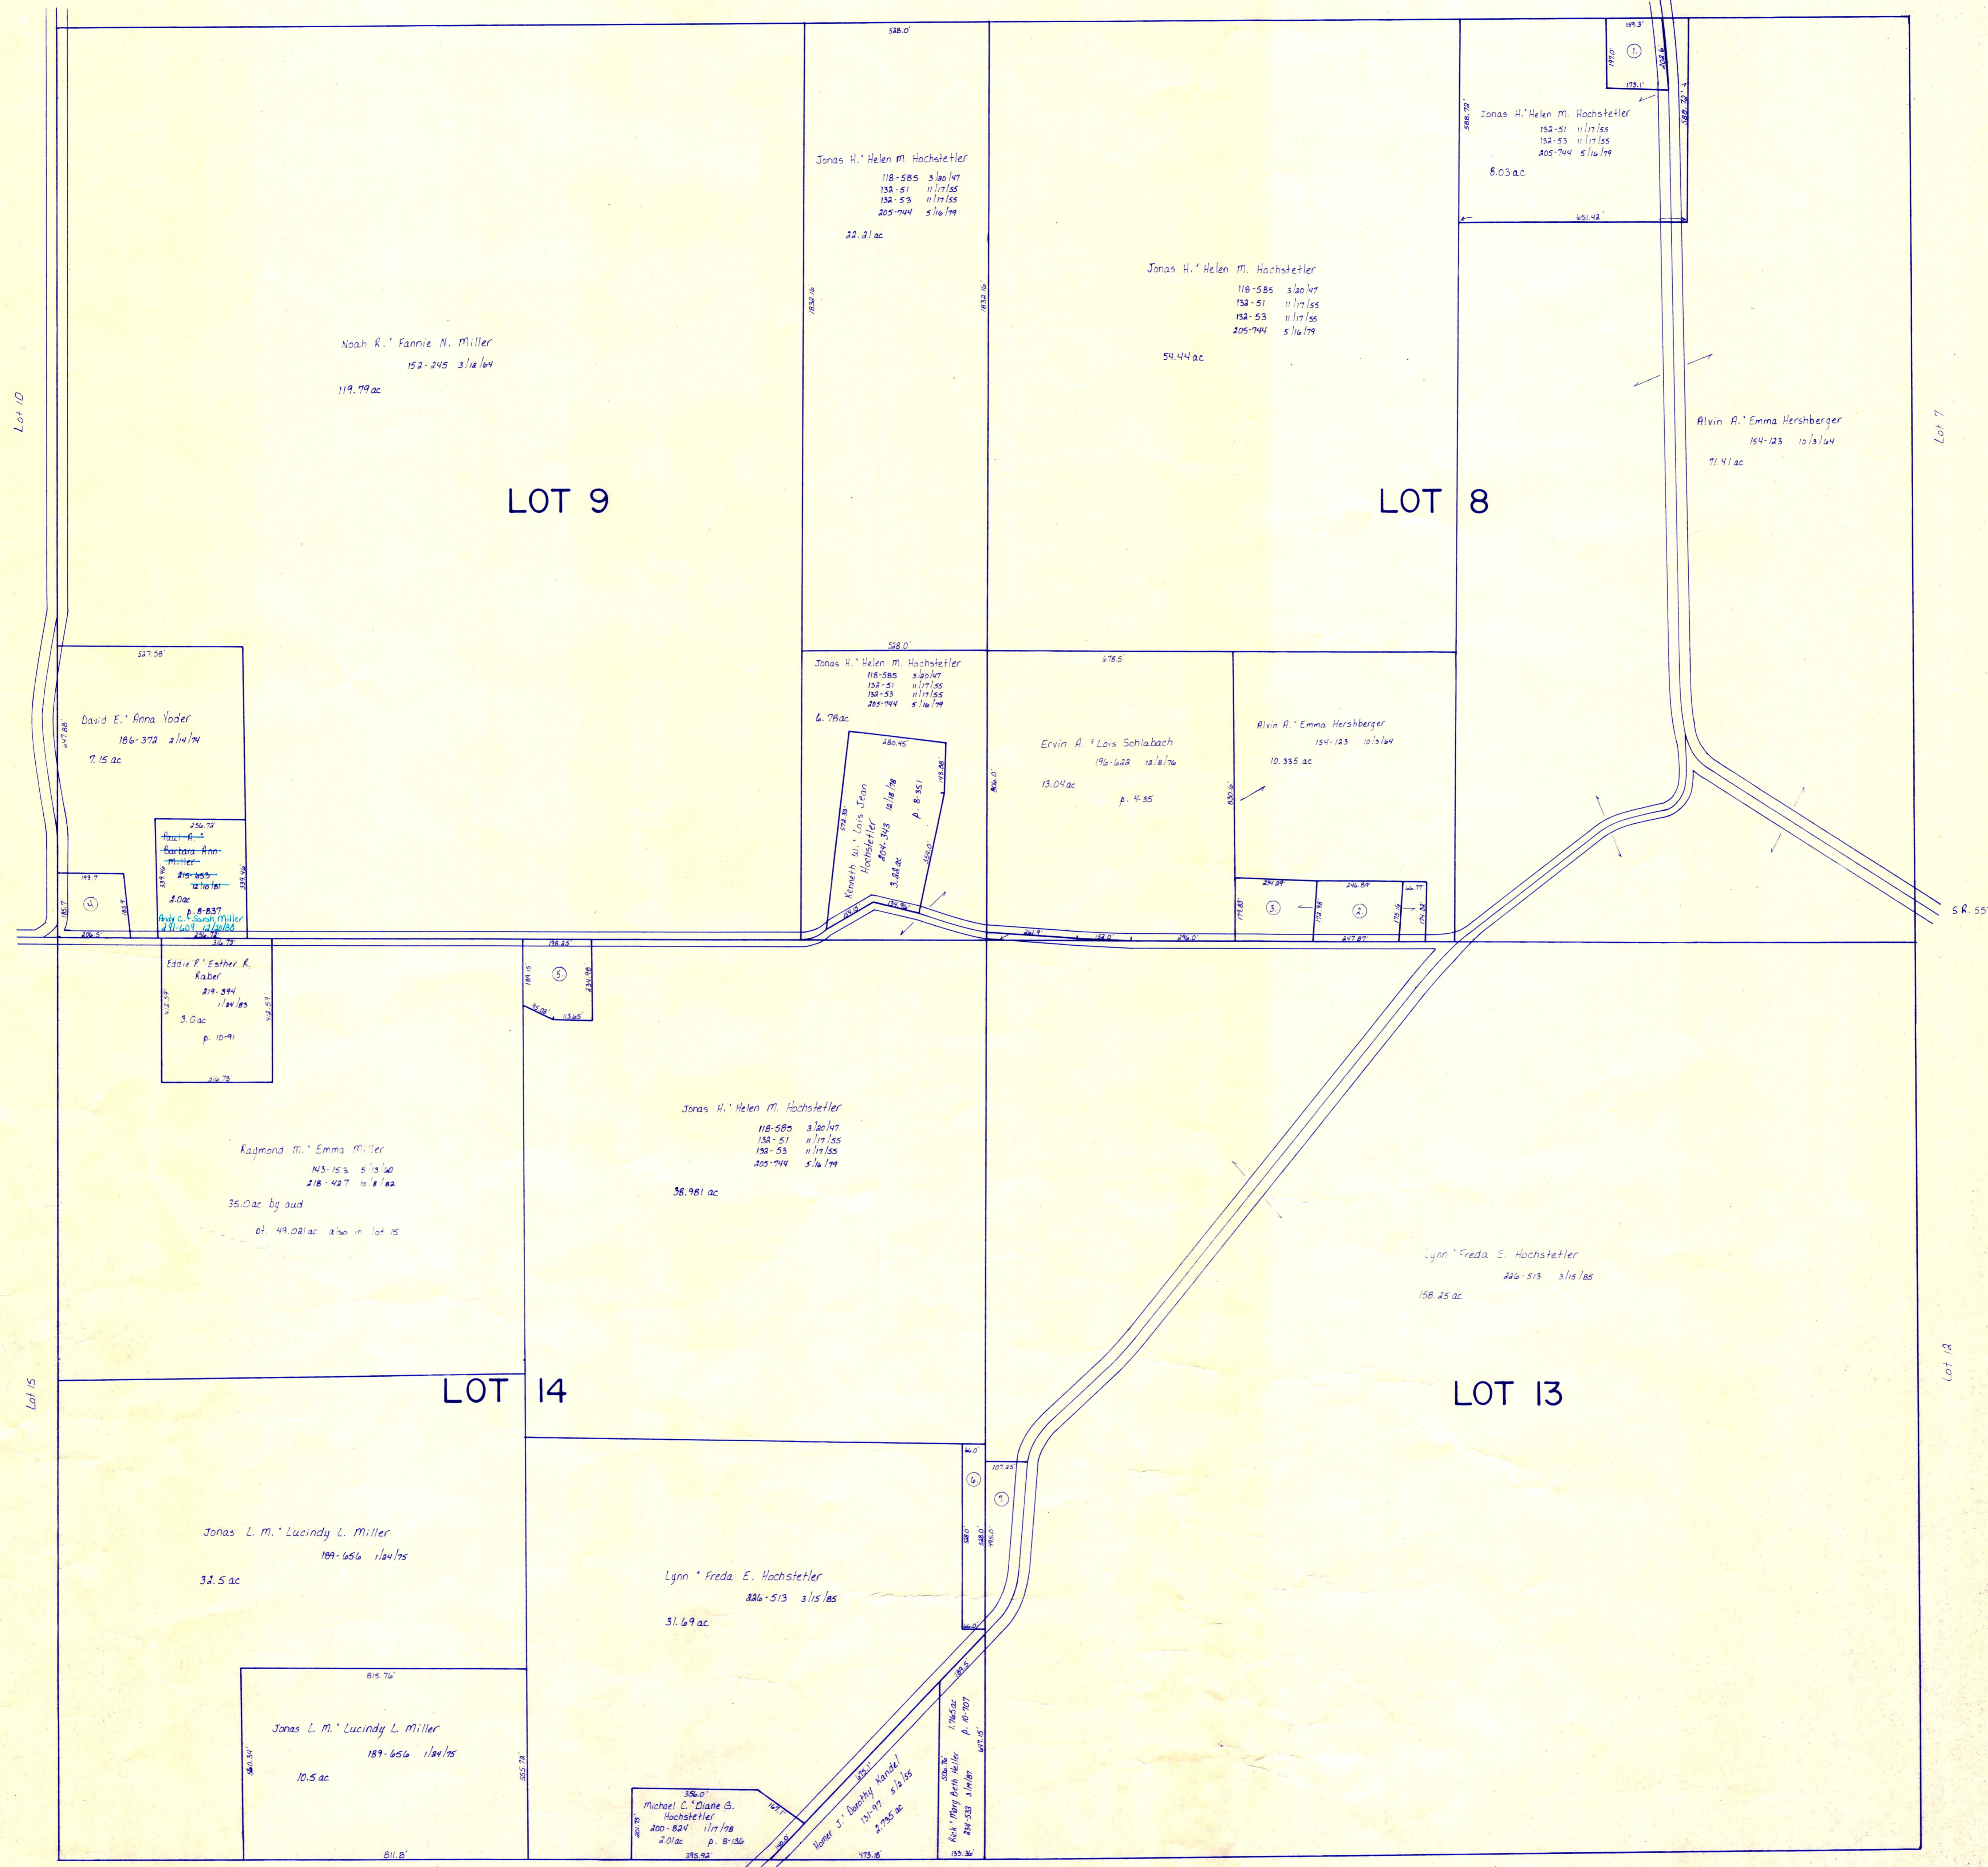


- ① Douglas W. & Martha J. Sommers 151-17 1/4 1/4 Sec. 7.2 ac p. 4-124
- ② David A. & Esta Hershberger 225-306 10/30/19 7.86 ac p. 8-666
- ③ David A. & Esta Hershberger 226-186 1/30/18 1.99 ac p. 10-370
- ④ Dan M. & Verna Miller 205-420 4/1/19 .85 ac p. 3-75 B
- ⑤ Abe A. & Mary Ellen Miller 436-147 2/1/18 1.09 ac p. 10-406
- ⑥ Homer J. & Dorothy Kandel 131-97 5/1/15 .8 ac
- ⑦ Homer J. & Dorothy Kandel 131-97 5/1/15 1.0 ac

T.H. 354
Old T.H. 422
40' x 100' E.W.

Lot 12

T-9, R-6, 4th. Qtr.
Lots 8, 9, 13, 14
BERLIN TWP.
SCALE: 1" = 200'

LET IT BE KNOWN, THIS MAP HAS BEEN PREPARED AS A REFERENCE GUIDE TO PROPERTY OWNERSHIP. WE BELIEVE THIS INFORMATION TO BE CORRECT AND CURRENT. HOWEVER, IT IS NOT INTENDED FOR ANY LEGAL USE, WHETHER IT BE IN SALES, TRANSFERS, TRADES, LEASES OF ANY TYPE, ETC., AND DO NOT ACCEPT RESPONSIBILITY FOR ERRORS OF ANY NATURE OR OMISSIONS CONTAINED HEREIN.

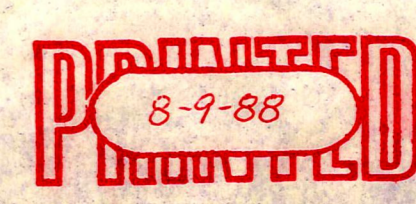

13-7