


T.H. 362  
T.H. 120 (old)  
60' x 110'

Sec. 6

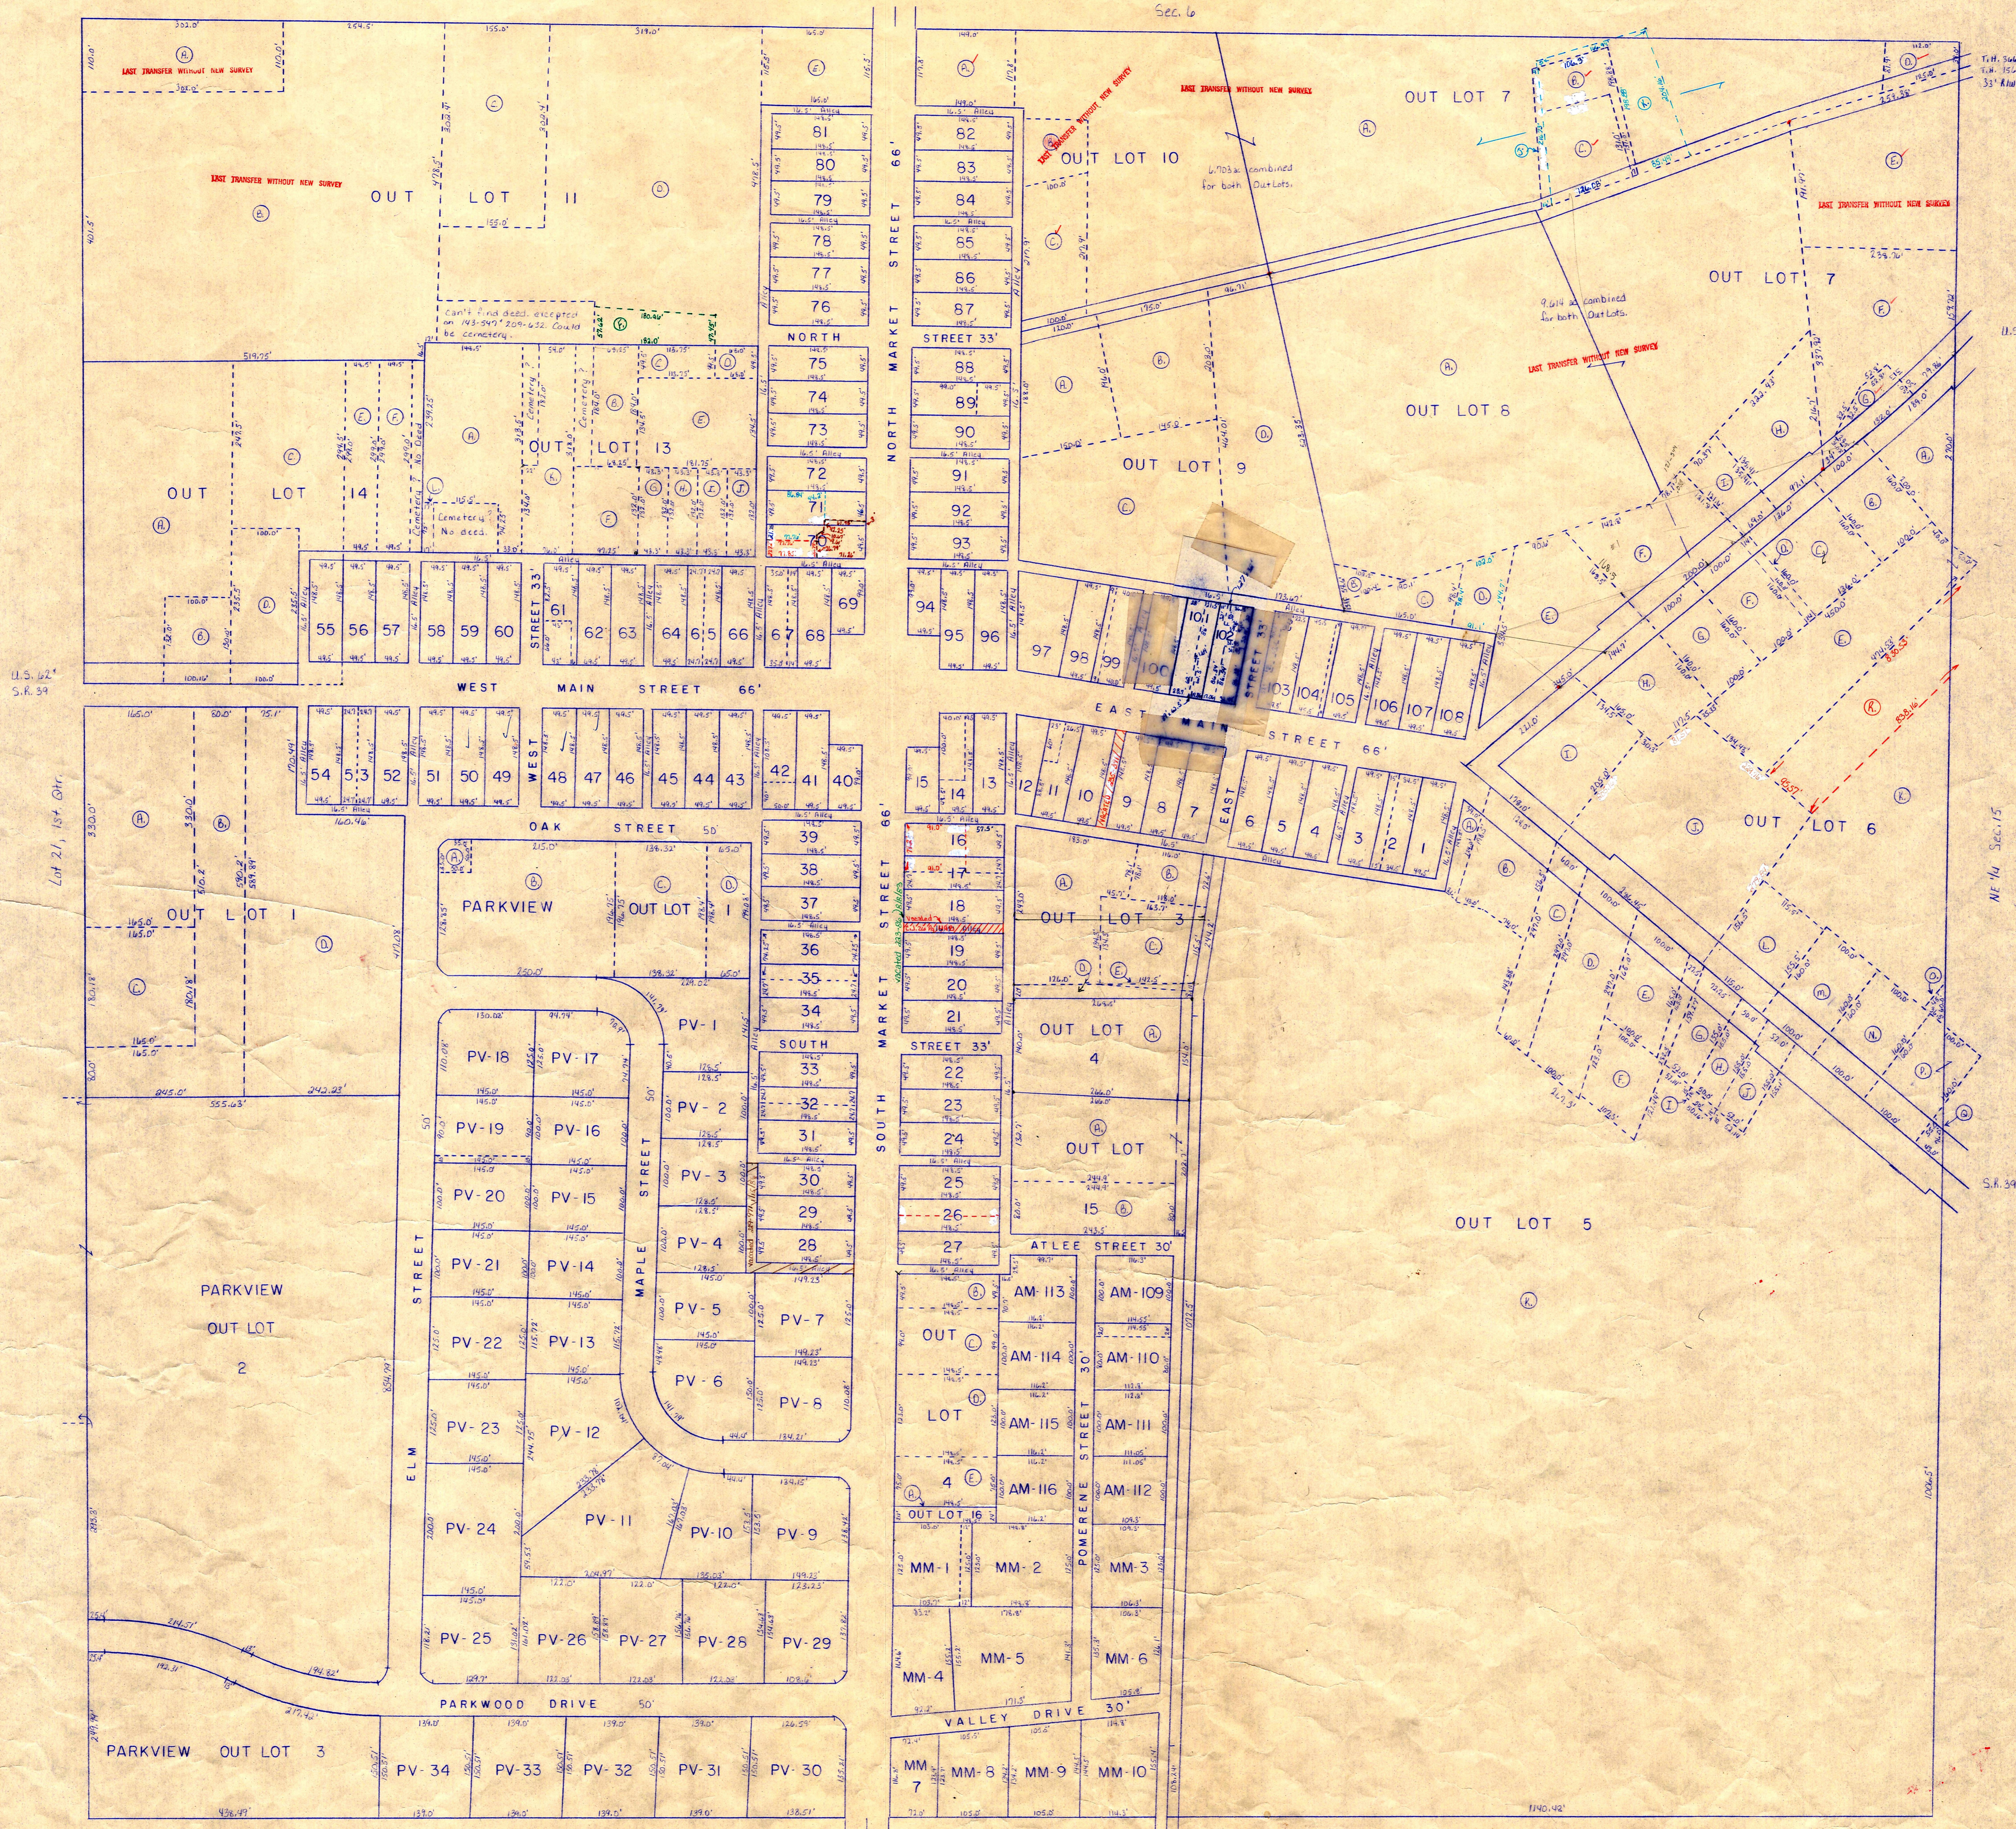

U.S. 62  

U.S. 62

NE 1/4 Sec. 15


C.H. 120  
60' x 110'

Lot 40, 3rd. Div.

T.H. 258  
T.H. 120 (old)  
53' x 110'

T-9, R-5, Sec. 15

BERLIN TWP.

SCALE: 1" = 100'

BERLIN VILLAGE

B-18A