
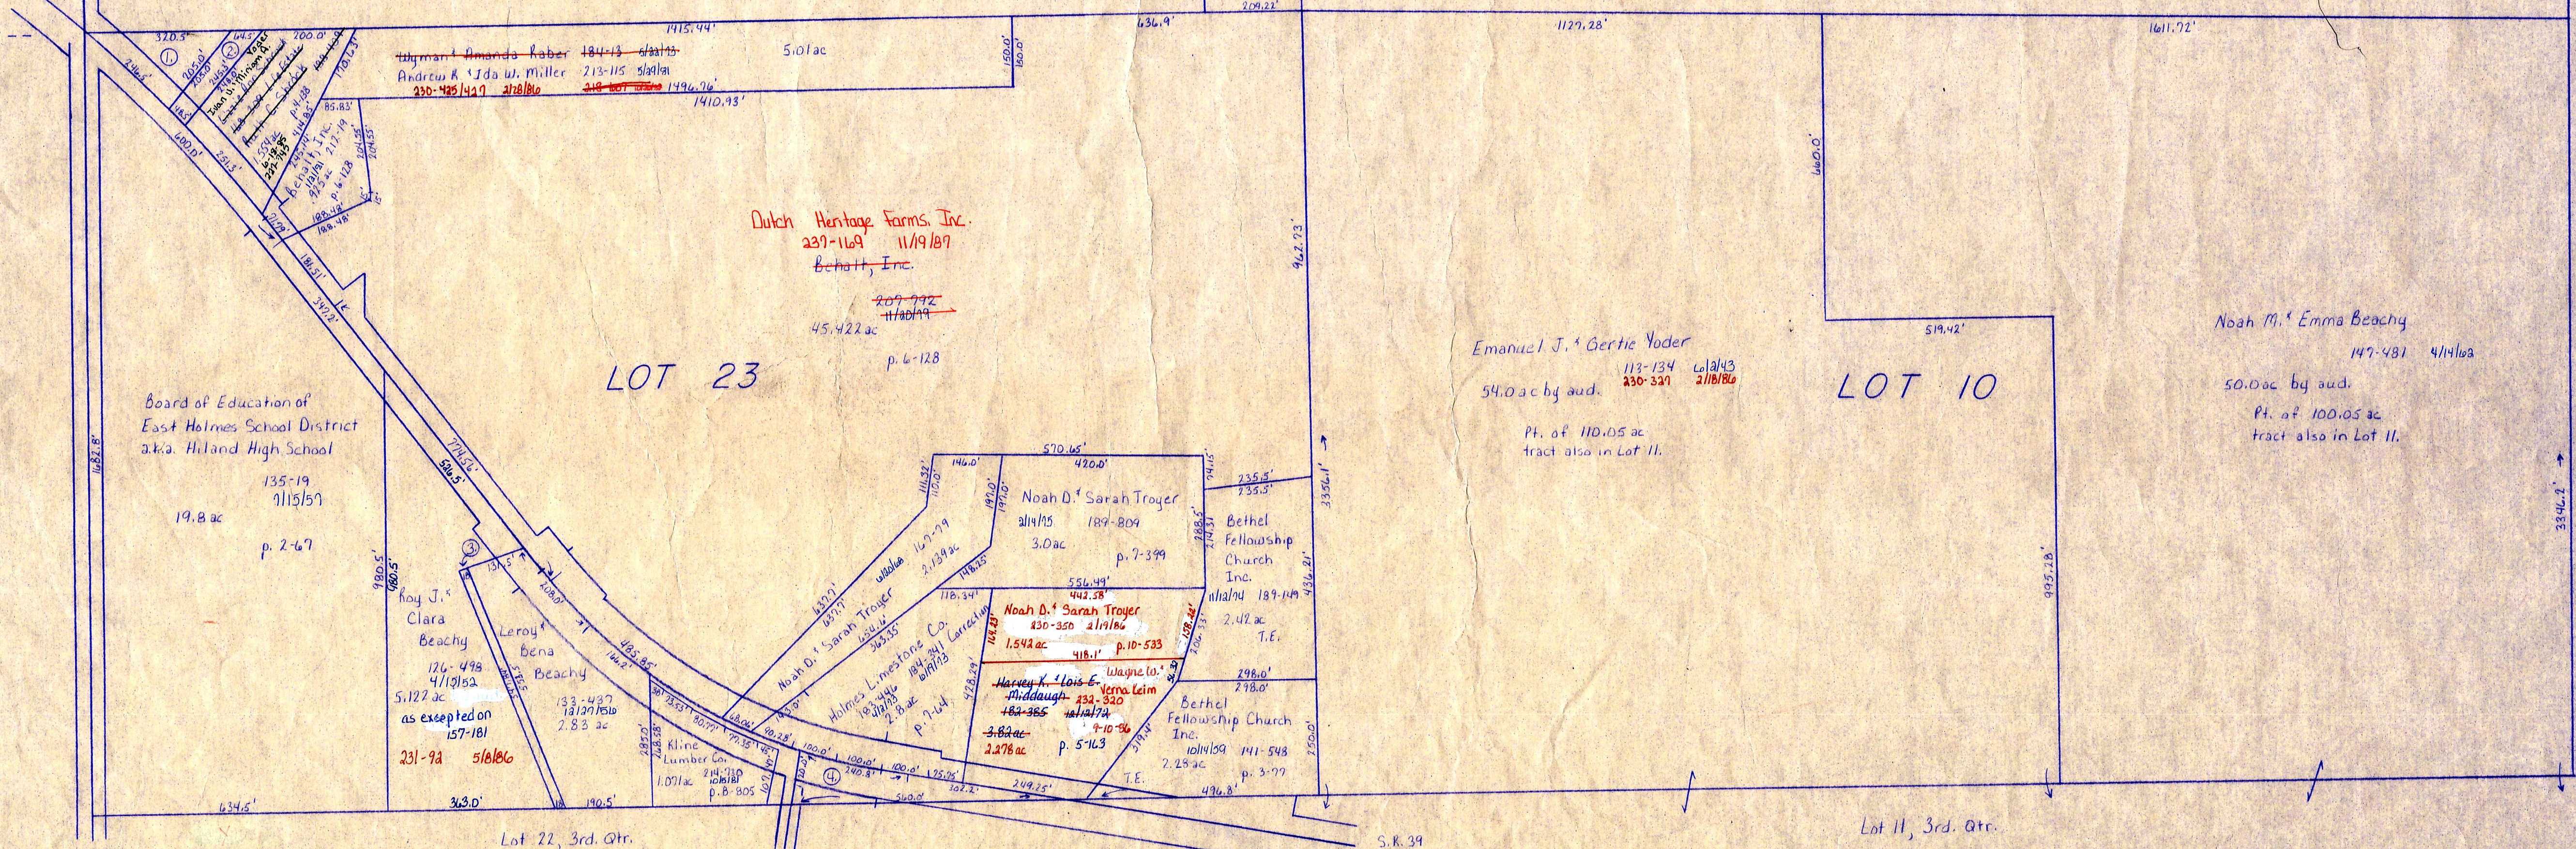


C.H. 77
60' R/W

Sec. 14

27.5
14.74
12.76
14.00
5.00

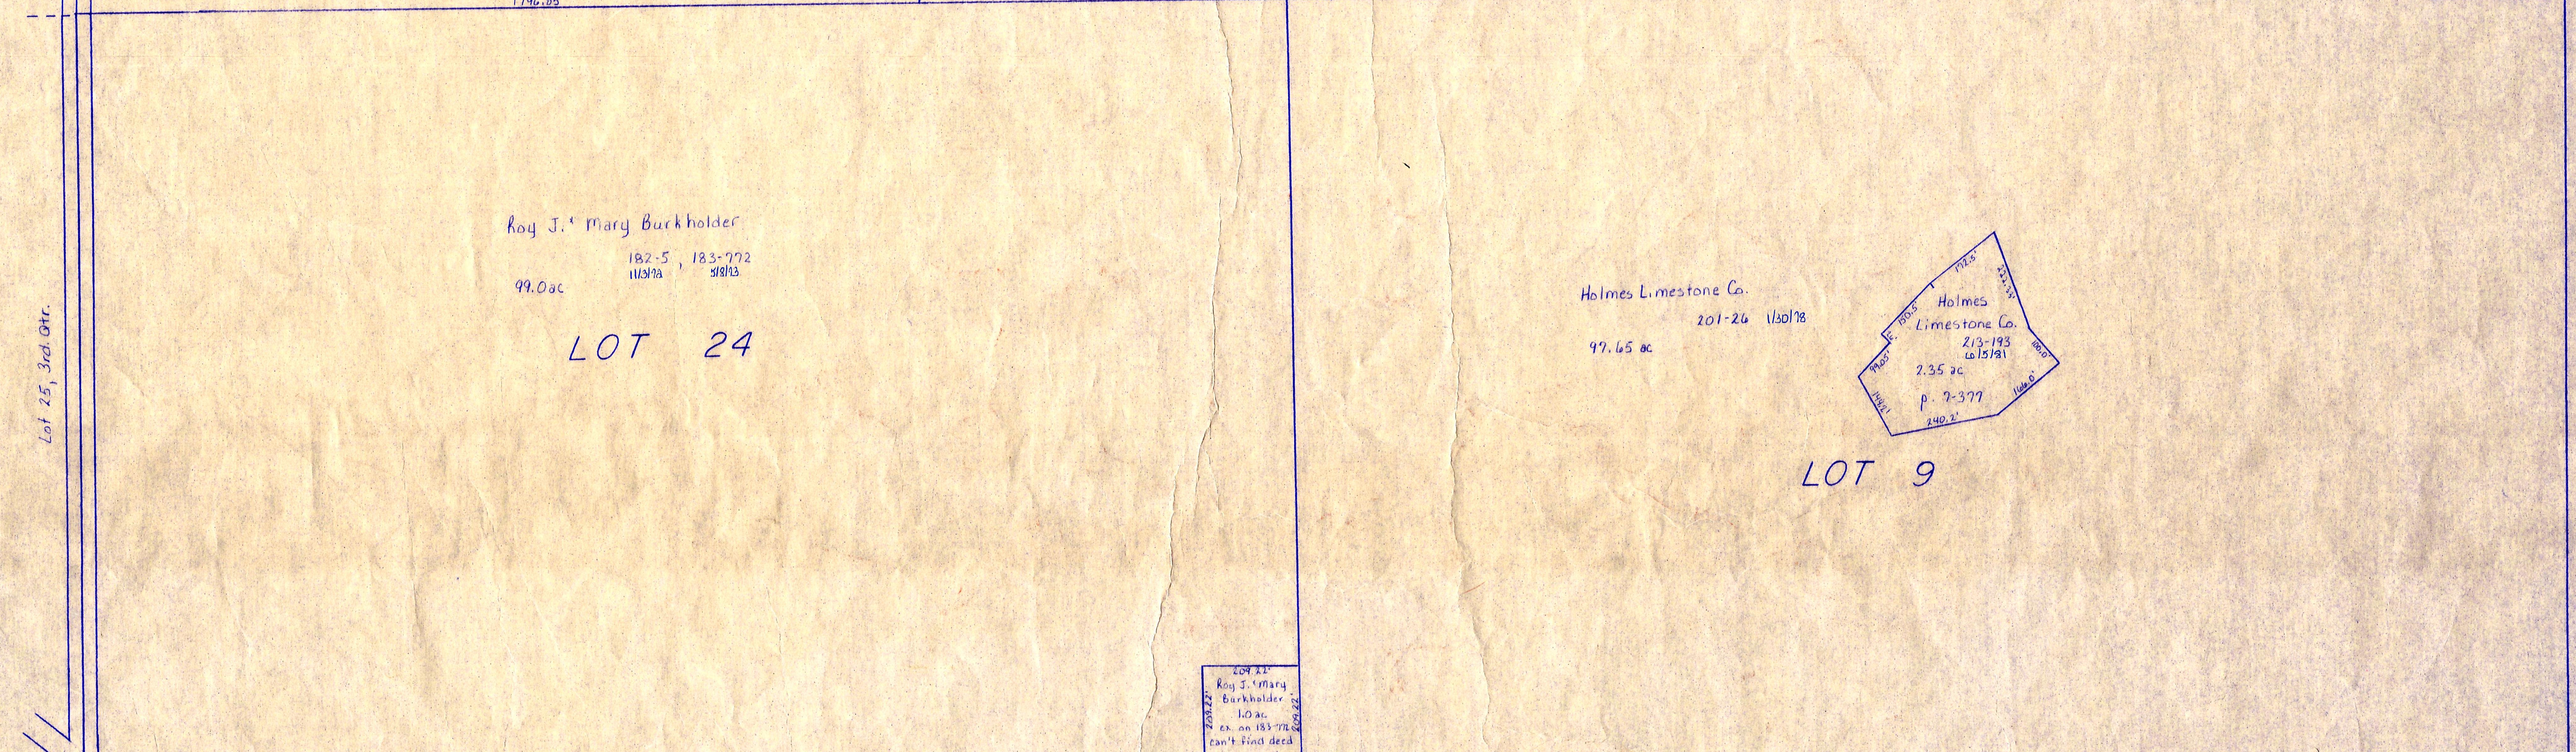

- T-9, R-5, 3rd. Qtr., Lot 23
- Edward Davis E. Stutzman 161-185 158 ac p. 4-124
 - Edward Davis E. Stutzman 164-169 25 ac p. 4-150
 - Leroy Bena Beachy 170-83 228 ac p. 4-200
 - Alvin D. Susan Kline 170-31 179 ac p. 4-200

T-9, R-5, 3rd. Qtr. Lots 9, 10, 23, 24, Sec. 14
BERLIN TWP.