


- ① Abe D. & Verna Weaver 212-226 2/24/18
- ② Andy A. & Amanda Weaver 146-229 1/14/18, 185-887 1/25/22
- ③ Trustees of the North Bunkerhill Private School 139-429 1/17/20 38ac plot in file
- ④ Mark Allen & Mary Ellen Miller 225-608 12/1/18 197ac p. 10-350
- ⑤ Mark Allen & Mary Ellen Miller 224-983 9/25/18 13ac plot in file
- ⑥ Mathon D. & Ada Miller 193-25 1/24/18 88ac p. 7-560
- ⑦ Jacob A. & Esther D. Kline 253-673 12/16/11 113ac p. 12-809
- ⑧ Jacob A. & Esther D. Kline 253-673 12/16/11 103ac p. 12-809
- ⑨ Jacob A. & Esther D. Kline & Aden H. & Effie Troyer 253-676 1/28/12 p. 12-809

for numbered parcels, see folder

T-9, R-5,  
Sec. 5  
BERLIN TWP.

SCALE 1" = 200'

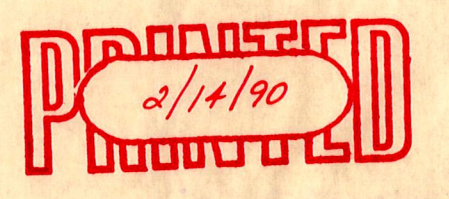

LET IT BE KNOWN, THIS MAP HAS BEEN PREPARED AS A REFERENCE GUIDE TO PROPERTY OWNERSHIP. WE BELIEVE THIS INFORMATION TO BE CORRECT AND CURRENT, HOWEVER, IT IS NOT INTENDED FOR ANY LEGAL USE, WHETHER IT BE IN SALES, TRANSFERS, TRADES, LEASES OF ANY TYPE, ETC., AND DO NOT ACCEPT RESPONSIBILITY FOR ERRORS OF ANY NATURE OR OMISSIONS CONTAINED HEREIN.

13-20