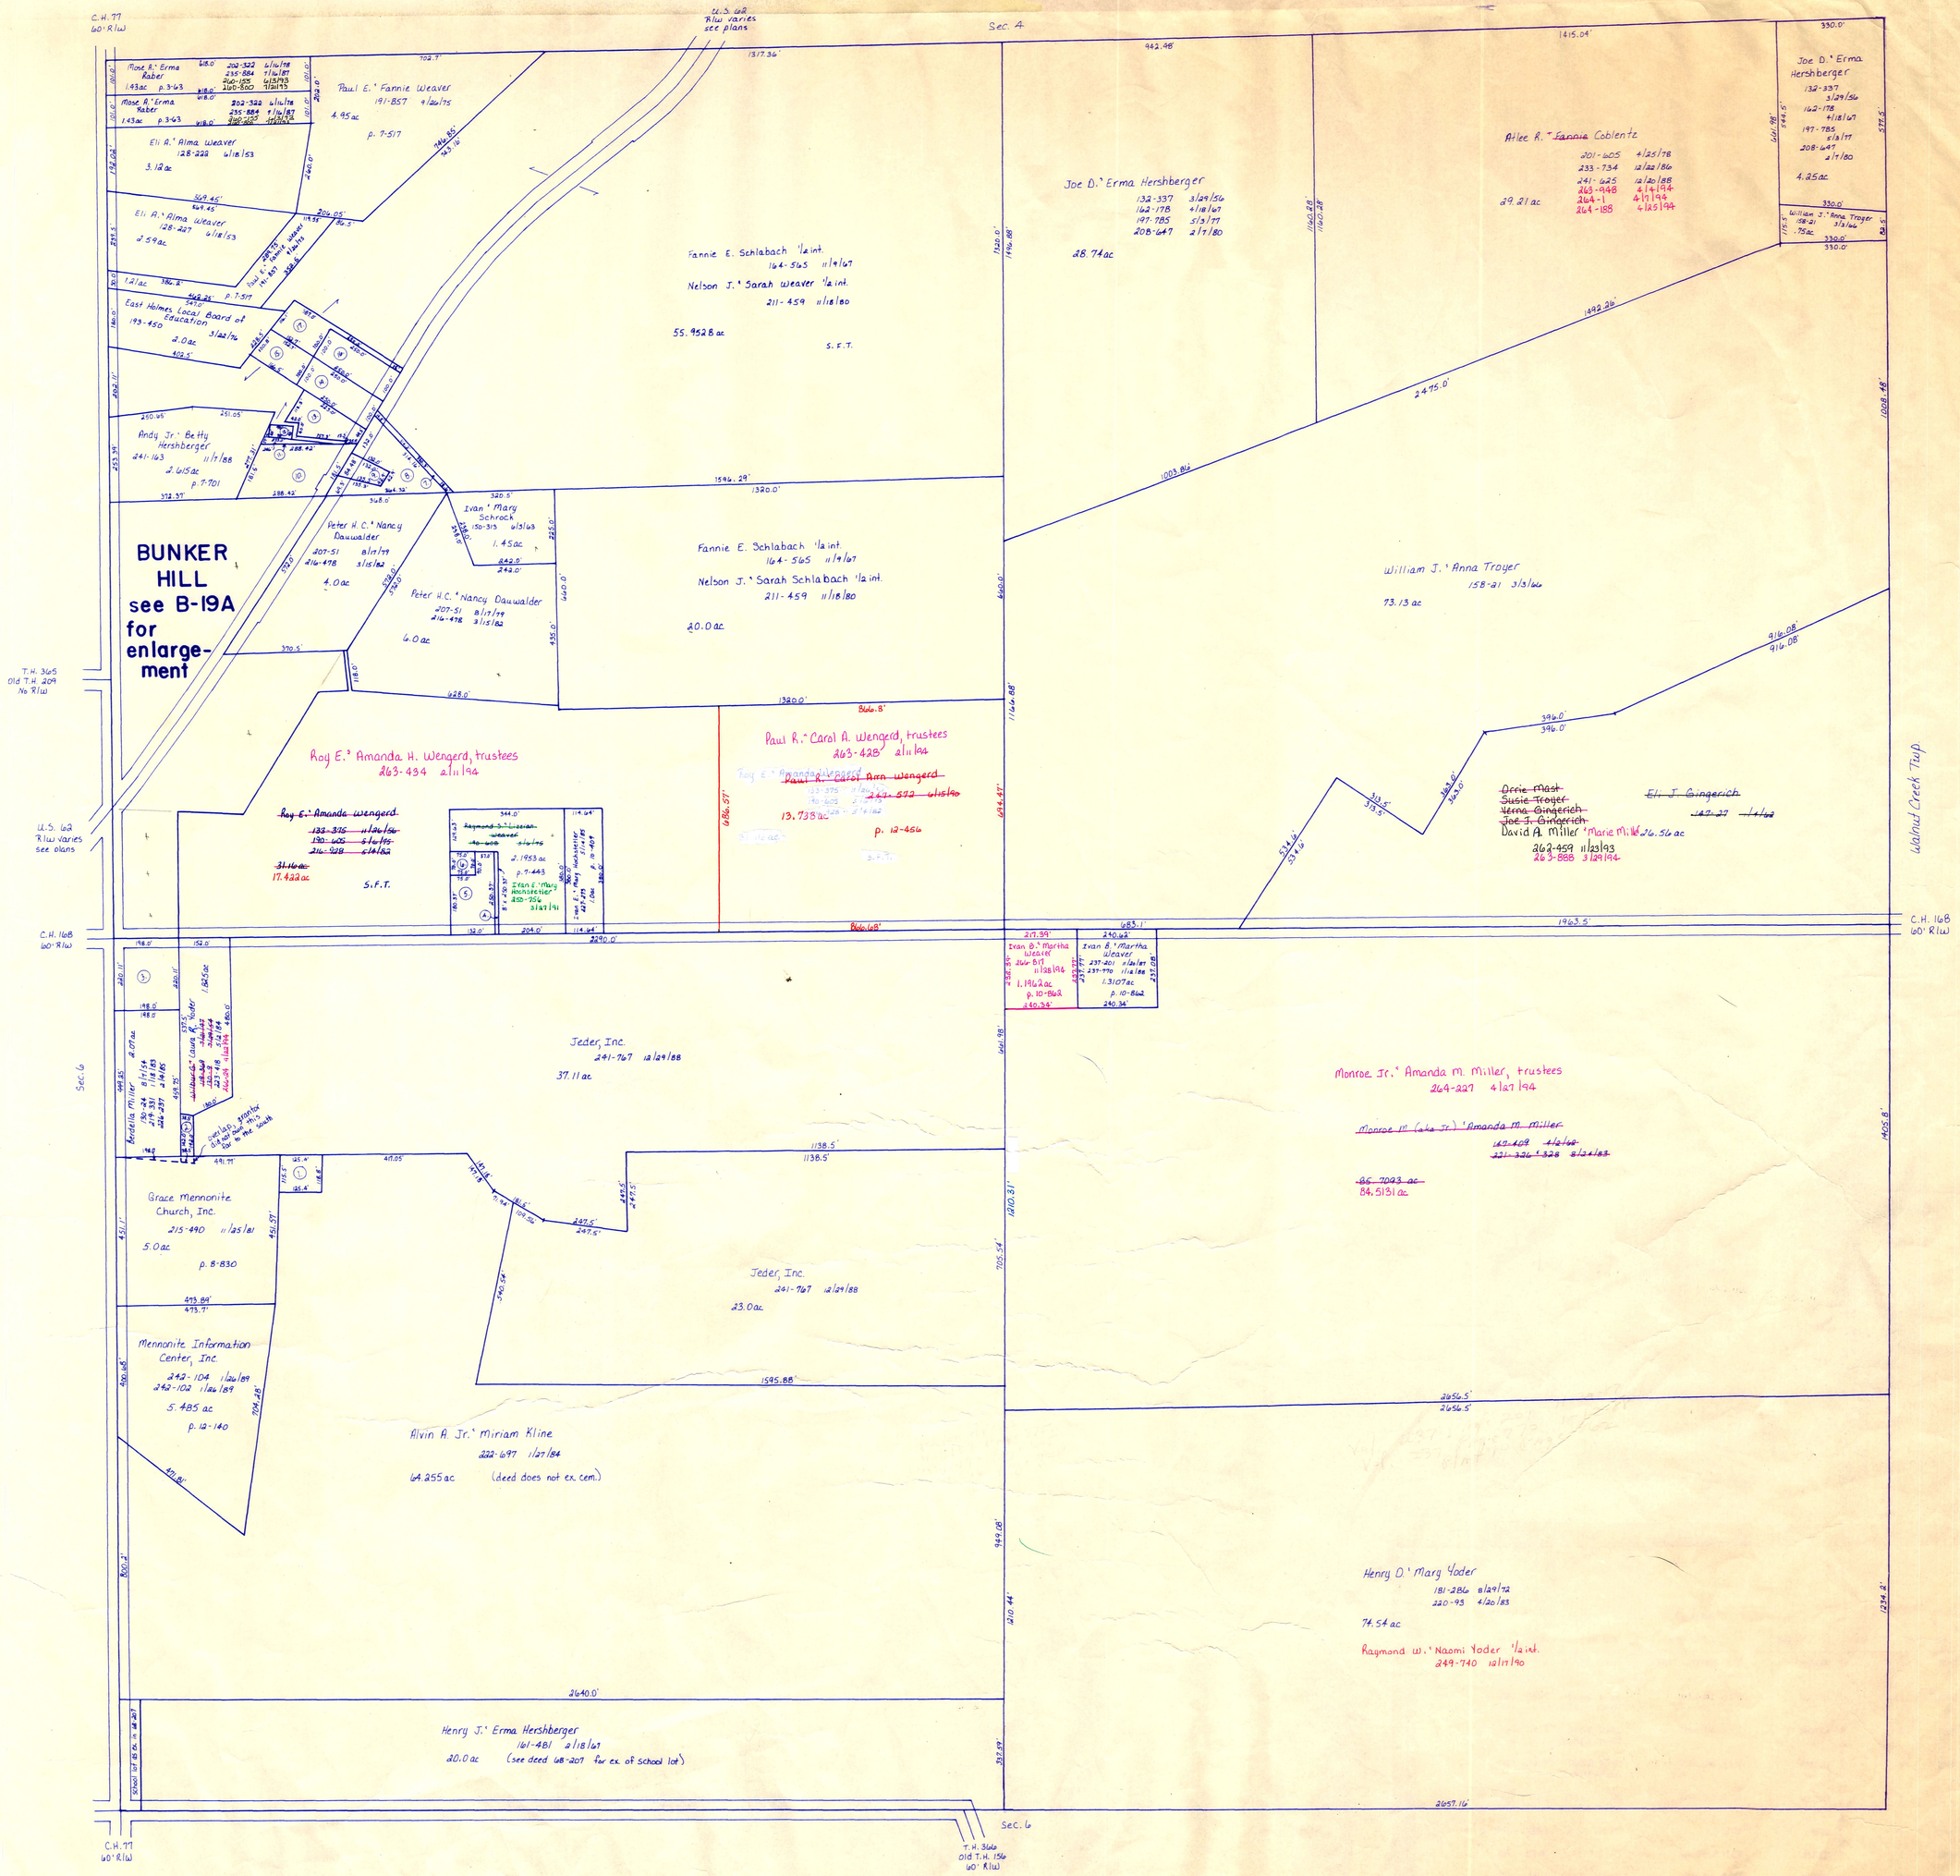

~~① The Brethern Church of Bunkerhill for Cemetery Use 28-179 4/30/68 .33ac~~
~~② Berdella Miller 131-368 8/4/55, 149-331 1/8/85, 226-237 8/4/85 .125ac~~
~~③ Berdella Miller 219-331 1/8/85, 226-237 8/4/85 1.0ac~~
~~④ John D.' Betty Miller 150-557 3/12/81 Bunker Hill Enterprises 242-968 3/24/90~~
~~Timber Eze Inc 210-506 8/14/86 .046ac p. 8-640~~
~~⑤ John D.' Betty Miller 150-557 3/12/81 Bunker Hill Enterprises 242-968 3/24/90~~
~~Timber Eze Inc 204-776 4/28/86 1.0387ac p. 8-617~~
~~⑥ John D.' Betty Miller 150-557 3/12/81 Bunker Hill Enterprises 242-968 3/24/90~~
~~Timber Eze, Inc 214-454 3/16/82 .172ac p. 8-196~~
~~⑦ Ivan' Mary Schrock 150-313 6/3/63 1ac~~
~~⑧ Donald D Oswald 215-823 1/5/82, 240-430 & 434 4/21/88 .81ac~~
~~⑨ Donald D Oswald 215-823 1/5/82, 240-430 & 434 4/21/88 .19ac~~
~~⑩ Jonas A.' Betty Weaver 170-208 4/20/49 1.6ac~~
~~⑪ Jonas A.' Betty Weaver 170-208 4/20/49 .0732ac~~
~~⑫ Jonas A.' Betty Weaver 170-208 4/20/49 .06ac p. 3-76 &~~
~~Ex 5496 Rev 498 12/48~~
~~⑬ Noah J.' Sylva Beachy 149-488 10/10/85 .5ac p. 3-76 &~~

~~⑭ Marguerite A Kauffman 226-258 2/7/85 .57ac~~
~~⑮ Marguerite A Kauffman 226-258 2/7/85 .36ac~~
~~⑯ Delmer' Nellie Hecker 116-258 12/29/45, 220-742 6/20/83 .57ac~~
~~⑰ Delmer' Nellie Hecker 128-396 5/17/49, 220-742 6/20/83 .67ac~~

for numbered parcels, see folder

T-9, R-5, Sec. 7 BERLIN TWP.

SCALE: 1" = 200'

LET IT BE KNOWN, THIS MAP HAS BEEN PREPARED AS A REFERENCE GUIDE TO PROPERTY OWNERSHIP. WE BELIEVE THIS INFORMATION TO BE CORRECT AND CURRENT, HOWEVER, IT IS NOT INTENDED FOR ANY LEGAL USE, WHETHER IT BE IN SALES, TRANSFERS, TRADES, LEASES OF ANY TYPE, ETC., AND DO NOT ACCEPT RESPONSIBILITY FOR ERRORS OF ANY NATURE OR OMISSIONS CONTAINED HEREIN.