

C.H. 201  
60' E.L.W.

Salt Creek Twp.

T.H. 362  
Old T.H. 120  
60' E.L.W.


Lot 3

LOT 2

LOT 1

Paul J. Anna Miller Subdivision  
PLAT 17-195 PLATTED 7/28/199

1. Paul J. Anna Miller 249-678 12/1/80  
Roy M. Mary Wengert OK 26-785 8/1/99
2. Paul J. Anna Miller 249-678 12/1/80  
Mose A. Keim OK 36-787 8/1/99

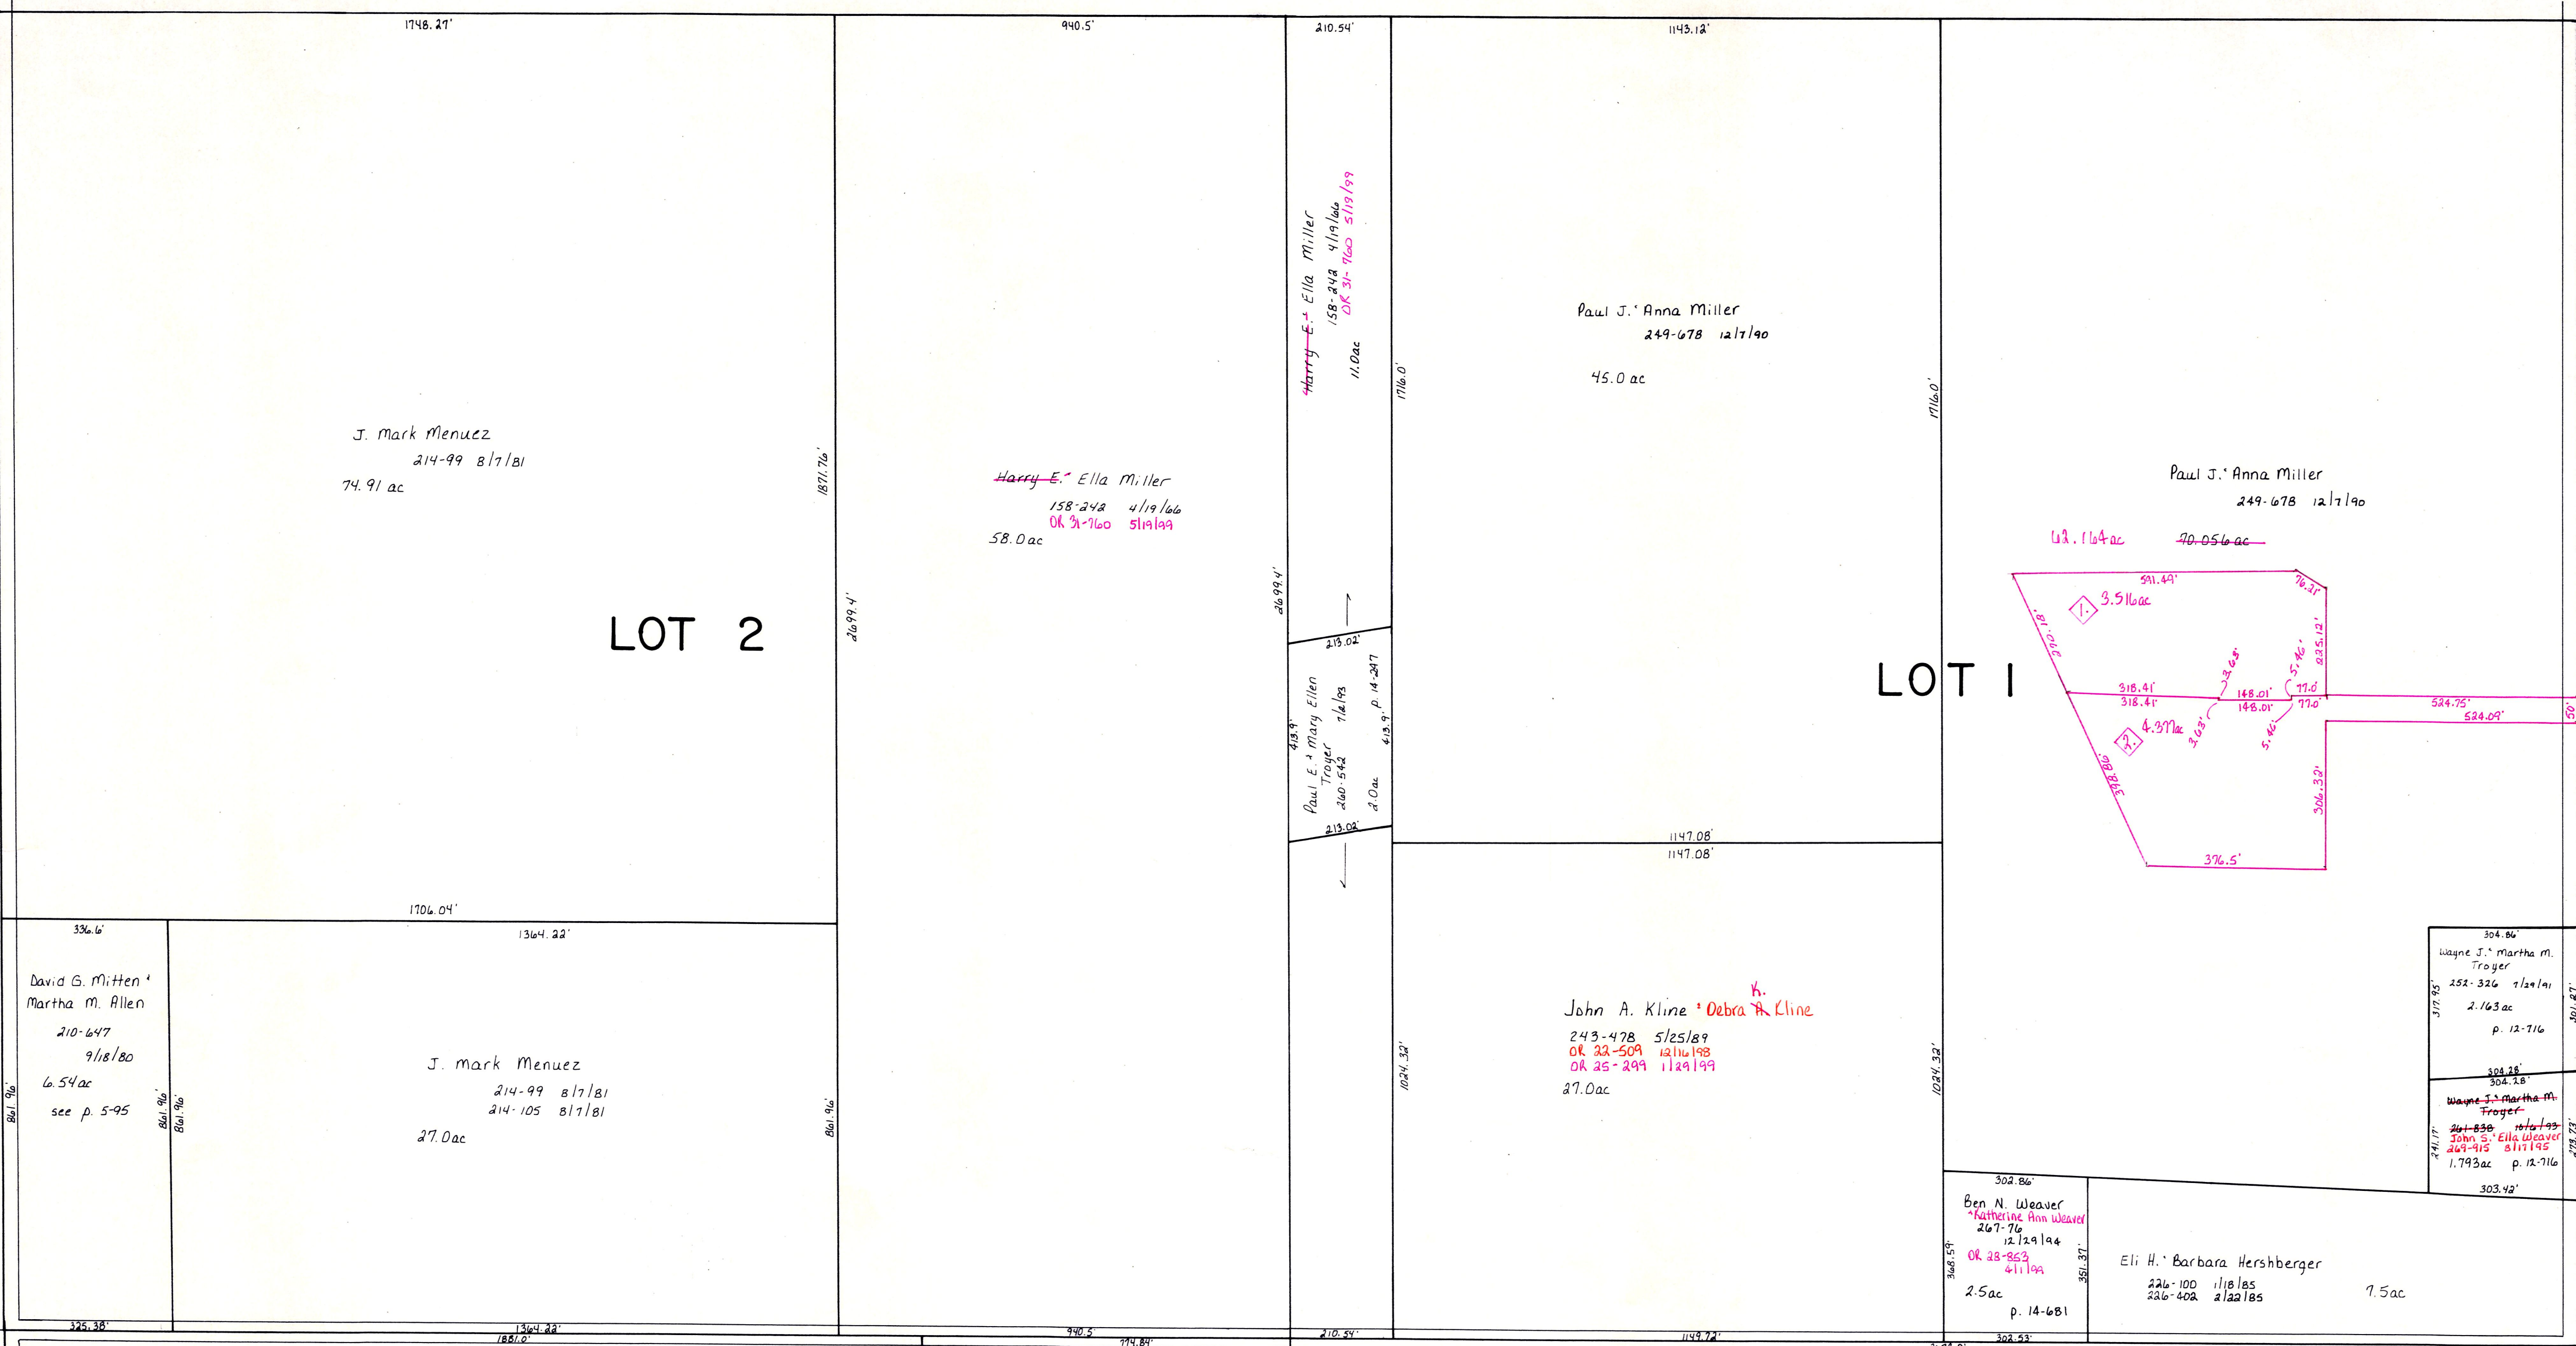


C.H. 207  
Old C.H. 206  
40' E.L.W.

C.H. 207  
Old C.H. 206  
40' E.L.W.

Lot 5

LOT 7

LOT 6

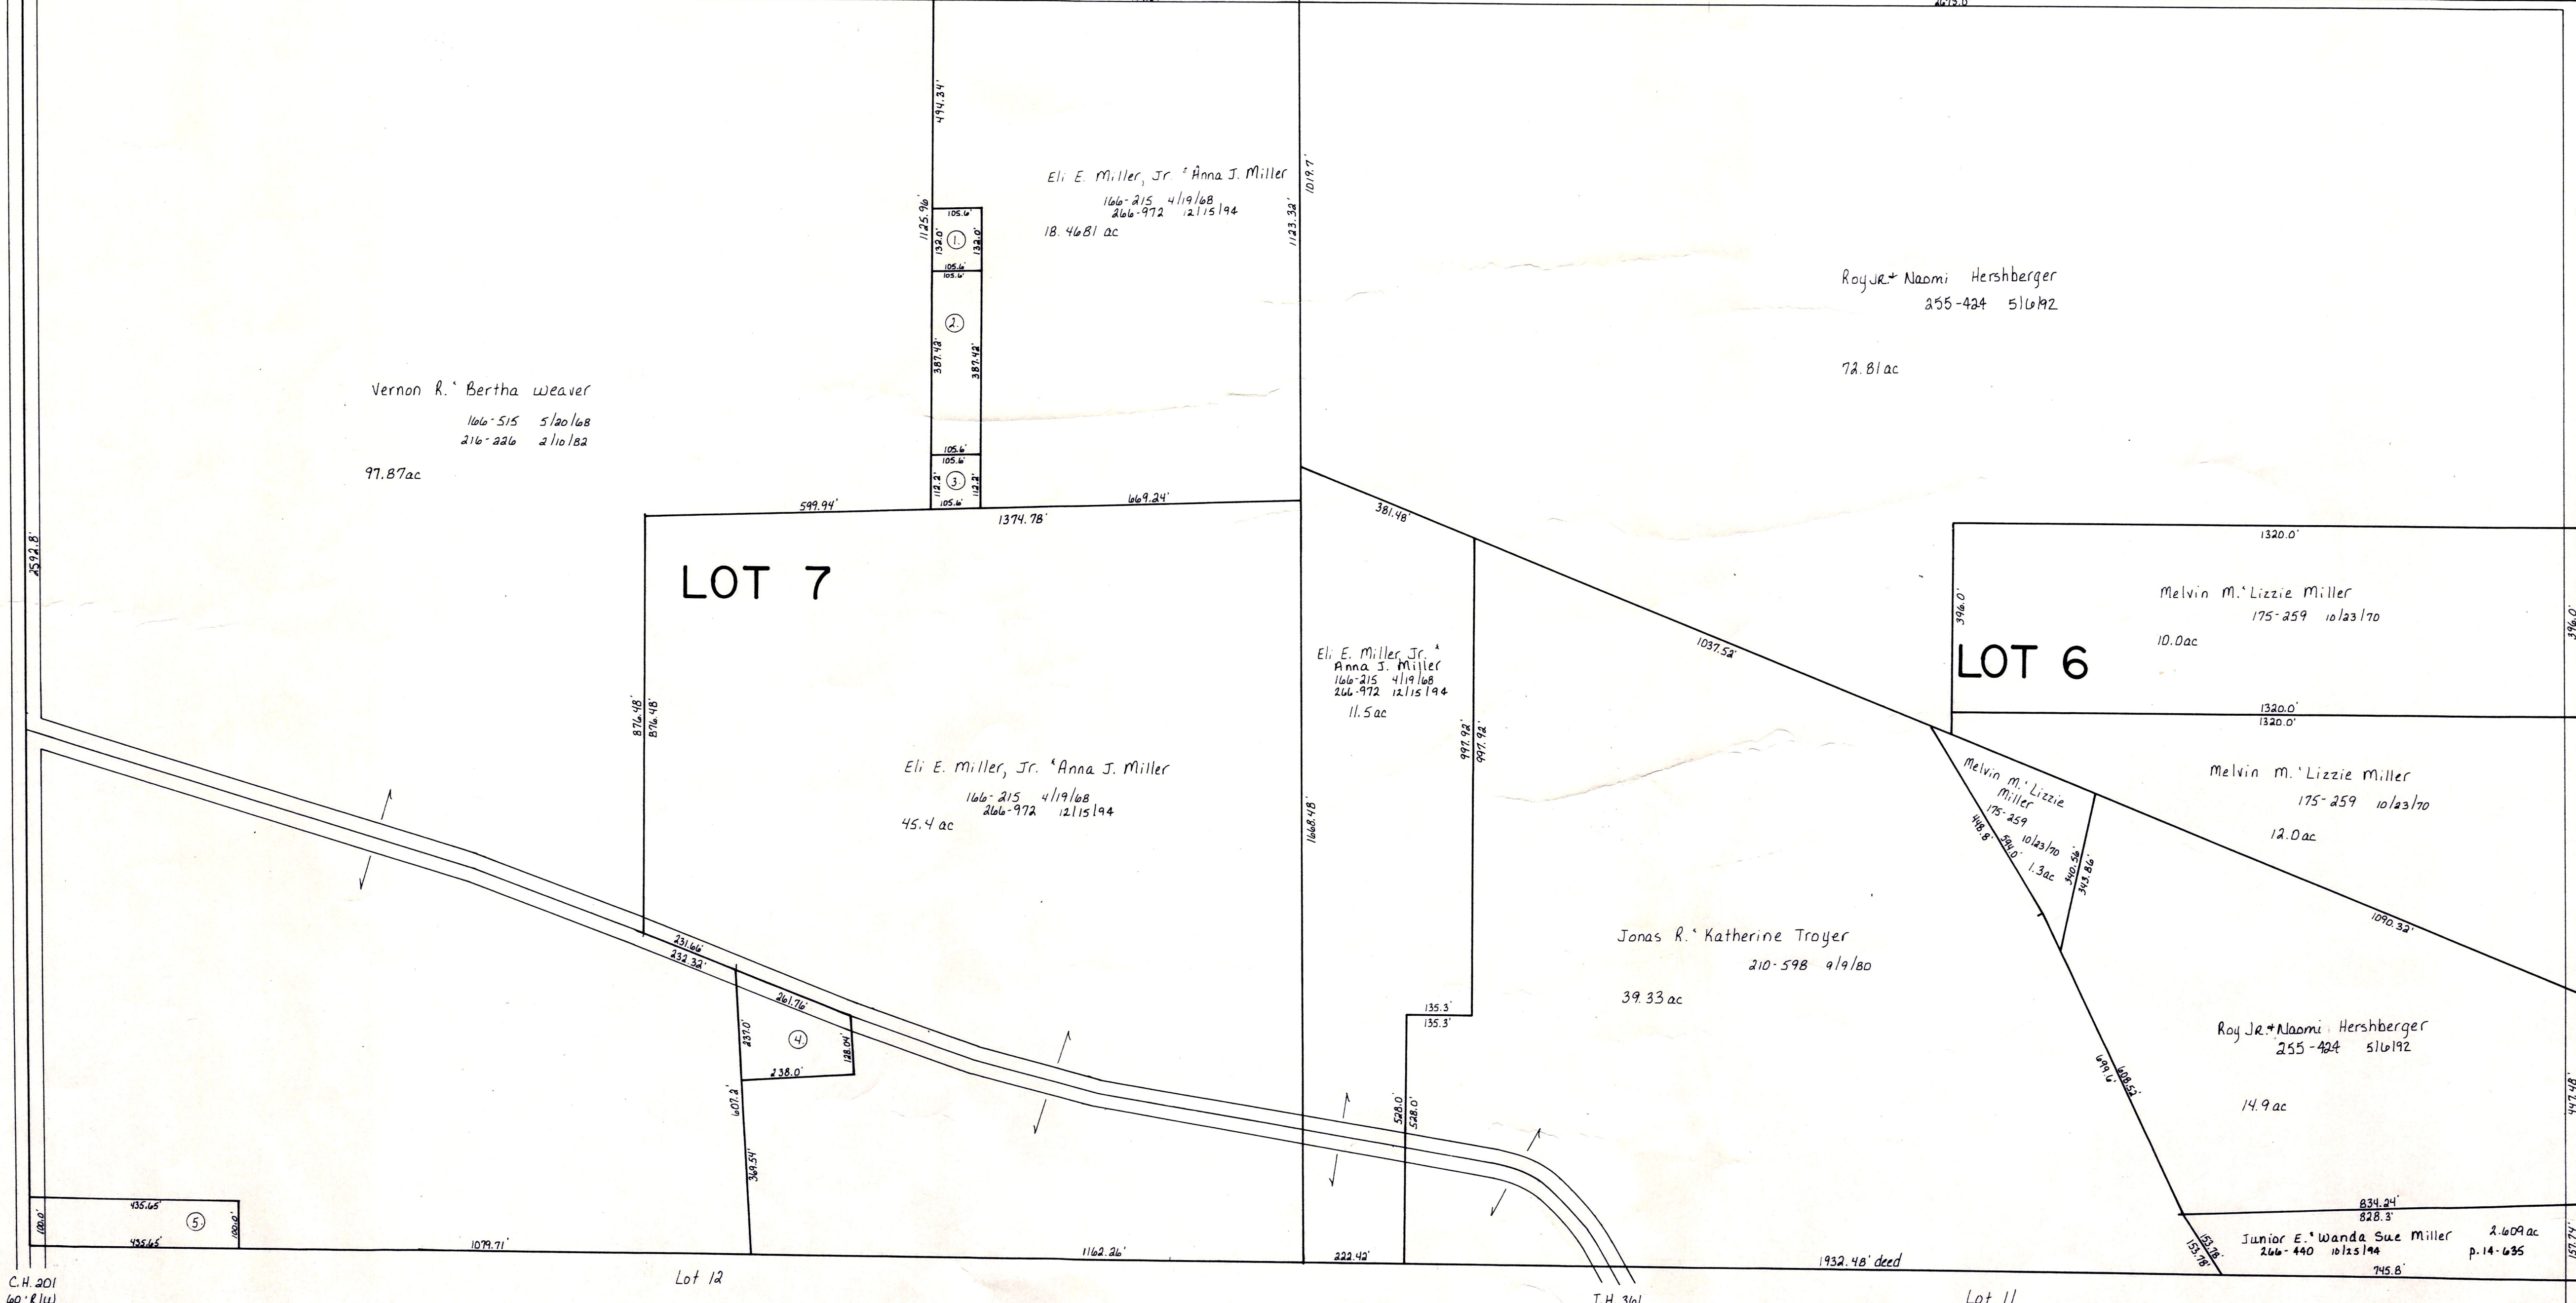

C.H. 201  
60' E.L.W.

T.H. 361  
Old T.H. 202  
60' E.L.W.

T.H. 362  
Old T.H. 120  
60' E.L.W.

T-9, R-6, 1st. Qtr.  
Lots 1, 2, 6, 7  
BERLIN TWP.  
SCALE: 1" = 200'

LET IT BE KNOWN, THIS MAP HAS BEEN PREPARED AS A REFERENCE GUIDE TO PROPERTY OWNERSHIP. WE BELIEVE THIS INFORMATION TO BE CORRECT AND CURRENT, HOWEVER, IT IS NOT INTENDED FOR ANY LEGAL USE, WHETHER IT BE IN SALES, TRANSFERS, TRADES, LEASES OF ANY TYPE, ETC., AND DO NOT ACCEPT RESPONSIBILITY FOR ERRORS OF ANY NATURE OR OMISSIONS CONTAINED HEREIN.

13-15