


C.H. 77  
60' R/W

Salt Creek Twp.


T.H. 652  
Old T.H. 210  
30' R/W

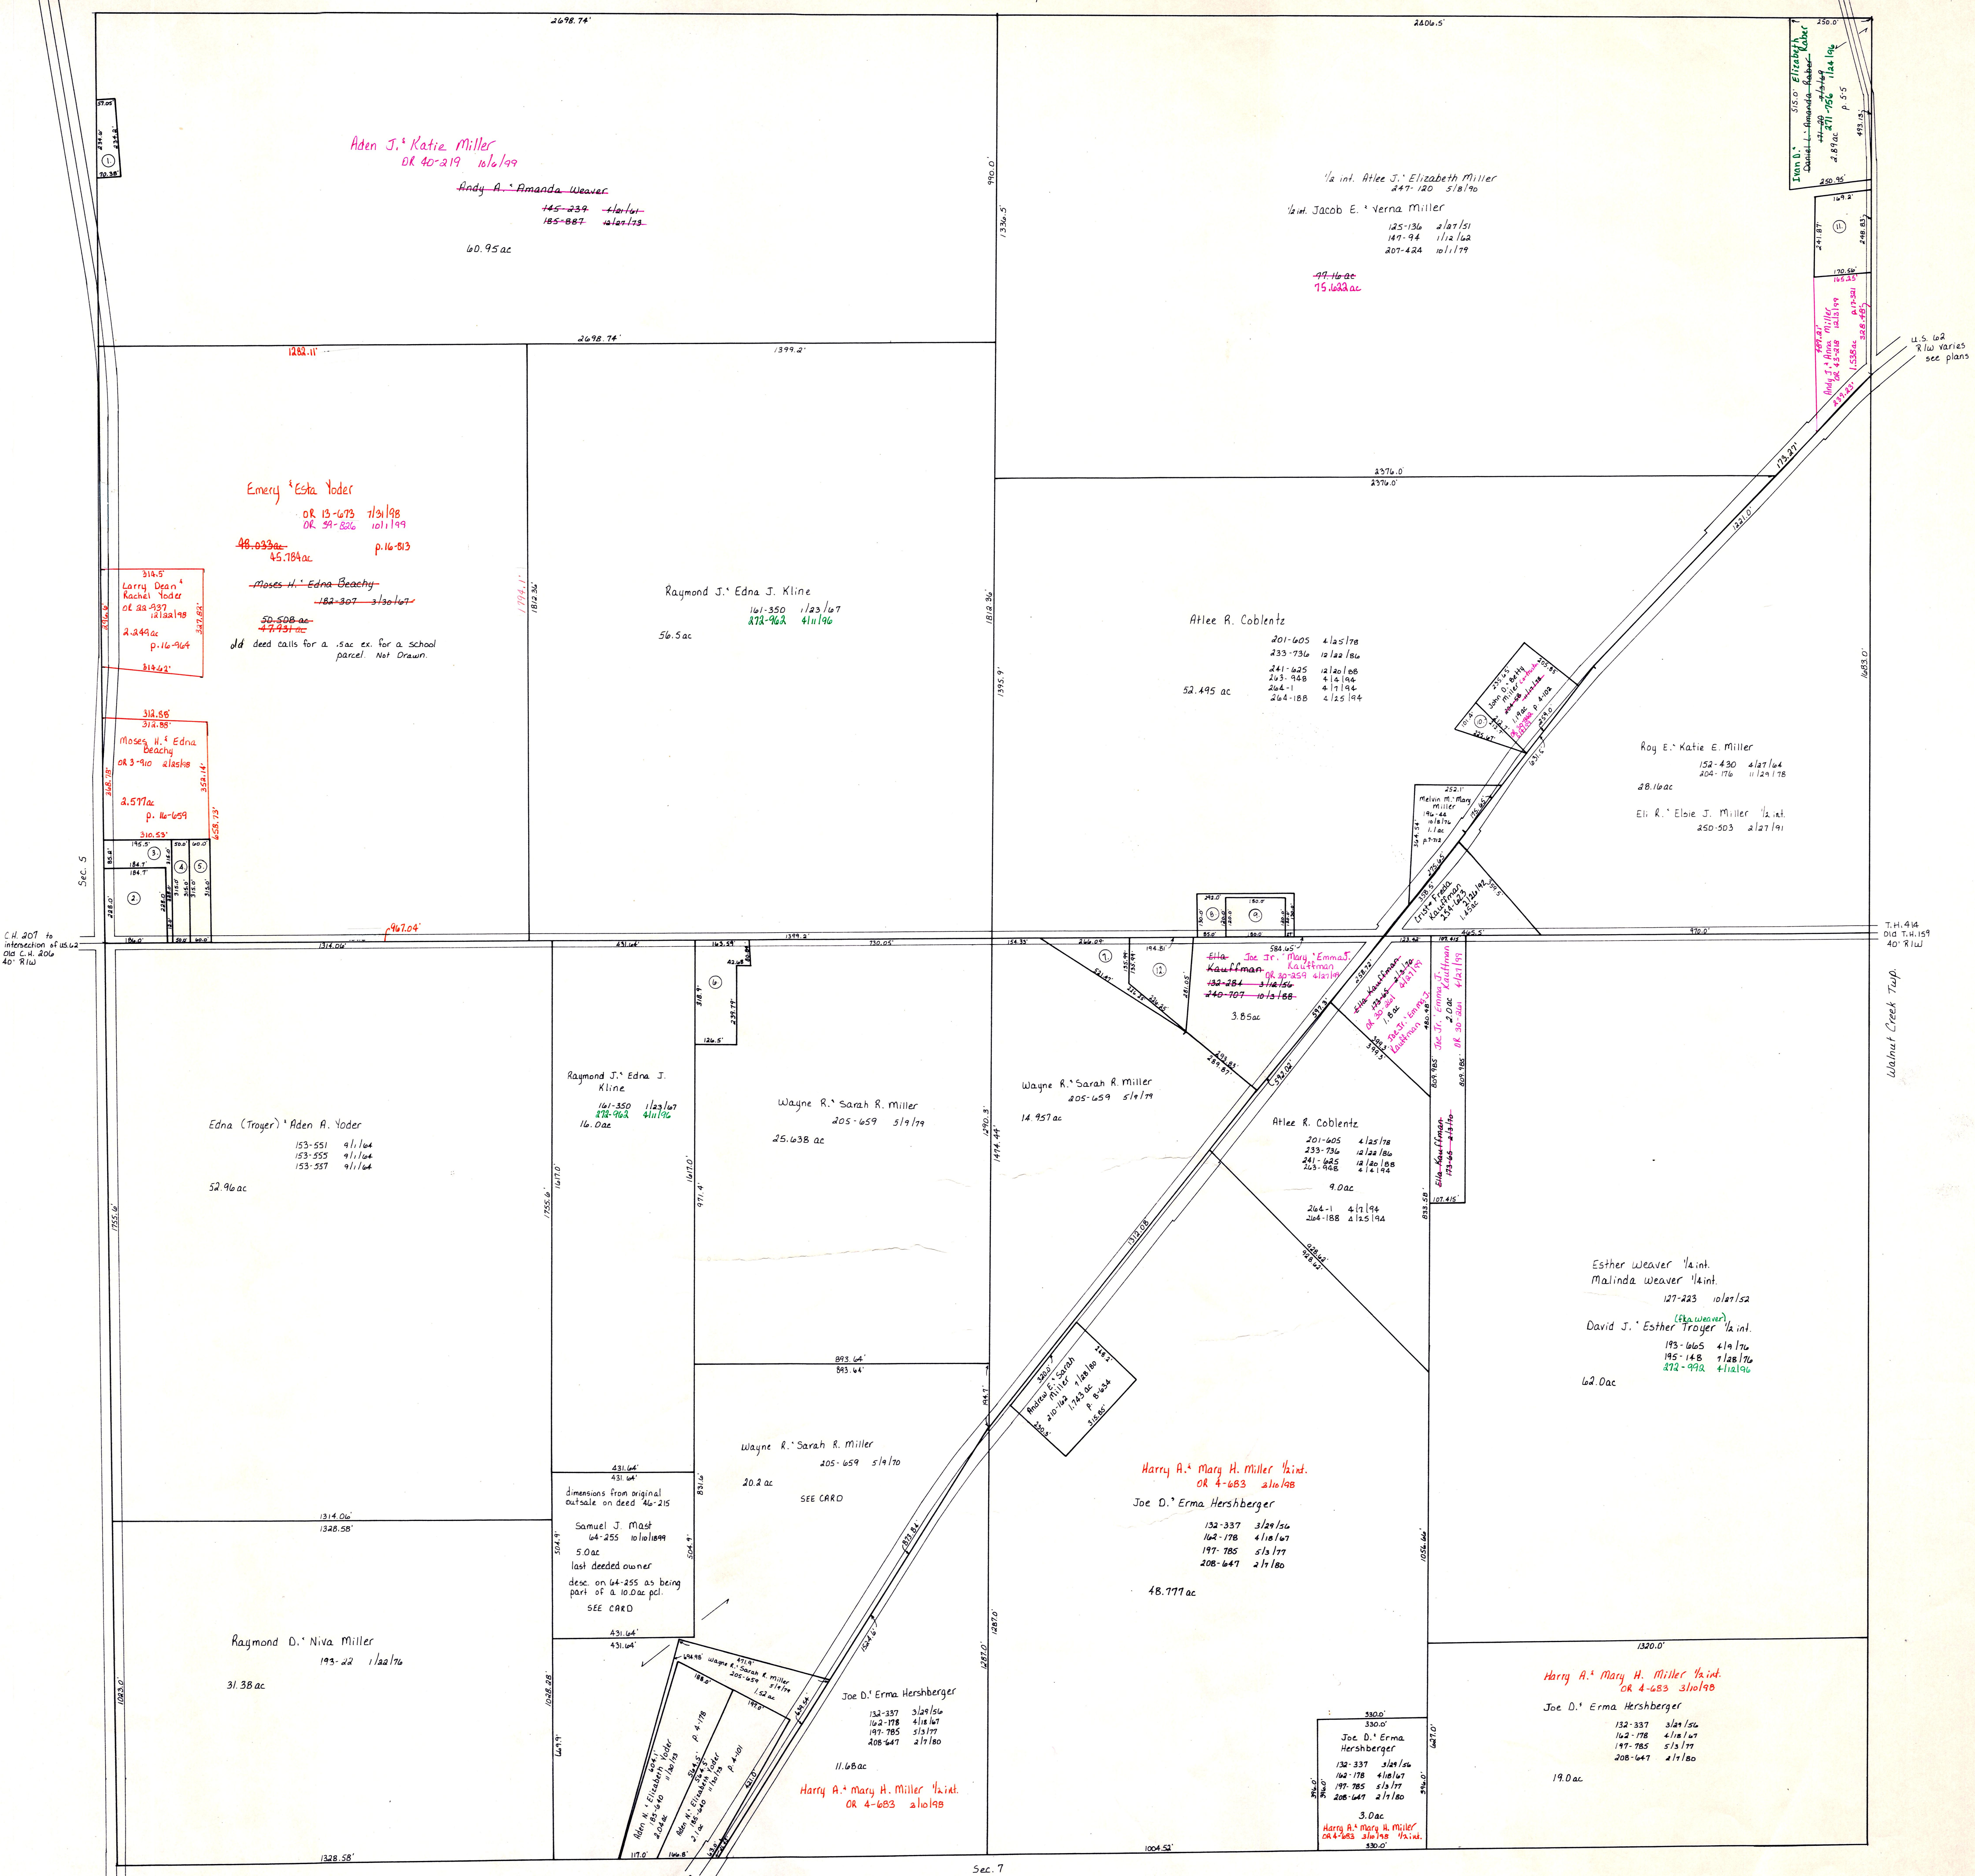

C.H. 207 to  
intersection of U.S. 62  
Old C.H. 206  
40' R/W

T.H. 416  
Old T.H. 151  
40' R/W

Walnut Creek Twp.

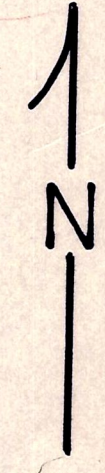

T-9, R-5,  
Sec. 4  
BERLIN TWP.

SCALE: 1" = 200'

LET IT BE KNOWN, THIS MAP HAS BEEN PREPARED AS A REFERENCE GUIDE TO PROPERTY OWNERSHIP. WE BELIEVE THIS INFORMATION TO BE CORRECT AND CURRENT. HOWEVER, IT IS NOT INTENDED FOR ANY LEGAL USE, WHETHER IT BE IN SALES, TRANSFERS, TRADES, LEASES OF ANY TYPE, ETC., AND DO NOT ACCEPT RESPONSIBILITY FOR ERRORS OF ANY NATURE OR OMISSIONS CONTAINED HEREIN.

13-25