


Section 7

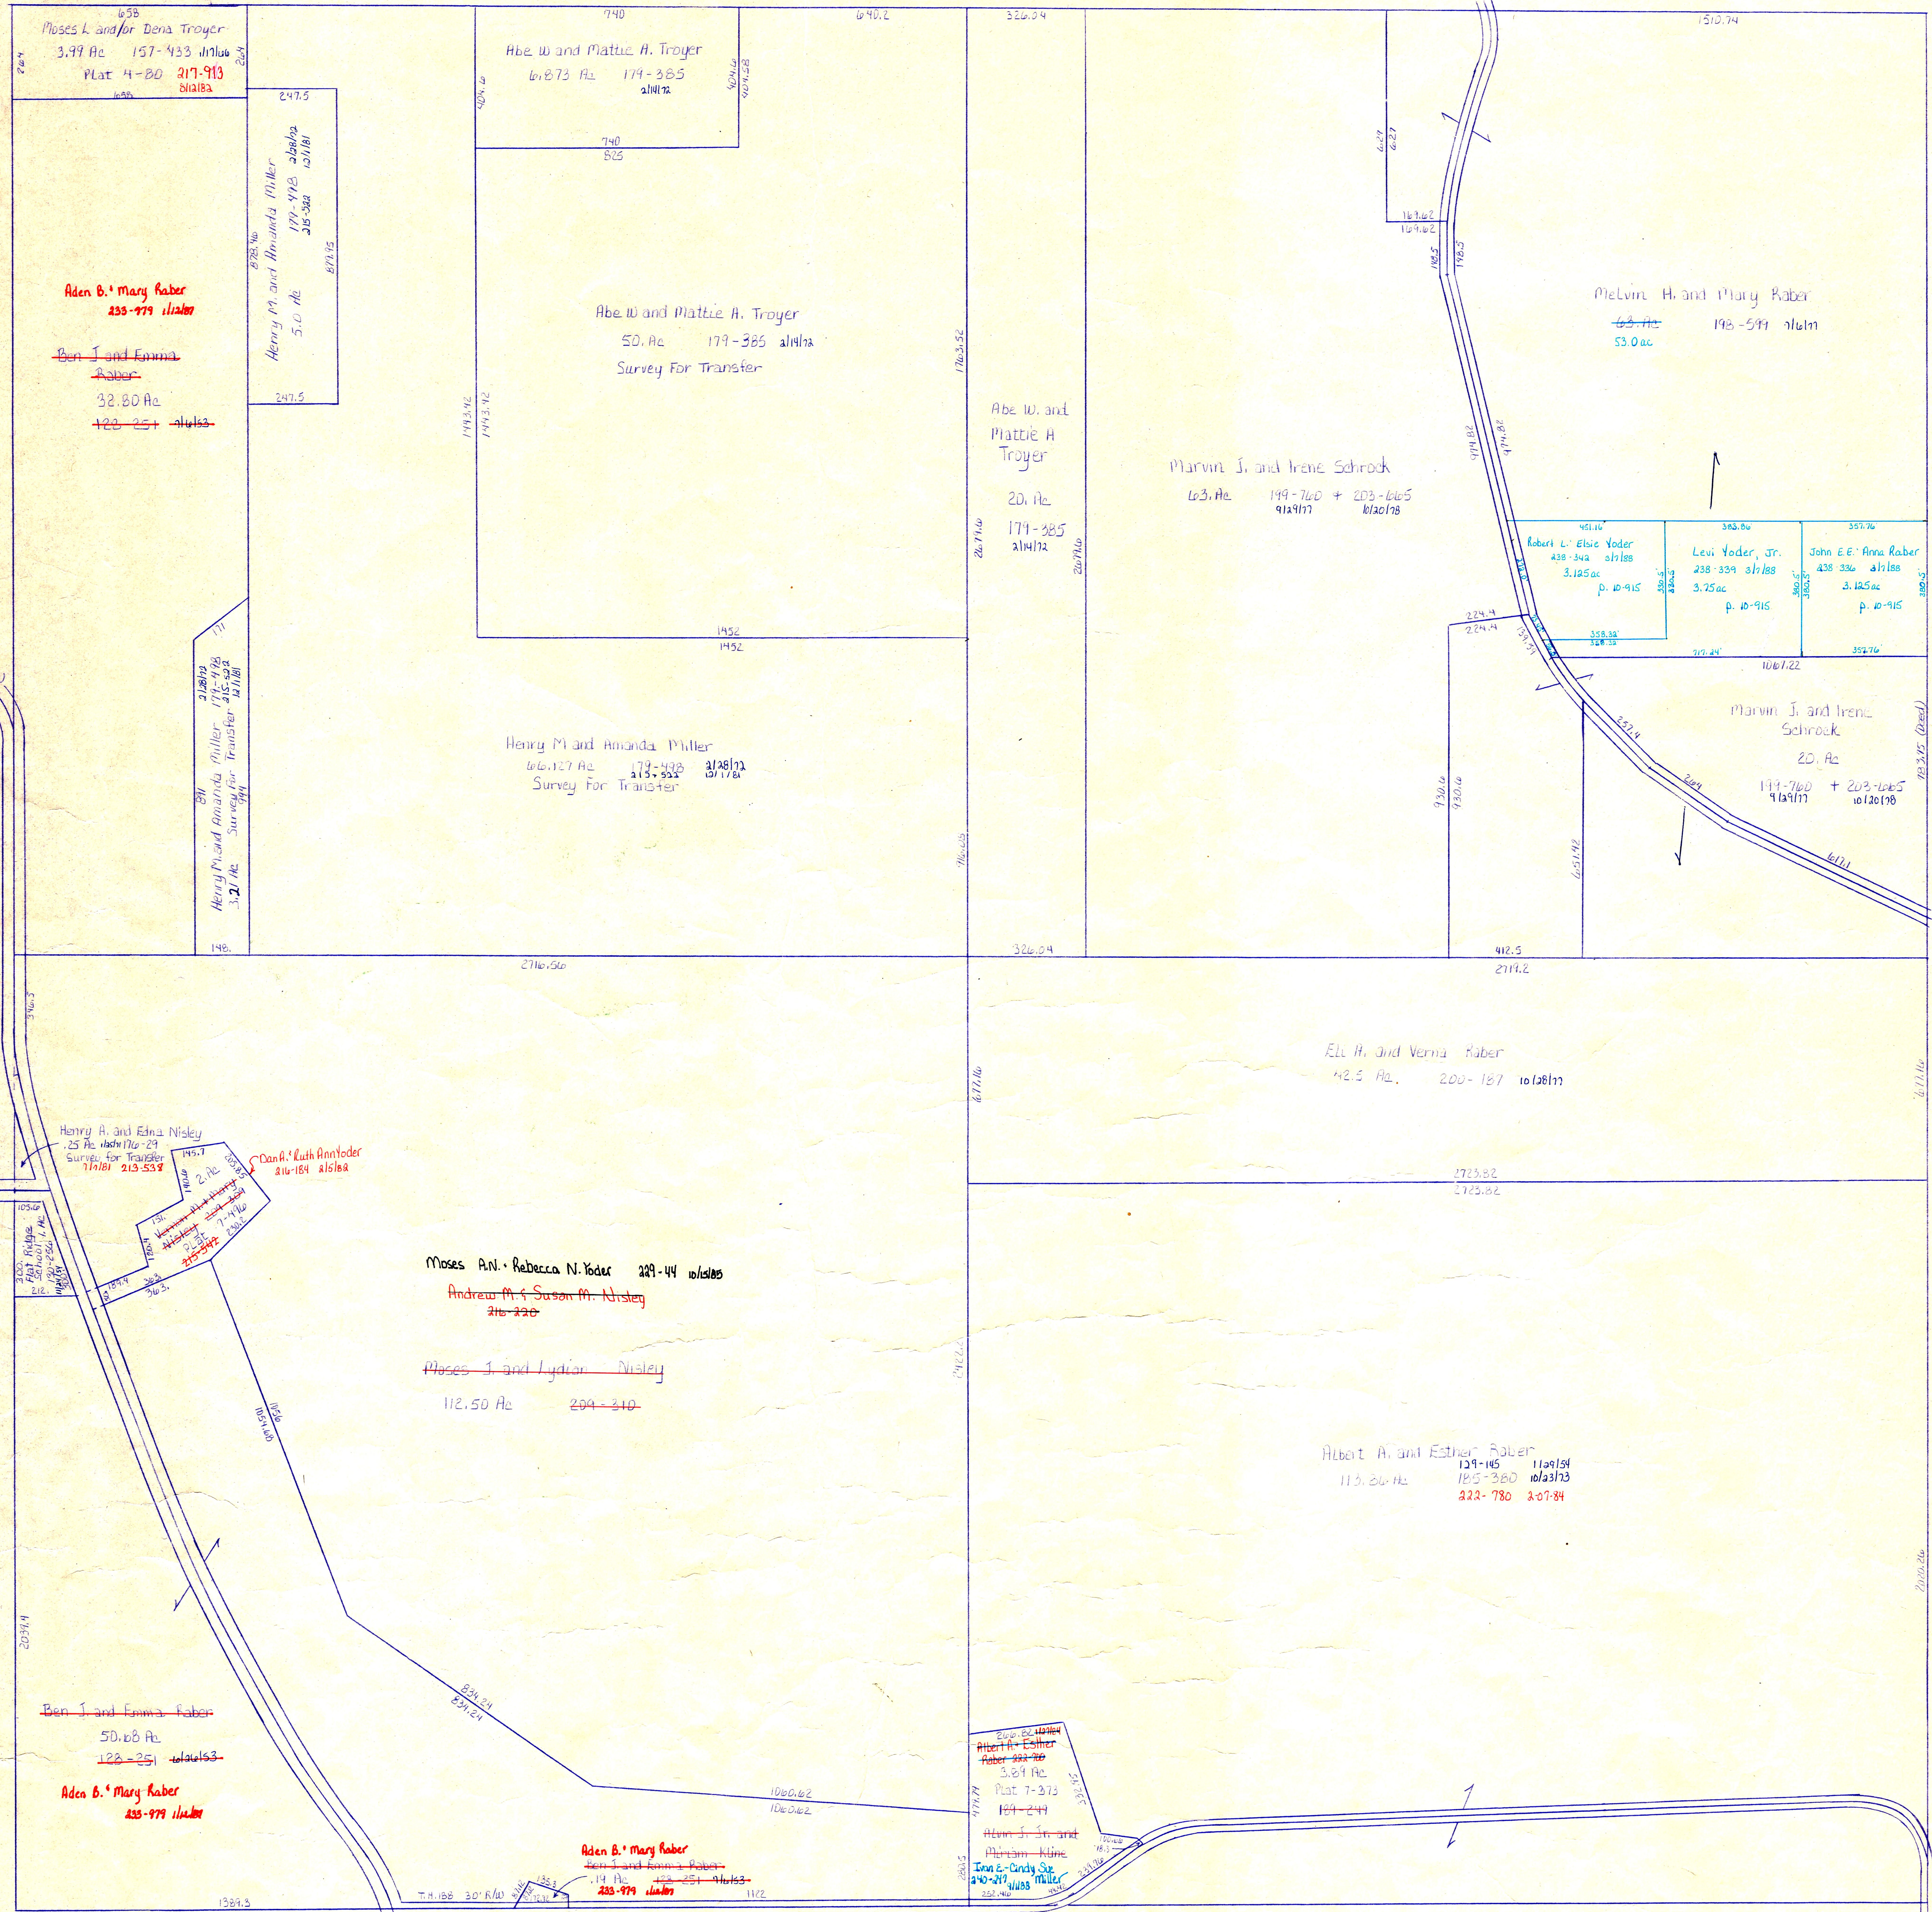

Section 17

T-8, R-5, Sec. 14
CLARK TWP.