


See Revised Map On Mylar

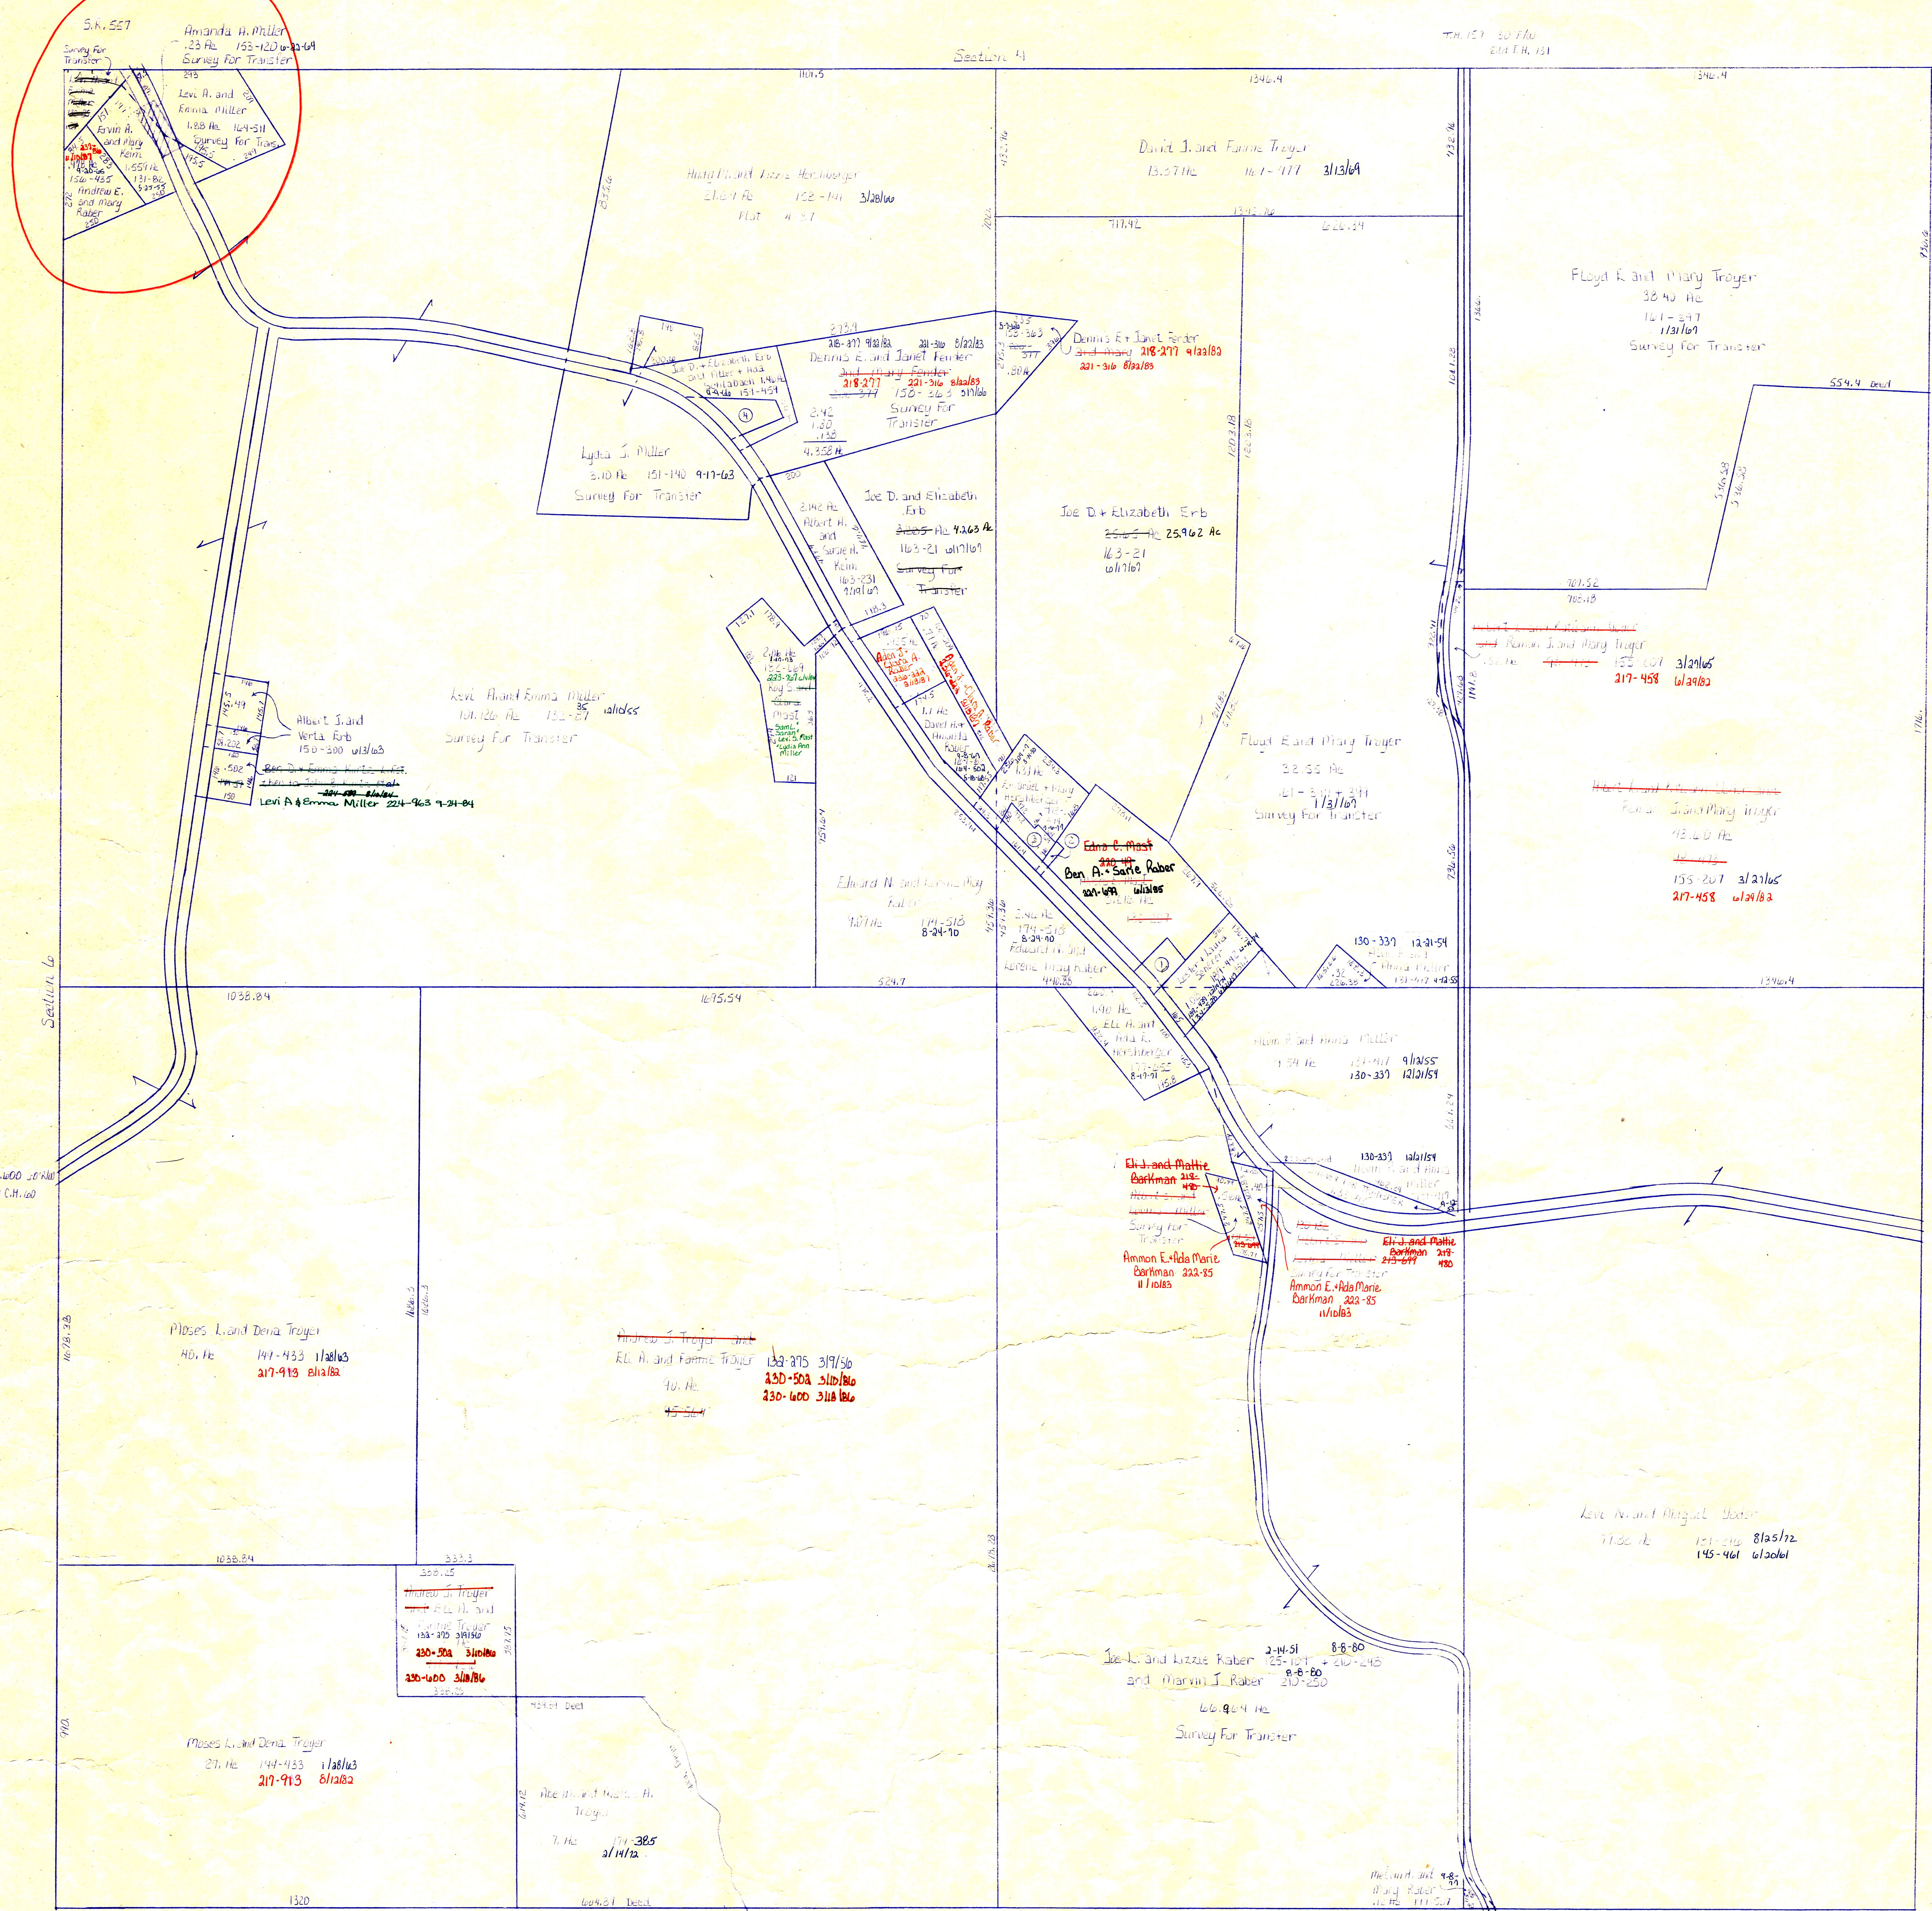

1. 157-200 12/24/64 262
2. 190-597 7/14/64 100
3. 201-7 1/24/64 32
4. 121-516 10/14/62 762

Leaster and Laura Seherer Plat 5-11
 Emanuel E + Mary Herschberger Plat 2-14
 Joe D Erb + Alice + Hans Schlatsch SFT

T.H. 110 35' Rd
 old T.H. 103
T-8. R-5, Sec. 7
CLARK TWP.