


T.H. 188 30' R/W
Old T.H. 118

T.H. 183 30' R/W
Old T.H. 103

T.H. 184 60' R/W
Old T.H. 71

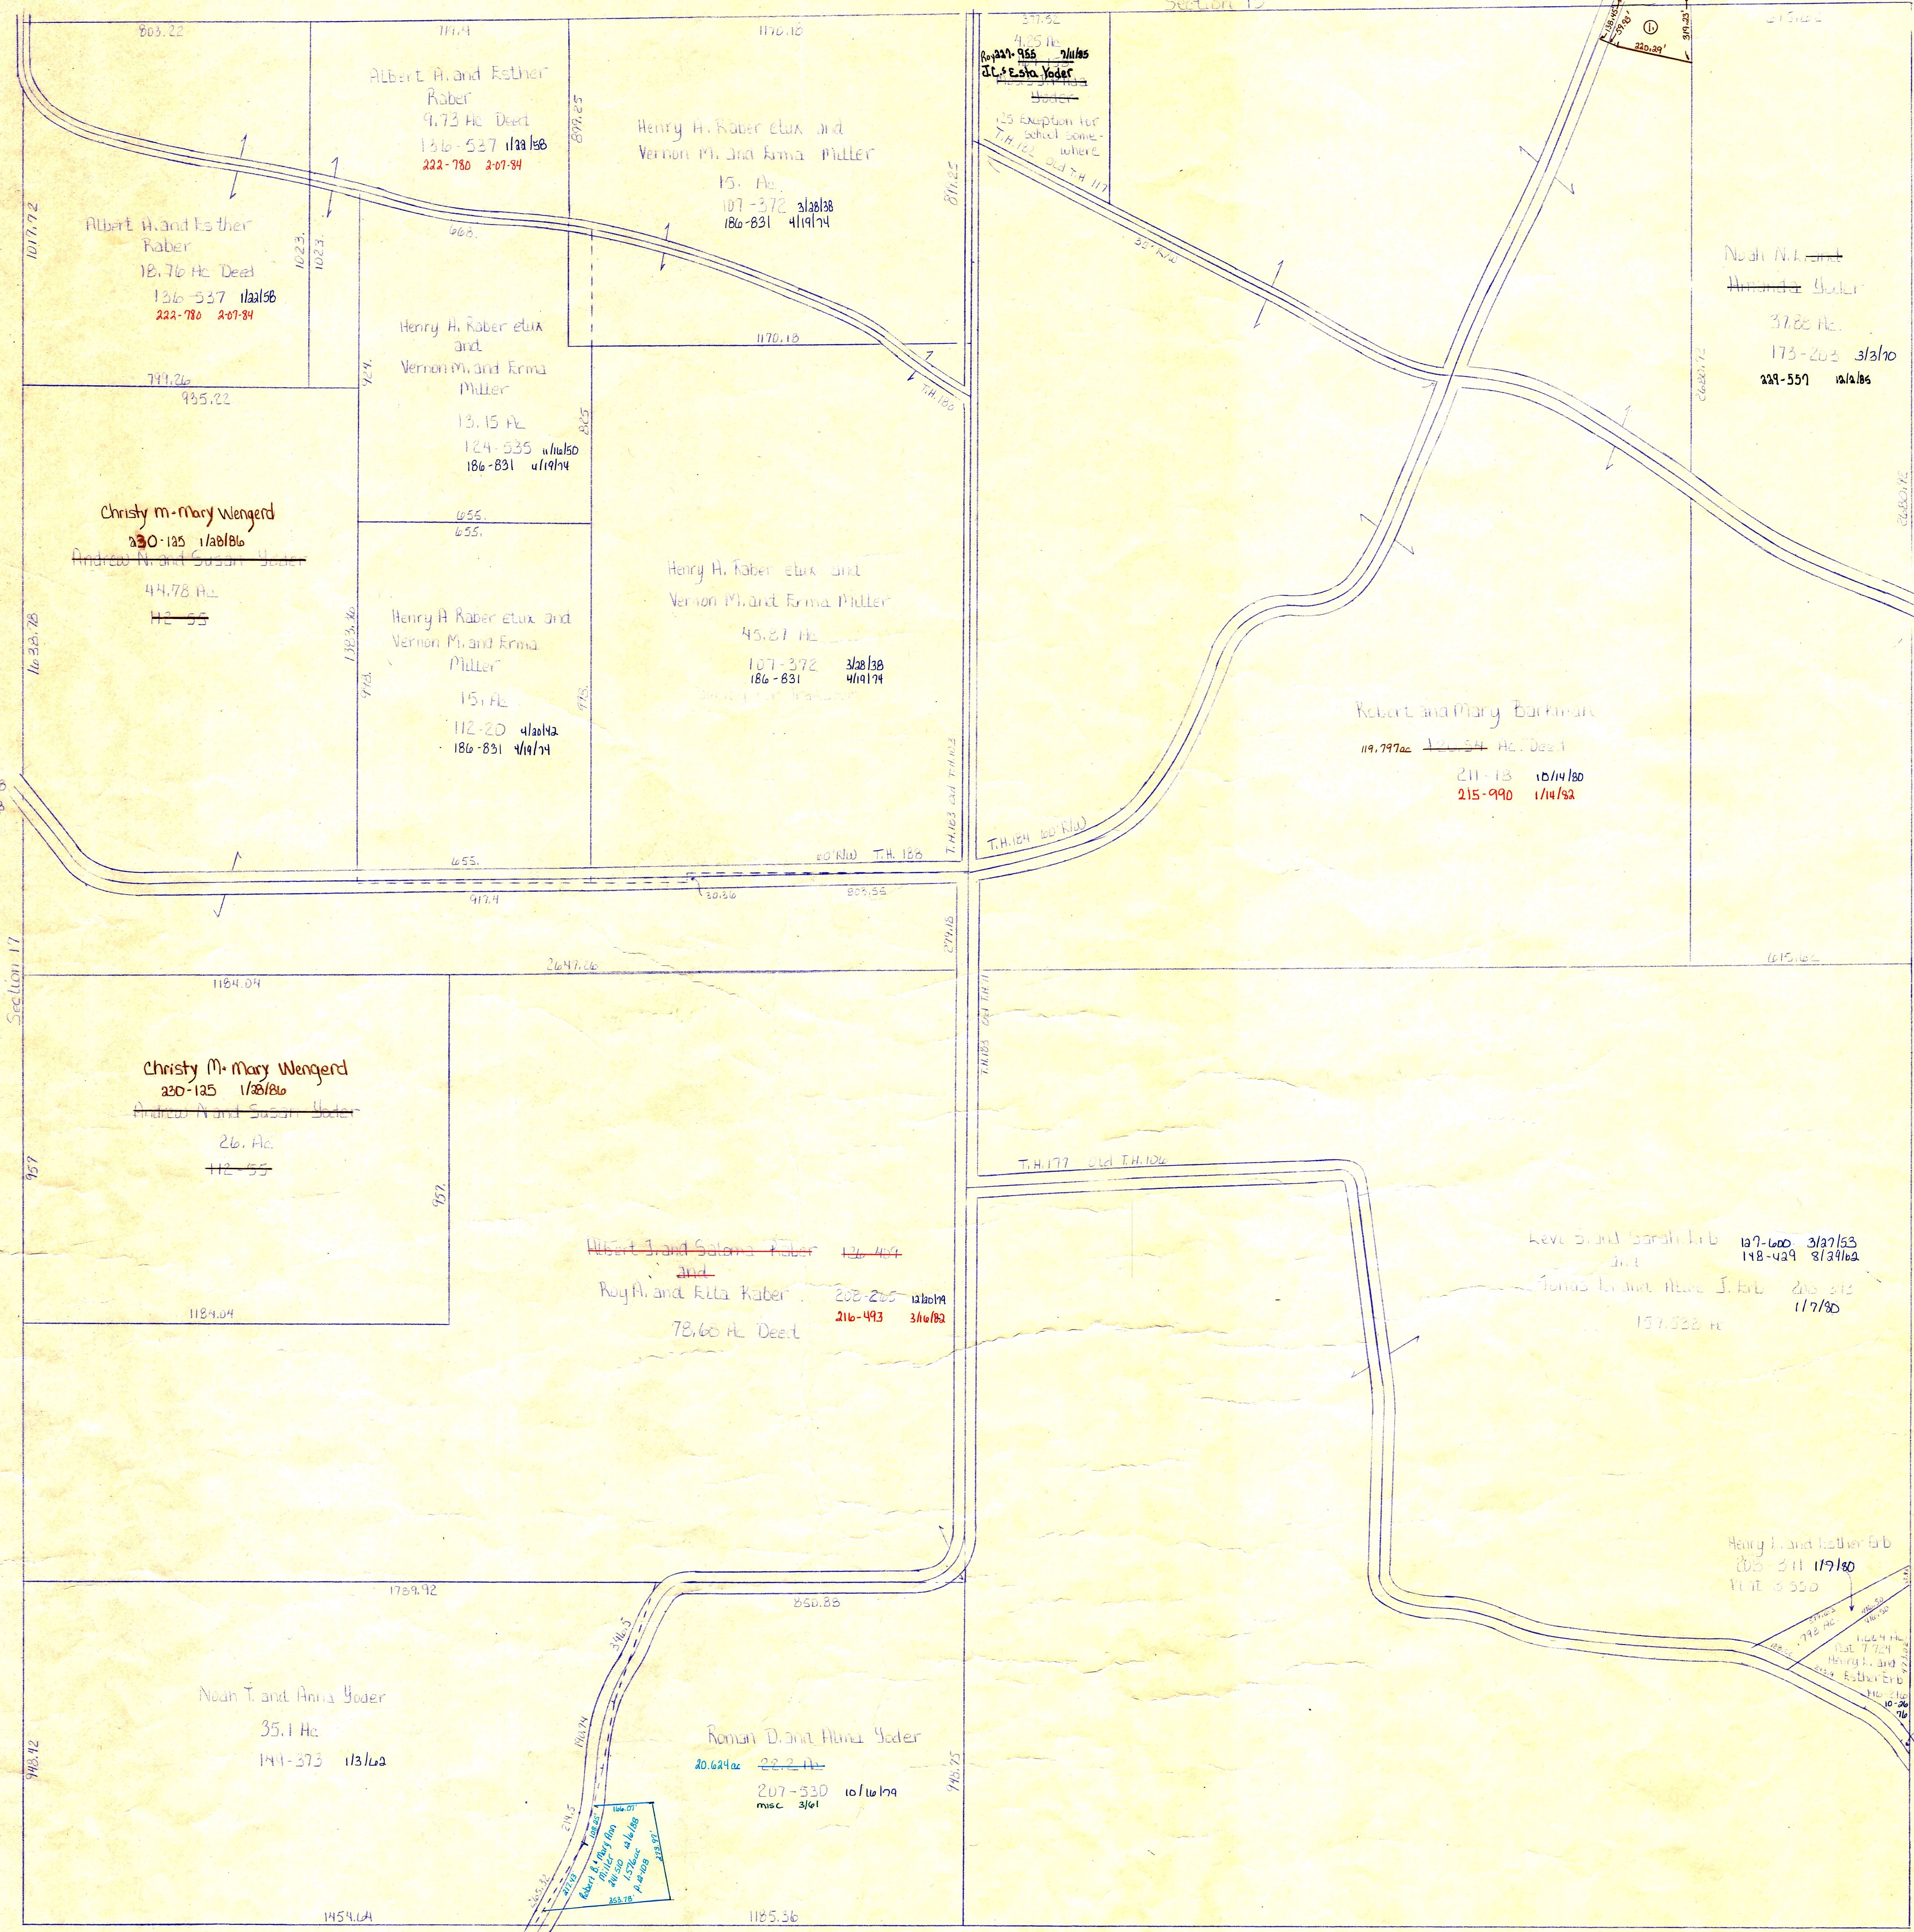

T.H. 185 60' R/W
Old T.H. 71

Section 23

T-8, R-5, Sec. 18
CLARK TWP.

© Albert R. Saloma, Barkman 222-269 915/86, 1993 ac p. 10-603