


FARMERSTOWN

SECTION 12 T-8 R-5
CLARK TWP.
1"=100'

New T.H. 163
Old T.H. 115

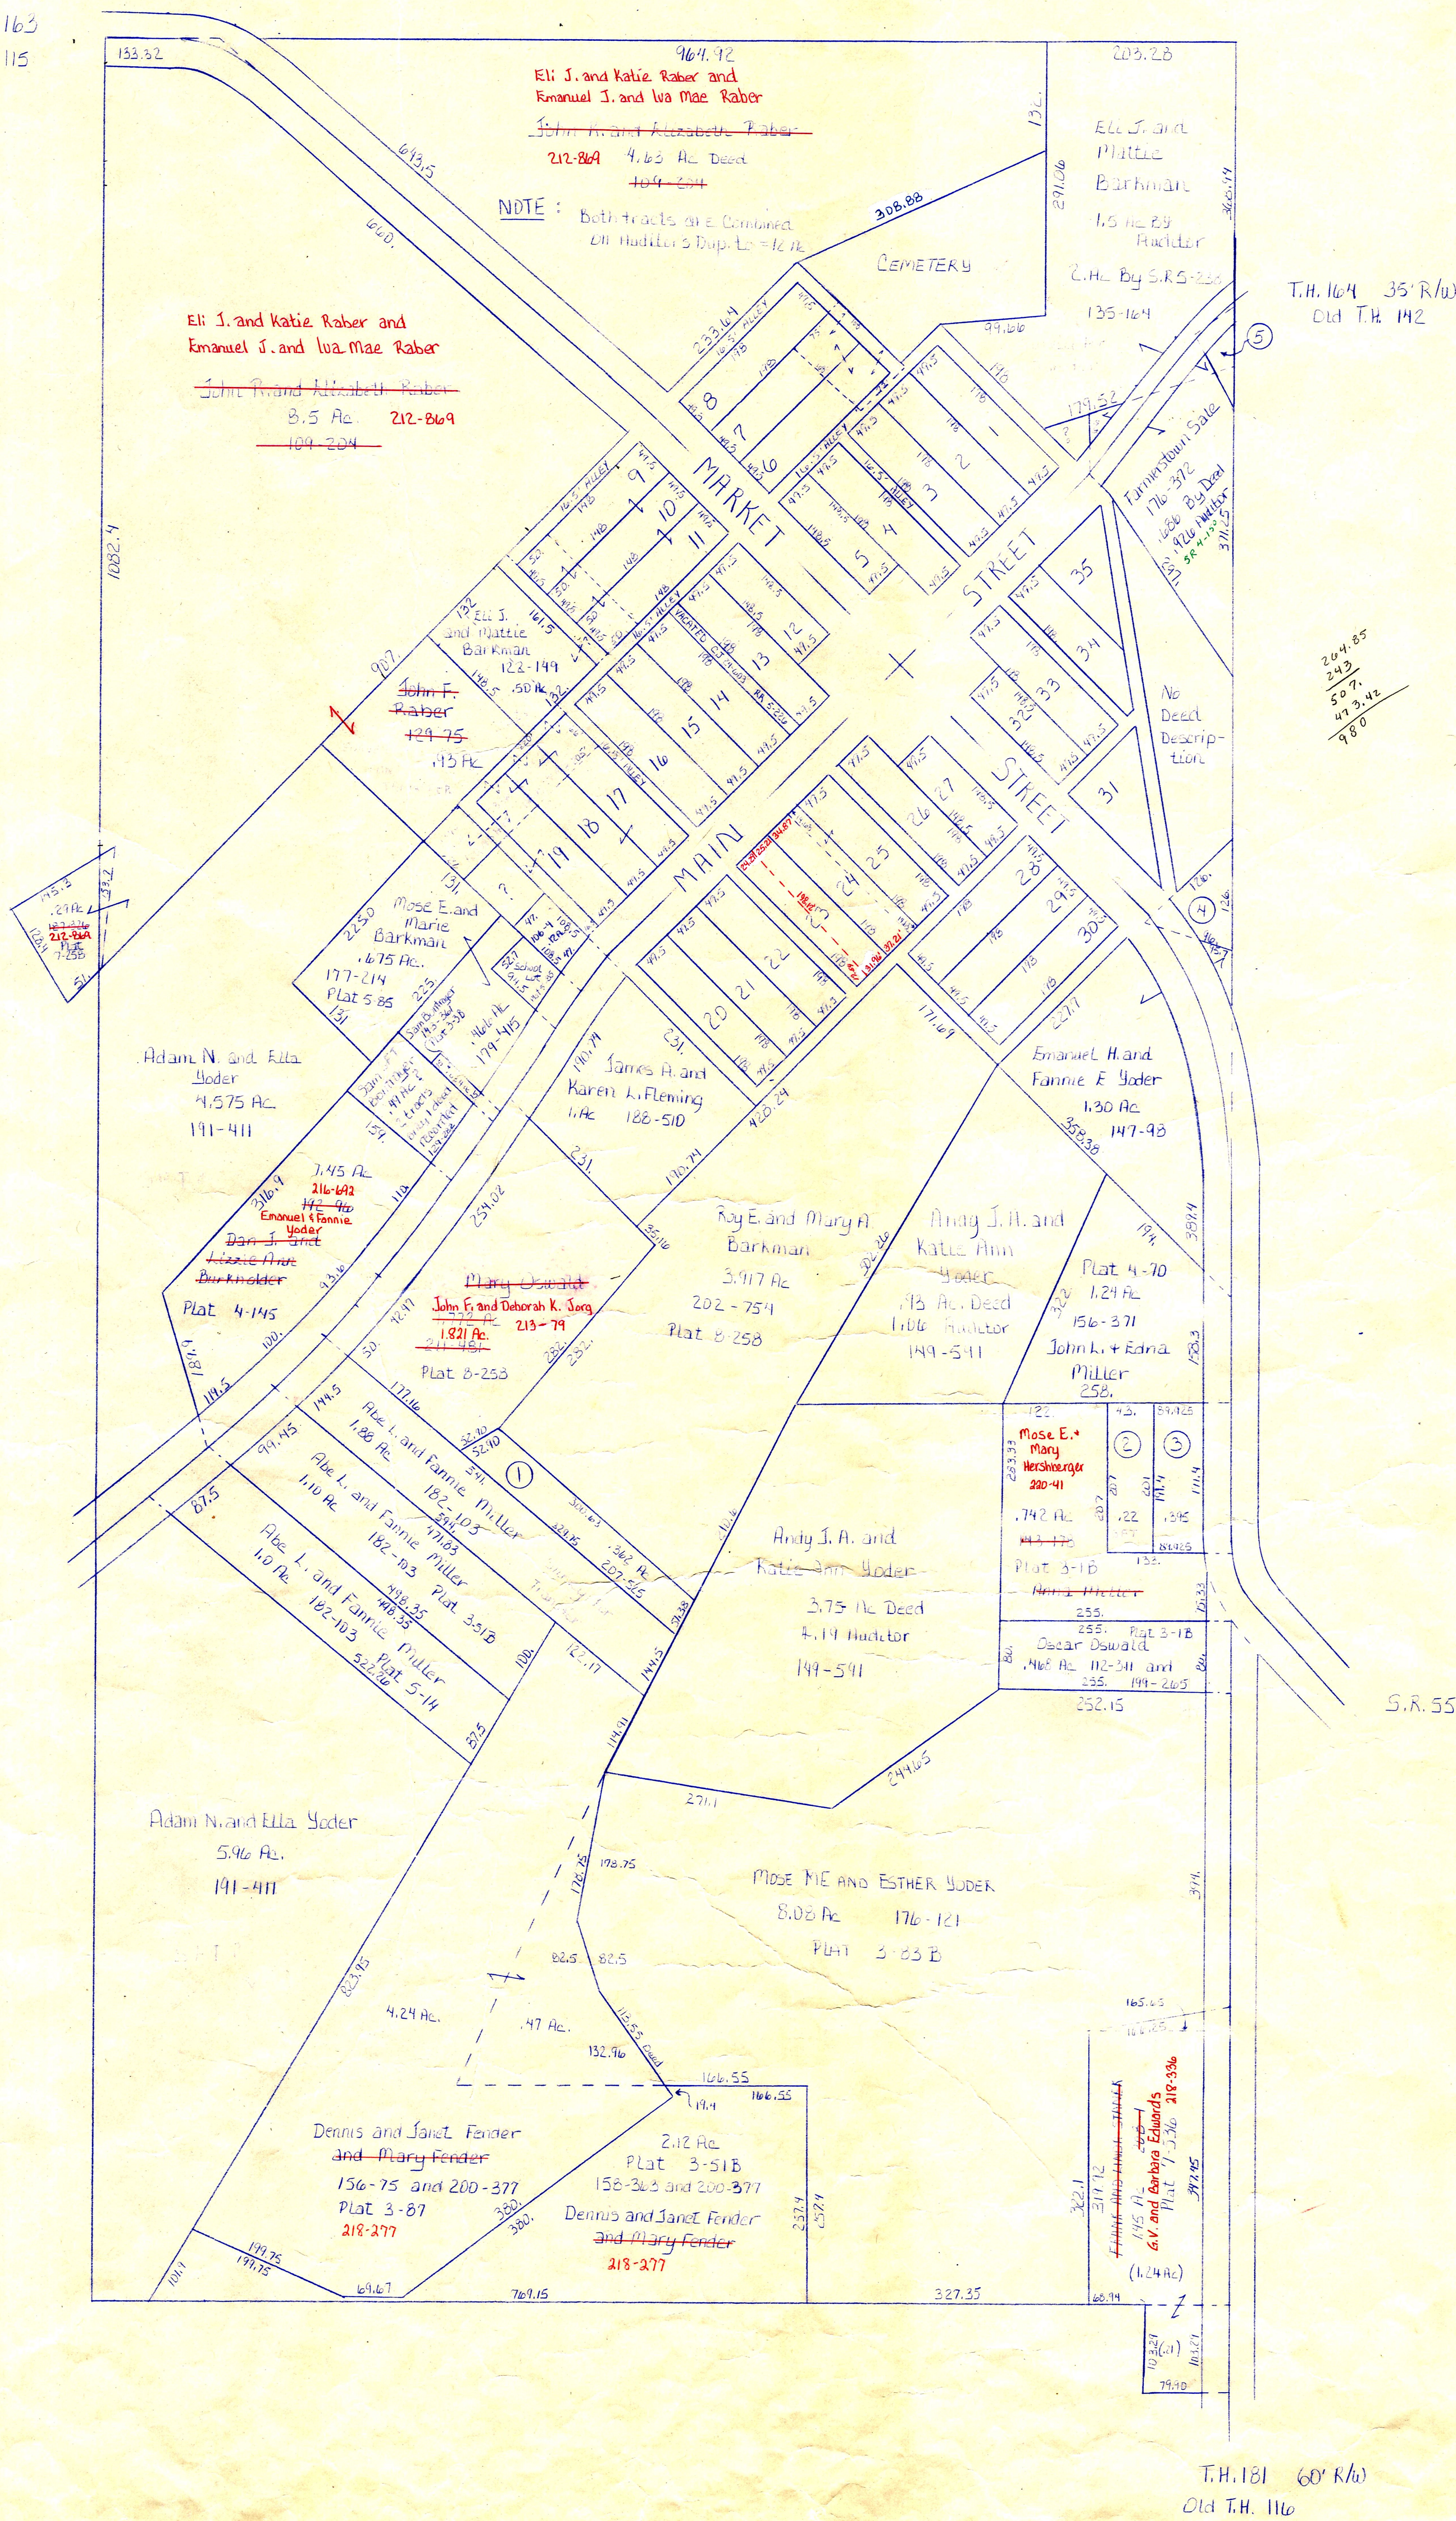

- | | | | | |
|----|------|---------|------------------------|------------|
| 1. | .362 | 207-525 | Abe L. + Fannie Miller | 3-504 Plat |
| 2. | .22 | 216-331 | Gerard + Frances Mast | |
| 3. | .315 | 151-125 | Gerard + Frances Mast | |
| 4. | .13 | 176-372 | Farmerstown Sale | |
| 5. | .074 | 193-560 | Levi M. + Fannie Yoder | 7-589 Plat |

VOID
See Revised Map

FARMERSTOWN
Sec. 12 T-8 R-5
CLARK TWP.